FEE \$ 10.00	BLDG PERMIT NO. 70874
TCP\$ 500.00	
· • •	dential and Accessory Structures) Development Department
BLDG ADDRESS 37812 SUAPWEEDCT	TAX SCHEDULE NO. 2945-201-05-020
SUBDIVISION THE RIDGES	SQ. FT. OF PROPOSED BLDG(S)/ADDITION 2578
FILING BLK 4/12 LOT 20C	SQ. FT. OF EXISTING BLDG(S)
(1) OWNER CARLWS SHERON MITCHELL	NO. OF DWELLING UNITS BEFORE: <u>29</u> — AFTER: <u>1</u> THIS CONSTRUCTION
(1) ADDRESS 511 QUEBECCT FRUITALCU BISZI	
(1) TELEPHONE $970 - 858 - 7350$	NO. OF BLDGS ON PARCEL BEFORE: <u>- •</u> AFTER: <u>1</u> THIS CONSTRUCTION
(2) APPLICANT CARL W& SHERON MITCHEL	
⁽²⁾ ADDRESS <u>511 QUEBEC CT</u> FRUITA, CC, 81521	DESCRIPTION OF WORK AND INTENDED USE:
⁽²⁾ TELEPHONE <u>970-858-7350</u>	RESIDENCE/GARAGE
	g all existing & proposed structure location(s), parking, setbacks to all location & width & all easements & rights-of-way which abut the parcel.
** THIS SECTION TO BE COMPLETED BY	COMMUNITY DEVELOPMENT DEPARTMENT STAFF 🖘
ZONE PR-4	Maximum coverage of lot by structures
SETBACKS: Front 20' from property line (P	L) Parking Req'mt 2
or from center of ROW, whichever is greater	Special Conditions ACCO regid
Side $\underline{10'}$ from PL Rear $\underline{10'}$ from PL Rear	1PL 96

Modifications to this Planning Clearance must be approved, in writing, by the Community Development Department. The structure authorized by this application cannot be occupied until a final inspection has been completed and a Certificate of Occupancy has been issued, if applicable, by the Building Department (Section 305, Uniform Building Code).


CENSUS 1401 TRAFFIC

, ANNX#

Maximum Height

I hereby acknowledge that I have read this application and the information is correct; I agree to comply with any and all codes, ordinances, laws, regulations or restrictions which apply to the project. I understand that failure to comply shall result in legal action, which may include but not necessarily be limited to non-use of the building(s). A

Applicant Signature	cumithel)	Date 2	3 June 1	999
Department Approval	aonie 42	wards	Date	6-24-9	9
Additional water and/or	r sewer tap fee(s) are requi	ired: YES \mathcal{N} NO	W/O No.	12378	
Utility Accounting	Hunn	Male	Date	6/24/99	
VALID FOR SIX MON	THS FROM DATE OF ISSU	JANCE (Section 9-3-2C G	rand Junctic	on Zoning & Developme	ent Code)
(White: Planning)	(Yellow: Customer)	(Pink: Building Depar	tment)	(Goldenrod: Utility A	Accounting)

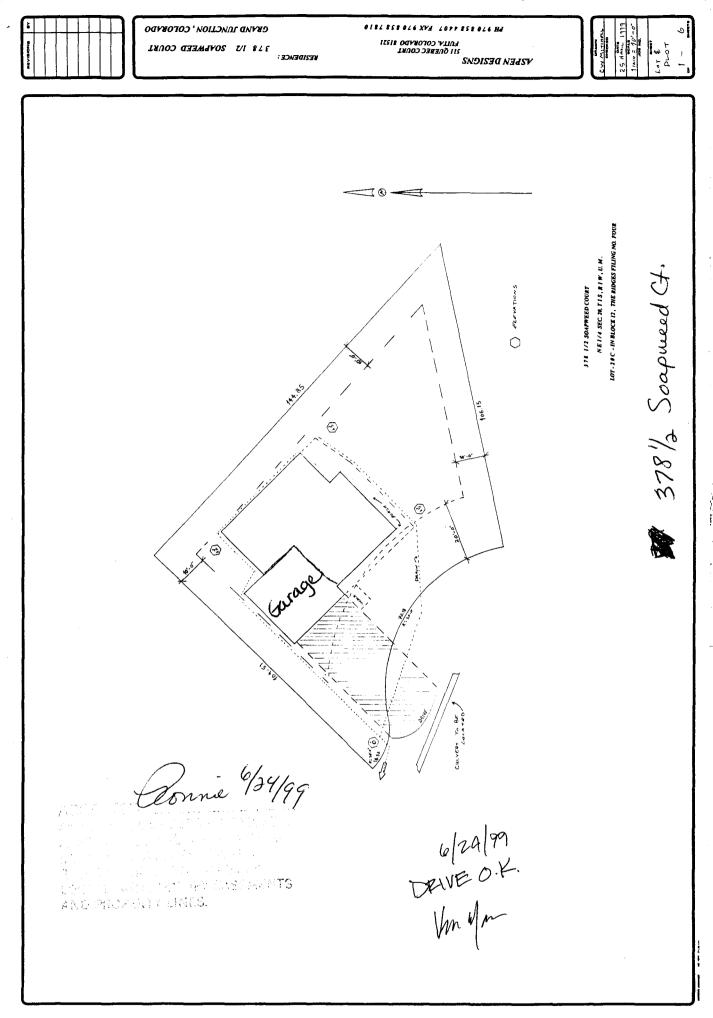

▲ ÁPPROVAL FOR BUILDING PERMIT < Aidges Architectural Control Committee (ACCO)	JOB NO. Builder or <u>Homeowner</u> CARL & SHERON MITCHELL
	Ridges Filing No4 Block_12Lot20 C
A - Approved NA - Not Approved	Pages Submitted Date Submitted APRIC 1999

SITE	PLAN
	a marara

6

A	NA	· · ·
		Front setback (20'-0" minimum) YES- SHOWN ON SITE PLAN
		Rear sathack (10'-0" minimum)
Ū		Side setbacks (10-0" minimum "B" and "C" lots) YES SHOWN ON SITE PLAN
a		Square Footage 135 FLOOR 11364 # 2~2 649 1 TOTAL 2,013
		Sidewalks SMALL - PORCH TO DRIVE
	D	Driveway (asphalt or concrete) $CONCRETE$
		Drainang SHOWN ON SITE PLAN
ú	Ū	Landscaping GRASS/TREES - MATIVE -

NOTE: Driveway shall be constructed of asphalt or concrete and shall extend to street paving with a 12" minimum drainage pipe extended 2'-0" minimum each side of driveway.

NOTE: All drainage shall be directed away from the foundation and disposed of without flowing onto adjacent lots.

NOTE: Water meter and irrigation riser must not be disturbed without permission of Ridges Metropolitan District.

EXTERIOR ELEVATIONS

		Height (25'0" maximum) SHOW AN ELEVATION PLAN
ā		Roof-Material LAMINATED FIBER GEASS Color MINTEN DESERT TONES
	D	Trim Color OX BLOOD / DUST BOWL by BEHR -OR SIMILAR
		Siding Material HARDI PLANK LAP SIDING COLOR NAVAJO MAUUE
		Material OR SIMILIAR COLOR by BEHR OR SIMULAR
		Brick - Color
		Stone · Color
		Balcony
	Ο	Porches or patios CONCRETE
		Other

NOTE: All exposed flashing and metal shall be painted so as to blend into adjecent material.

APPROVED SUBJECT TO:

NOTE: Sewer, radon, and water permits must be obtained prior to issuance of building permit.

NOTE: ACCO makes no judgement on foundation design.

By signature below, builder or owner guarantees that improvements will be constructed as shown on this form and on building plans that were submitted, including plot plan, landscaping, and drainage plan.

RIDGES ural Control Committee Builder/Realtor Homeowner By ______ chilec By vor By_ By 26 AP+17 1999 Date