

FEE \$	10.-
TCP \$	0
SIF \$	292.-

PLANNING CLEARANCE
(Single Family Residential and Accessory Structures)
Community Development Department

New Home
BLDG PERMIT NO. 74386



Your Bridge to a Better Community

BLDG ADDRESS 650 30 Rd SQ. FT. OF PROPOSED BLDGS/ADDITION 1369
 TAX SCHEDULE NO. 2943-042-56-011 SQ. FT. OF EXISTING BLDGS 0
 SUBDIVISION Faircloud TOTAL SQ. FT. OF EXISTING & PROPOSED 1369
 FILING 1 BLK 1 LOT 11 NO. OF DWELLING UNITS:
 Before: 0 After: 1 this Construction
 (1) OWNER Grand Ridge Properties NO. OF BUILDINGS ON PARCEL
 Before: 0 After: 1 this Construction
 (1) ADDRESS 3032 E-70 Bus Loop USE OF EXISTING BUILDINGS N/A
 (1) TELEPHONE 434-4616 DESCRIPTION OF WORK & INTENDED USE Single Family Home
 (2) APPLICANT Great Services TYPE OF HOME PROPOSED:
 (2) ADDRESS 3032 E-70 E-70 Loop Site Built Manufactured Home (UBC)
 (2) TELEPHONE 434-4616 Manufactured Home (HUD)
 Other (please specify) _____

REQUIRED: One plot plan, on 8 1/2" x 11" paper, showing all existing & proposed structure location(s), parking, setbacks to all property lines, ingress/egress to the property, driveway location & width & all easements & rights-of-way which abut the parcel.

THIS SECTION TO BE COMPLETED BY COMMUNITY DEVELOPMENT DEPARTMENT STAFF

ZONE PR-3.4 Maximum coverage of lot by structures 35%
 SETBACKS: Front 23' from property line (PL) Permanent Foundation Required: YES _____ NO _____
 or _____ from center of ROW, whichever is greater
 Side 5' from PL, Rear 25' from PL Parking Req'mt 2
 Maximum Height 32' Special Conditions _____
 CENSUS 11 TRAFFIC ~~30~~ 40 ANN# _____

Modifications to this Planning Clearance must be approved, in writing, by the Community Development Department. The structure authorized by this application cannot be occupied until a final inspection has been completed and a Certificate of Occupancy has been issued, if applicable, by the Building Department (Section 305, Uniform Building Code).

I hereby acknowledge that I have read this application and the information is correct; I agree to comply with any and all codes, ordinances, laws, regulations or restrictions which apply to the project. I understand that failure to comply shall result in legal action, which may include but not necessarily be limited to non-use of the building(s).

Applicant Signature [Signature] Date 3-16-00
 Department Approval [Signature] Date 3-29-00

Additional water and/or sewer tap fees(s) are required: <input checked="" type="checkbox"/> YES <input type="checkbox"/> NO	W/O No <u>2976</u>
Utility Accounting <u>[Signature]</u>	Date _____

VALID FOR SIX MONTHS FROM DATE OF ISSUANCE (Section 9-3-2C Grand Junction Zoning & Development Code)
 (White: Planning) (Yellow: Customer) (Pink: Building Department) (Goldenrod: Utility Accounting)


650 30 ROAD

ACCEPTED SUD 3-29-00
ANY CHANGE OF SETBACKS MUST BE APPROVED BY THE CITY PLANNING DEPT. IT IS THE APPLICANT'S RESPONSIBILITY TO PROPERLY LOCATE AND IDENTIFY EASEMENTS AND PROPERTY LINES.

DRIVE OK AS MODIFIED
END ML
3/29/00



14' MULTI-PURPOSE EASEMENT

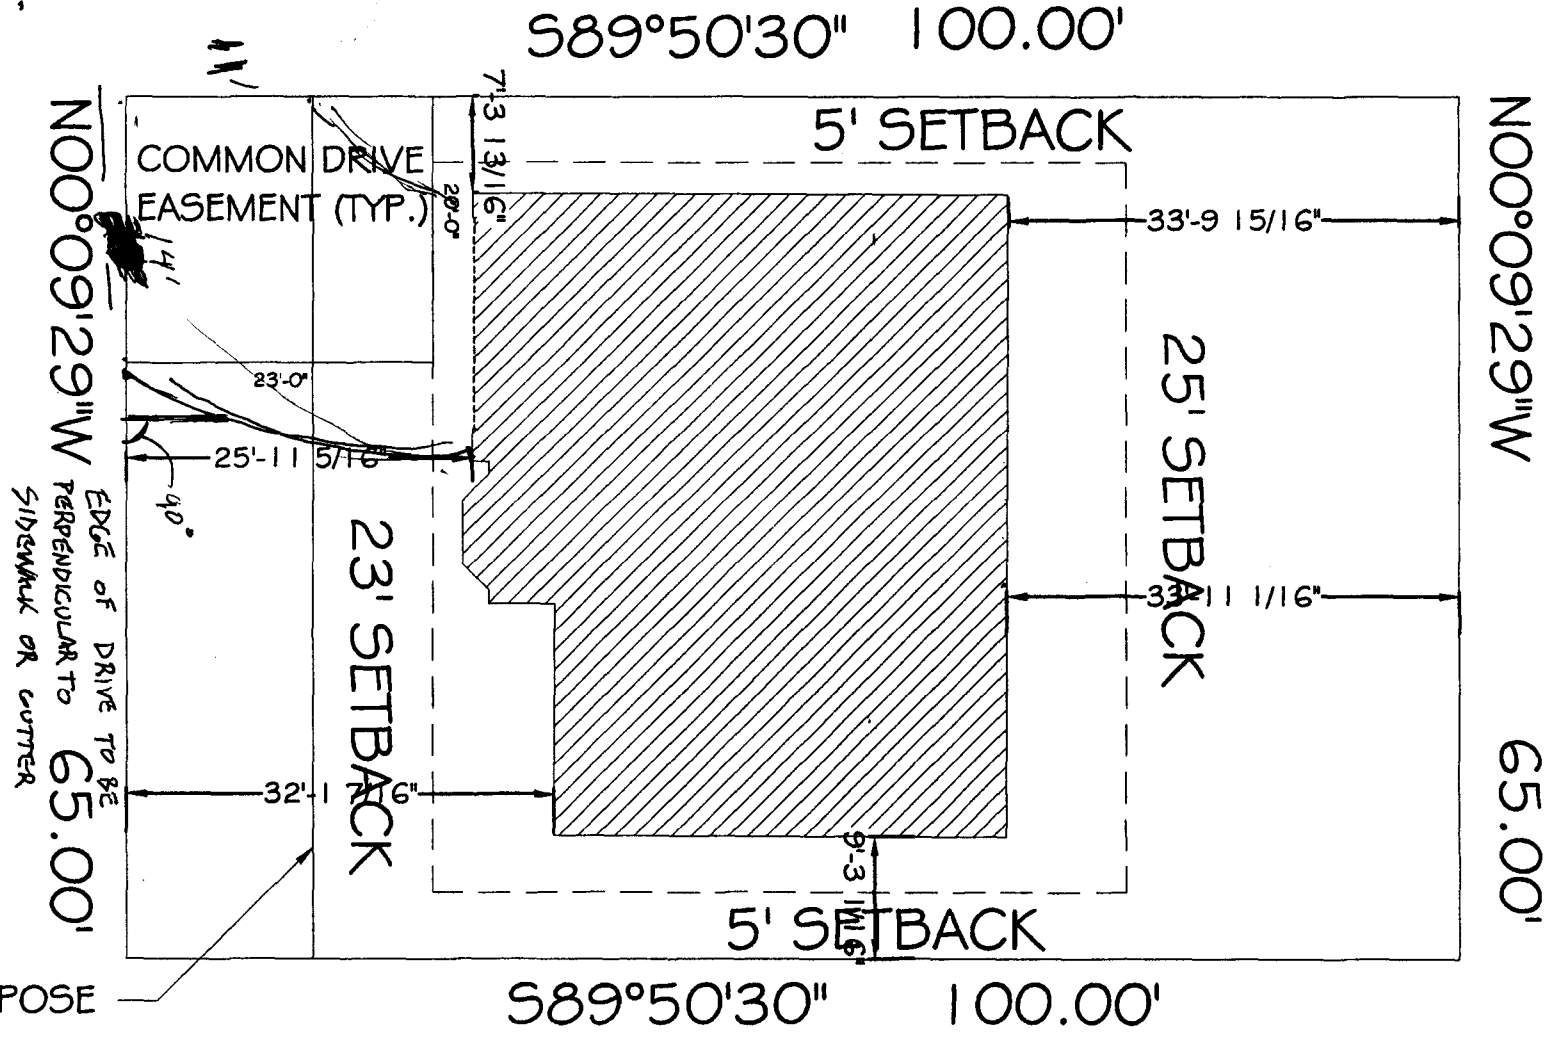

WILLOW, LT
LOT 3, BLK 1
650 30 ROAD