

Planning \$ <u>5-</u>	Drainage \$
TCP \$	School Impact \$

BLDG PERMIT NO. <u>75922</u>
FILE #

PLANNING CLEARANCE
(multifamily and non-residential remodels and change of use)
Grand Junction Community Development Department

EX

THIS SECTION TO BE COMPLETED BY APPLICANT

BUILDING ADDRESS 1803 N 7th
SUBDIVISION _____
FILING _____ BLK _____ LOT _____
OWNER Western Co Center for Arts
ADDRESS 1803 N 7th
TELEPHONE _____
APPLICANT Centennial Coast
ADDRESS 1520 Plummer Ct N
TELEPHONE 242-7198

TAX SCHEDULE NO. 2945-114-00-998
CURRENT FAIR MARKET VALUE OF STRUCTURE \$ 600,170
ESTIMATED REMODELING COST \$ 8000.00
NO. OF DWELLING UNITS: BEFORE _____ AFTER _____
CONSTRUCTION
USE OF ALL EXISTING BLDGS Commercial
DESCRIPTION OF WORK & INTENDED USE: Tutorias remodel

✓ Submittal requirements are outlined in the SSID (Submittal Standards for Improvements and Development) document.

THIS SECTION TO BE COMPLETED BY COMMUNITY DEVELOPMENT DEPARTMENT STAFF

ZONE R-O SPECIAL CONDITIONS: interior only
PARKING REQUIREMENT: no change
LANDSCAPING/SCREENING REQUIRED: YES _____ NO CENSUS TRACT 4 TRAFFIC ZONE 34 ANNEX _____

Modifications to this Planning Clearance must be approved, in writing, by the Community Development Department Director. The structure authorized by this application cannot be occupied until a final inspection has been completed and a Certificate of Occupancy has been issued by the Building Department (Section 307, Uniform Building Code). Required improvements in the public right-of-way must be guaranteed prior to issuance of a Planning Clearance. All other required site improvements must be completed or guaranteed prior to issuance of a Certificate of Occupancy. Any landscaping required by this permit shall be maintained in an acceptable and healthy condition. The replacement of any vegetation materials that die or are in an unhealthy condition is required by the Grand Junction Zoning and Development Code.

I hereby acknowledge that I have read this application and the information is correct; I agree to comply with any and all codes, ordinances, laws, regulations, or restrictions that apply to the project. I understand that failure to comply shall result in legal action, which may include but not necessarily be limited to non-use of the building(s).


Applicant's Signature [Signature] Date 7-12-00
Department Approval [Signature] Date 7-12-00

Additional water and/or sewer tap fee(s) are required:	YES	NO <input checked="" type="checkbox"/>	W/O No. <u>No chg in use</u>
Utility Accounting	<u>Marshall Cole</u>		Date <u>7/12/00</u>

VALID FOR SIX MONTHS FROM DATE OF ISSUANCE (Section 9-3-2C Grand Junction Zoning and Development Code)

- (White: Planning) (Yellow: Customer) (Pink: Building Department) (Goldenrod: Utility Accounting)

CENTENNIAL CONSTRUCTION
JULY 10, 2000
PROJECT: ART CENTER 1803 N 7TH
SCH.# 2945-114-00-998

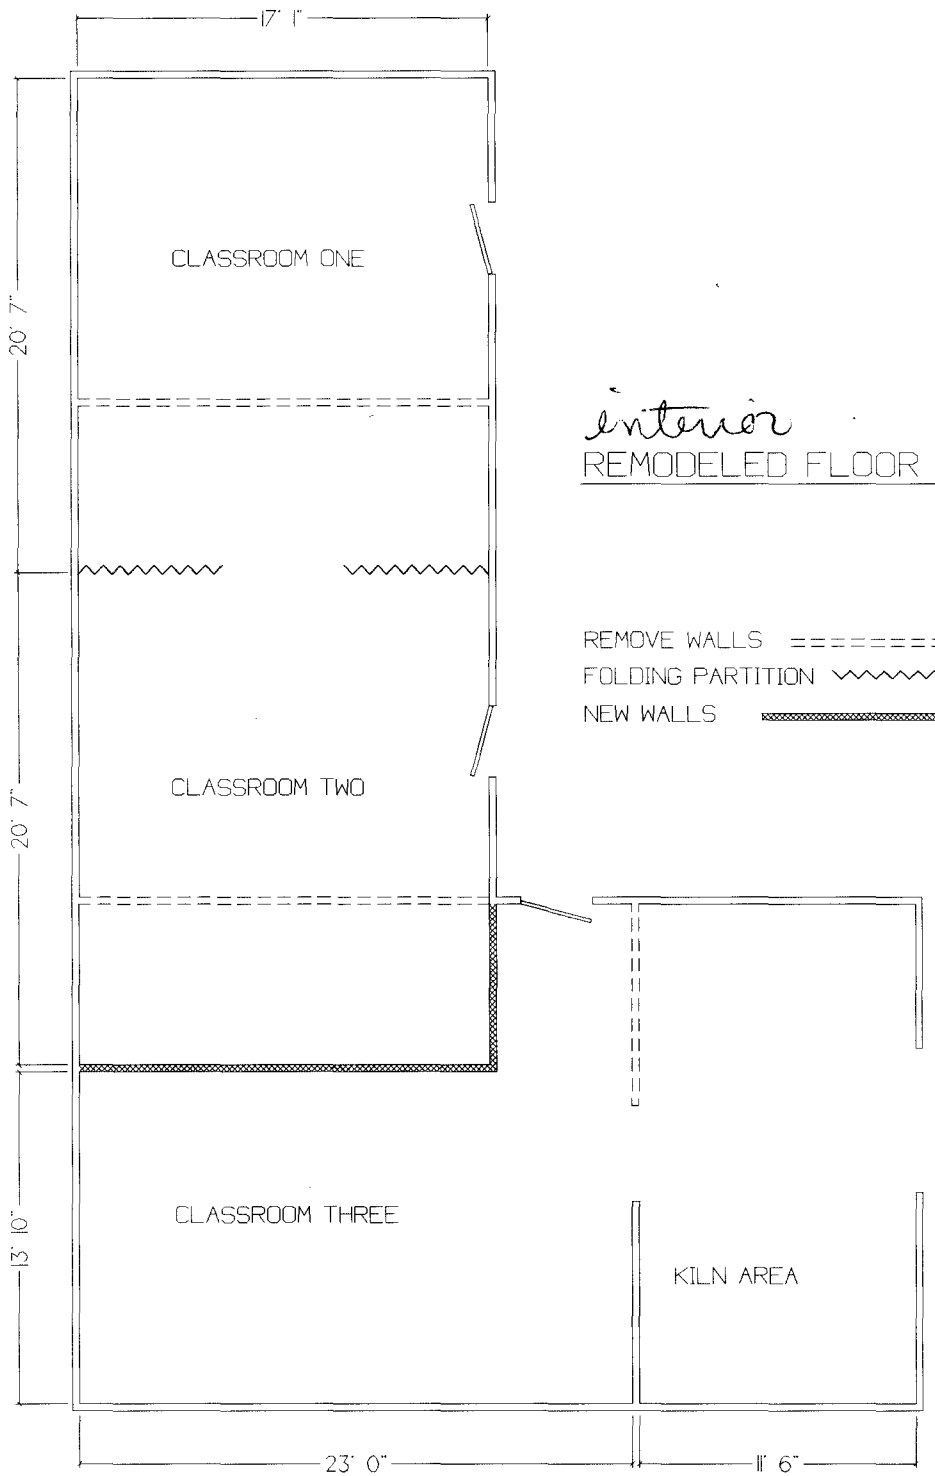

interior
REMODELED FLOOR PLAN

SCALE 1/8" = 1'

- REMOVE WALLS -----
- FOLDING PARTITION ~~~~~
- NEW WALLS [hatched line]