FEE \$	10.00
TCP\$	500.00
CIE ¢	

(White: Planning)

(Yellow: Customer)

PLANNING CLEARANCE

BLDG PERMIT NO.

(Single Family Residential and Accessory Structures) **Community Development Department**




(Goldenrod: Utility Accounting)

	Your Bridge to a Better Community	
BLDG ADDRESS 2676 Canbridge	SQ. FT. OF PROPOSED BLDGS/ADDITION 1820	
TAX SCHEDULE NO. 2701-351-40-015	SQ. FT. OF EXISTING BLDGSO ~	
SUBDIVISION Carebridge	TOTAL SQ. FT. OF EXISTING & PROPOSED 1820	
FILING BLK LOT	NO. OF DWELLING UNITS:	
OWNER Costle Rock Const	Before: After: this Construction NO. OF BUILDINGS ON PARCEL	
(1) ADDRESS <u>Box 1533</u>	Before: After: this Construction	
(1) TELEPHONE 444-0188	USE OF EXISTING BUILDINGS RASIDONCE	
(2) APPLICANT Same	DESCRIPTION OF WORK & INTENDED USE COMMON STATEMENT OF WORK & INTENDED USE	
(2) ADDRESS	TYPE OF HOME PROPOSED:	
	Manufactured Home (HUD)	
(2) TELEPHONE	Other (please specify)	
REQUIRED: One plot plan, on 8 ½" x 11" paper, showing all existing & proposed structure location(s), parking, setbacks to all property lines, ingress/egress to the property, driveway location & width & all easements & rights-of-way which abut the parcel.		
property mise, mg. coolegises to the property; and only to	dation a madra an edocinento a ngino-et way innon abat are pareet.	
138 THIS SECTION TO BE COMPLETED BY C	OMMUNITY DEVELOPMENT DEPARTMENT STAFF 🖘	
ZONE DN		
ZONE PD	Maximum coverage of lot by structures	
SETBACKS: Front 20 from property line (PL) or from center of ROW, whichever is greater	Permanent Foundation Required: YESNO	
Side 5 from PL, Rear 10 from F	Parking Req'mt	
	Special Conditions	
Maximum Height	CENSUS TRAFFIC ANNX#	
Modifications to this Planning Clearance must be approved, in writing, by the Community Development Department. The structure authorized by this application cannot be occupied until a final inspection has been completed and a Certificate of Occupancy has been issued, if applicable, by the Building Department (Section 305, Uniform Building Code).		
I hereby acknowledge that I have read this application and the information is correct; I agree to comply with any and all codes, ordinances, laws, regulations or restrictions which apply to the project. I understand that failure to comply shall result in legal action, which may include but not necessarily be limited to non-use of the building(s).		
Applicant Signature Alexander Date 1-30-00		
Department Approval C 4 dupl Date		
Additional water and/or sewer tap fee(s) are required:	(YES) NO W/O No. 13578	
Utility Accounting Seuspools	Date 11-30-00	
VALID FOR SIX MONTHS FROM DATE OF ISSUANCE	E (Section 9-3-2C Grand Junction Zoning & Development Code)	

(Pink: Building Department)

HOUSE SITE PLAN LOT 15 BLOCK 1

CAMBRIDGE SUBDIVISION 2676 CAMBRIDGE STREET JUNCTION, MESA COUNTY, COLORADO GRAND

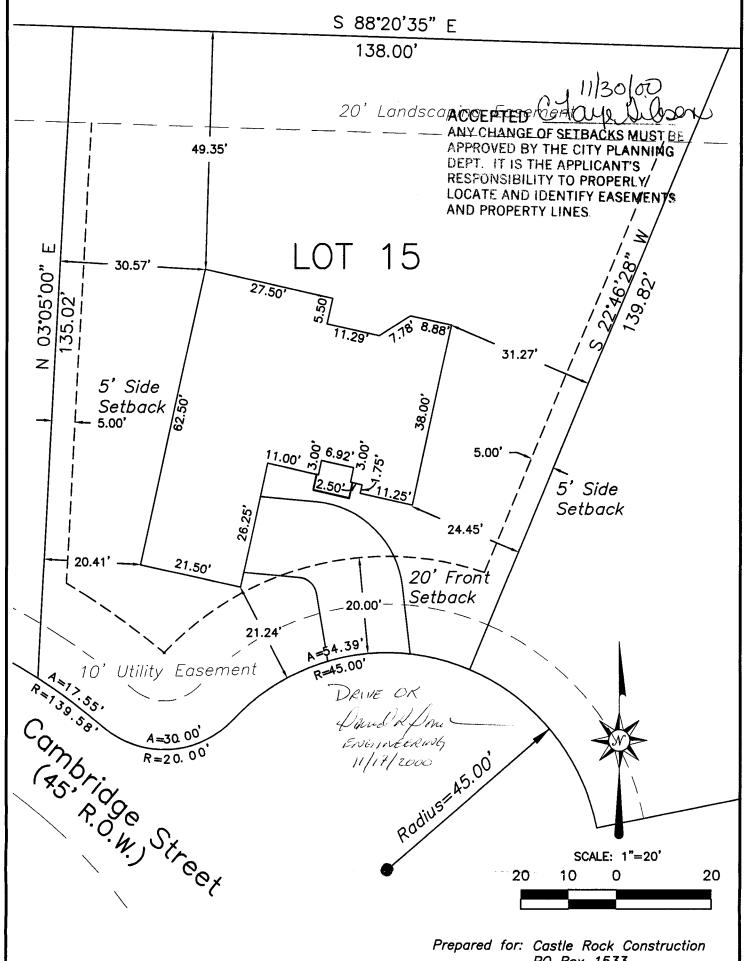

Prepared for: Castle Rock Construction PO Box 1533 Palisade, CO 81526

1) Boundary and easement information taken from the recorded plat of Cambridge Subdivision, Plat Book 13, Pages 174 & 175. Other documents may exist that would affect this property.

2) This site plan is not a land survey plat and does not represent a title search by LANDesign.
3) Building setback information provided by the Grand Junction Community Development Department.

HOUSE SITE PLAN

LOT 15 BLOCK 1 CAMBRIDGE SUBDIVISION 2676 CAMBRIDGE STREET GRAND JUNCTION, MESA COUNTY, COLORADO

LANDesign

ENGINEERS × SURVEYORS × 259 GRAND AVENUE GRAND JUNCTION, COLORADO 81501 (970) 245-PROJECT NO. SURVEYED DRAWN CHECKED