

FEE \$	10
TCP \$	500
SIF \$	292

PLANNING CLEARANCE
 (Single Family Residential and Accessory Structures)
Community Development Department

BLDG PERMIT NO. 76211



Your Bridge to a Better Community

BLDG ADDRESS 3115 ~~3114~~ D³/₄ CT SQ. FT. OF PROPOSED BLDGS/ADDITION 1110

TAX SCHEDULE NO. 2943-152-070-004 SQ. FT. OF EXISTING BLDGS 0

SUBDIVISION Summit View TOTAL SQ. FT. OF EXISTING & PROPOSED 1110

FILING 2 BLK 3 LOT ~~12~~ 13 NO. OF DWELLING UNITS:
 Before: 0 After: 1 this Construction

(1) OWNER Zeck & Assoc, LLC NO. OF BUILDINGS ON PARCEL
 Before: 0 After: 1 this Construction

(1) ADDRESS PO Box 1083 Grand Junction CO 81502 USE OF EXISTING BUILDINGS 0

(1) TELEPHONE 970-252-9483 DESCRIPTION OF WORK & INTENDED USE Single Family Residence

(2) APPLICANT Zeck & Assoc, LLC TYPE OF HOME PROPOSED:
 Site Built Manufactured Home (UBC)
 Manufactured Home (HUD)
 Other (please specify) _____

(2) ADDRESS PO Box 1083

(2) TELEPHONE 970-252-9483

REQUIRED: One plot plan, on 8 1/2" x 11" paper, showing all existing & proposed structure location(s), parking, setbacks to all property lines, ingress/egress to the property, driveway location & width & all easements & rights-of-way which abut the parcel.

THIS SECTION TO BE COMPLETED BY COMMUNITY DEVELOPMENT DEPARTMENT STAFF

ZONE RMF-5 Maximum coverage of lot by structures _____

SETBACKS: Front 20' from property line (PL) Permanent Foundation Required: YES NO _____
 or _____ from center of ROW, whichever is greater

Side 5' from PL, Rear 25' from PL Parking Req't 2

Maximum Height 35' Special Conditions _____

CENSUS 8 TRAFFIC 58 ANNEX# _____

Modifications to this Planning Clearance must be approved, in writing, by the Community Development Department. The structure authorized by this application cannot be occupied until a final inspection has been completed and a Certificate of Occupancy has been issued, if applicable, by the Building Department (Section 305, Uniform Building Code).

I hereby acknowledge that I have read this application and the information is correct; I agree to comply with any and all codes, ordinances, laws, regulations or restrictions which apply to the project. I understand that failure to comply shall result in legal action, which may include but not necessarily be limited to non-use of the building(s).

Applicant Signature Mary K. Zeck Date 8-2-00

Department Approval Pat C. Gay Wilson Date 8-7-00

Additional water and/or sewer tap fee(s) are required:	YES <input checked="" type="checkbox"/>	NO	W/O. No. <u>see attached</u>
Utility Accounting	<u>CM Cole</u>	Date	<u>8/7/00</u>

VALID FOR SIX MONTHS FROM DATE OF ISSUANCE (Section 9-3-2C Grand Junction Zoning & Development Code)


(White: Planning) (Yellow: Customer) (Pink: Building Department) (Goldenrod: Utility Accounting)

3115
D 3/4 ROAD

ACCEPTED
ANY CHANGE OF SETBACKS MUST BE APPROVED BY THE CITY PLANNING DEPT. IT IS THE APPLICANT'S RESPONSIBILITY TO PROPERLY LOCATE AND IDENTIFY EASEMENTS AND PROPERTY LINES.

8-7-00
C. Jay Wilson

PLOT PLAN
SCALE: N.T.S.

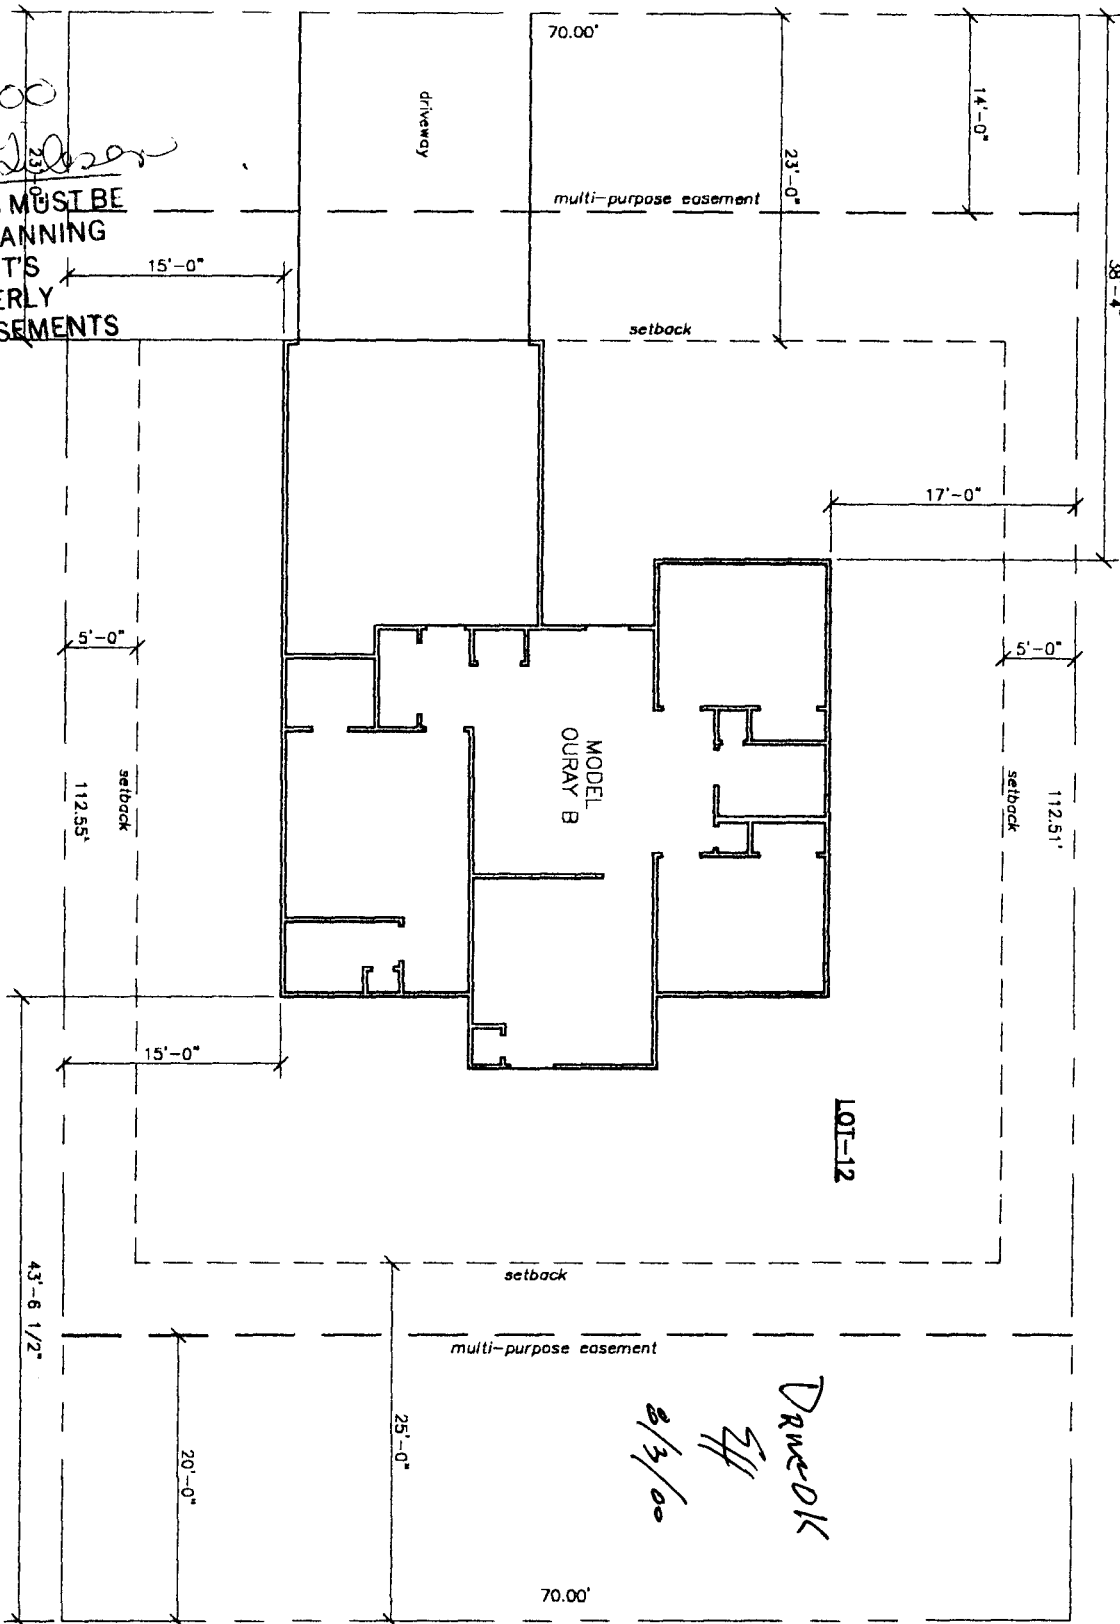

Drawn
8/3/00
JH

PL-1

JMK & Associates LLC
P.O. Box 1083
Grand Junction, CO 81502
(970) 257-9483



Zeck & Associates LLC
P.O. Box 1083
Grand Junction, CO 81502
(970) 257-9483

PLOT PLAN for
Lot 12, Block 3
Summit View Ranch

N