

FEE \$	10.00
TCP \$	500.00
SIF \$	292.00

PLANNING CLEARANCE
 (Single Family Residential and Accessory Structures)
Community Development Department

BLDG PERMIT NO. 77256



Your Bridge to a Better Community

BLDG ADDRESS 3115 Evans Avenue SQ. FT. OF PROPOSED BLDGS/ADDITION 1309

TAX SCHEDULE NO. 2943-152-20-013 SQ. FT. OF EXISTING BLDGS 0

SUBDIVISION Summit View 2 TOTAL SQ. FT. OF EXISTING & PROPOSED 1309

FILING 2 BLK 3 LOT 1 NO. OF DWELLING UNITS:
 Before: 0 After: 1 this Construction

(1) OWNER Zeck & Assoc, LLC NO. OF BUILDINGS ON PARCEL
 Before: 0 After: 1 this Construction

(1) ADDRESS PO Box 1083 Grand Jct 81502 USE OF EXISTING BUILDINGS N/A

(1) TELEPHONE 970-257-9483 DESCRIPTION OF WORK & INTENDED USE Single Family Residence

(2) APPLICANT Zeck & Associates, LLC TYPE OF HOME PROPOSED:
 Site Built Manufactured Home (UBC)
 Manufactured Home (HUD)
 Other (please specify) _____

(2) ADDRESS PO Box 1083 Grand Jct

(2) TELEPHONE 970-257-9483

REQUIRED: One plot plan, on 8 1/2" x 11" paper, showing all existing & proposed structure location(s), parking, setbacks to all property lines, ingress/egress to the property, driveway location & width & all easements & rights-of-way which abut the parcel.

THIS SECTION TO BE COMPLETED BY COMMUNITY DEVELOPMENT DEPARTMENT STAFF

ZONE BMF-5 Maximum coverage of lot by structures 60%

SETBACKS: Front 20 from property line (PL) Permanent Foundation Required: YES NO
 or _____ from center of ROW, whichever is greater

Side 5' from PL, Rear 25' from PL Parking Req'mt 2

Maximum Height 35' Special Conditions _____

CENSUS 8 TRAFFIC 58 ANN# _____

Modifications to this Planning Clearance must be approved, in writing, by the Community Development Department. The structure authorized by this application cannot be occupied until a final inspection has been completed and a Certificate of Occupancy has been issued, if applicable, by the Building Department (Section 305, Uniform Building Code).

I hereby acknowledge that I have read this application and the information is correct; I agree to comply with any and all codes, ordinances, laws, regulations or restrictions which apply to the project. I understand that failure to comply shall result in legal action, which may include but not necessarily be limited to non-use of the building(s).

Applicant Signature Maryel R Zeck Date 10-17-00

Department Approval C. Jay Gibson Date 10-19-00


Additional water and/or sewer tap fee(s) are required:	YES <input checked="" type="checkbox"/>	NO <input type="checkbox"/>	W/O No. <u>See att.</u>
Utility Accounting	<u>Chulala</u>	Date	<u>10/19/00</u>

VALID FOR SIX MONTHS FROM DATE OF ISSUANCE (Section 9-3-2C Grand Junction Zoning & Development Code)

(White: Planning) (Yellow: Customer) (Pink: Building Department) (Goldenrod: Utility Accounting)

3115

EVANS AVENUE

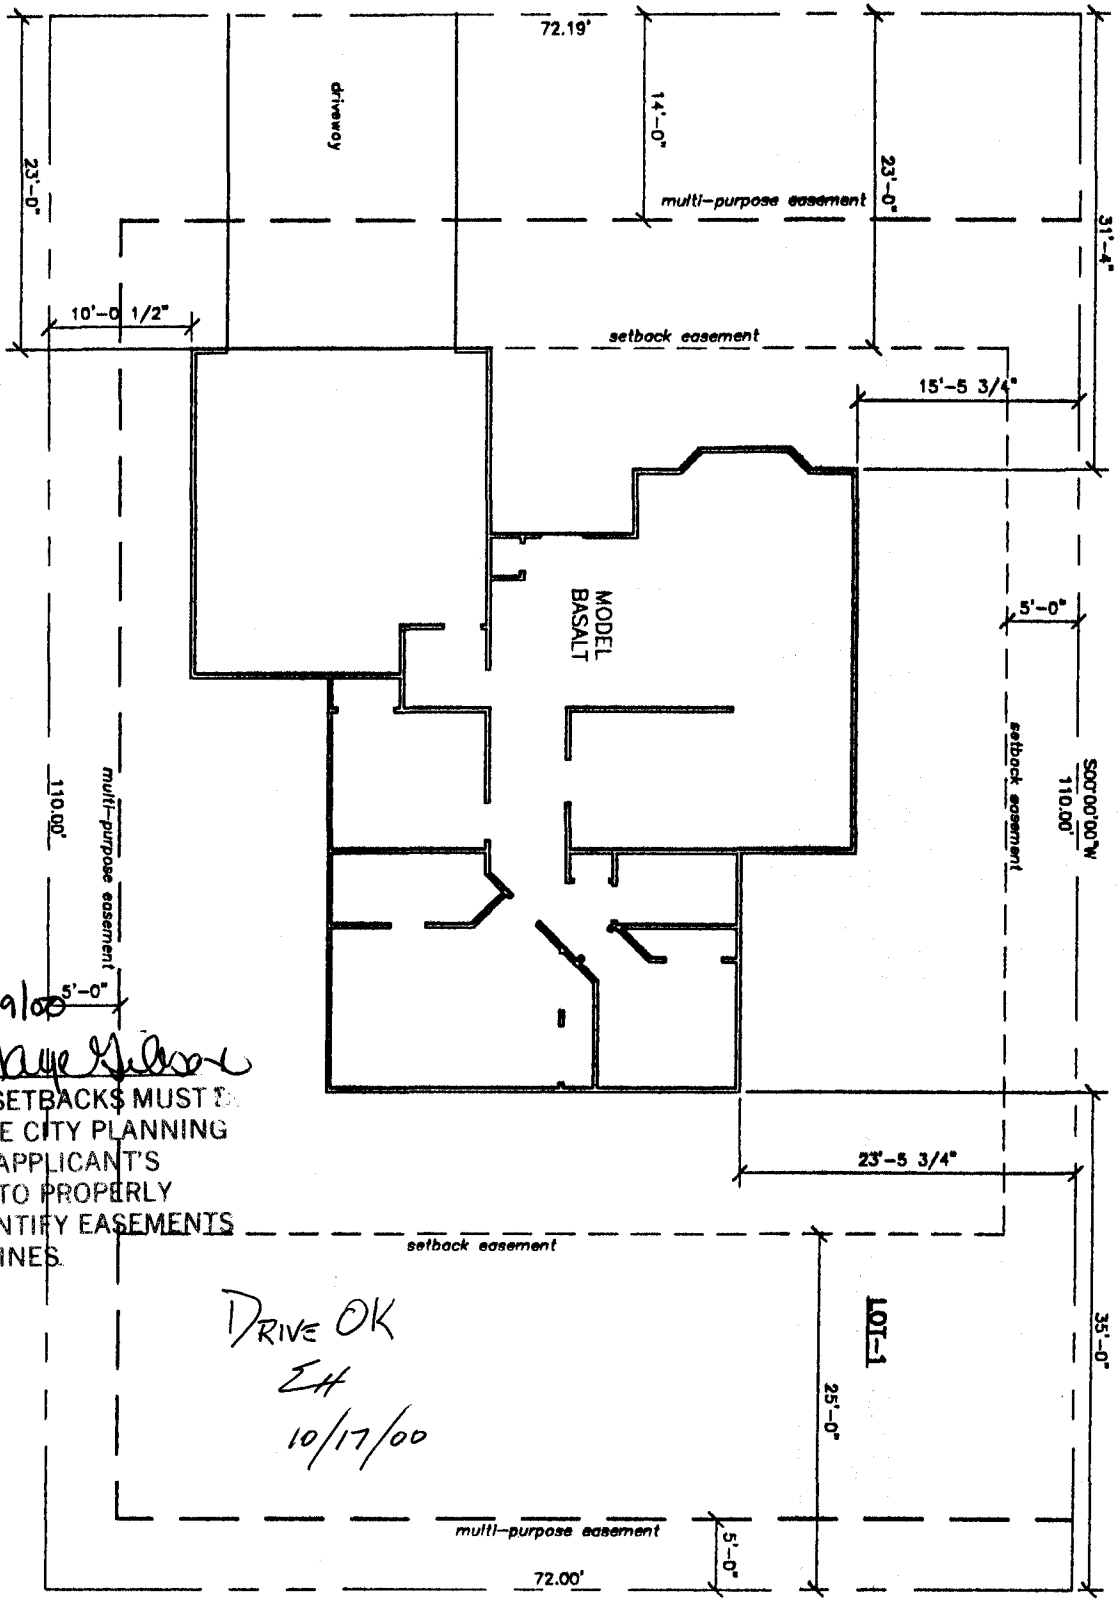

PLOT PLAN
SCALE: N.T.S.

10/19/00

ACCEPTED *C. Jane Wilson*
 ANY CHANGE OF SETBACKS MUST BE APPROVED BY THE CITY PLANNING DEPT. IT IS THE APPLICANT'S RESPONSIBILITY TO PROPERLY LOCATE AND IDENTIFY EASEMENTS AND PROPERTY LINES.

DRIVE OK
 EH
 10/17/00



PL-1 10/17/00	JMK & Associates, Inc. 1000 10th St., P.O. Box 1088 Grand Junction, CO 81502 (970) 257-9483	PLOT PLAN for Lot 1, Block 3 Summit View Ranch
	Zeck & Associates LLC P.O. Box 1088 Grand Junction, CO 81502 (970) 257-9483	