

FEE \$	10 ⁻
TCP \$	500 ⁻
SIF \$	292 ⁻

PLANNING CLEARANCE
 (Single Family Residential and Accessory Structures)
Community Development Department

BLDG PERMIT NO. 77982



Your Bridge to a Better Community

BLDG ADDRESS 658 Grand View SQ. FT. OF PROPOSED BLDGS/ADDITION 2300

TAX SCHEDULE NO. 2943-062-30-003 SQ. FT. OF EXISTING BLDGS —

SUBDIVISION Grand View TOTAL SQ. FT. OF EXISTING & PROPOSED —

FILING 4 BLK 2 LOT 4 NO. OF DWELLING UNITS:
 Before: — After: 1 this Construction

(1) OWNER Jerry Spomer NO. OF BUILDINGS ON PARCEL
 Before: 0 After: 1 this Construction

(1) ADDRESS _____ USE OF EXISTING BUILDINGS _____

(1) TELEPHONE _____ DESCRIPTION OF WORK & INTENDED USE New Residence

(2) APPLICANT GKS Builders TYPE OF HOME PROPOSED:
 Site Built Manufactured Home (UBC)
 Manufactured Home (HUD)
 Other (please specify) _____

(2) ADDRESS 672 29 1/2 Road

(2) TELEPHONE 242-6123

REQUIRED: One plot plan, on 8 1/2" x 11" paper, showing all existing & proposed structure location(s), parking, setbacks to all property lines, ingress/egress to the property, driveway location & width & all easements & rights-of-way which abut the parcel.

THIS SECTION TO BE COMPLETED BY COMMUNITY DEVELOPMENT DEPARTMENT STAFF

ZONE RMF-5 Maximum coverage of lot by structures _____

SETBACKS: Front 20 from property line (PL) Permanent Foundation Required: YES NO
 or _____ from center of ROW, whichever is greater

Side 5 from PL, Rear 25 from PL Parking Req'mt 2

Maximum Height 35' Special Conditions _____

CENSUS 10 TRAFFIC 22 ANN# _____

Modifications to this Planning Clearance must be approved, in writing, by the Community Development Department. The structure authorized by this application cannot be occupied until a final inspection has been completed and a Certificate of Occupancy has been issued, if applicable, by the Building Department (Section 305, Uniform Building Code).

I hereby acknowledge that I have read this application and the information is correct; I agree to comply with any and all codes, ordinances, laws, regulations or restrictions which apply to the project. I understand that failure to comply shall result in legal action, which may include but not necessarily be limited to non-use of the building(s).

Applicant Signature Jerry Spomer Date 12/7/00


Department Approval [Signature] Date 12/8/00

Additional water and/or sewer tap fees are required:	YES <input checked="" type="checkbox"/>	NO <input type="checkbox"/>	W/O No. <u>13589</u>
Utility Accounting	<u>[Signature]</u>		Date <u>12/8/00</u>

VALID FOR SIX MONTHS FROM DATE OF ISSUANCE (Section 9-3-2C Grand Junction Zoning & Development Code)

(White: Planning) (Yellow: Customer) (Pink: Building Department) (Goldenrod: Utility Accounting)

ACCEPTED *Clare Gibson*
 ANY CHANGE OF SETBACKS MUST BE
 APPROVED BY THE CITY PLANNING
 DEPT. IT IS THE APPLICANT'S
 RESPONSIBILITY TO PROPERLY
 LOCATE AND IDENTIFY EASEMENTS
 AND PROPERTY LINES.

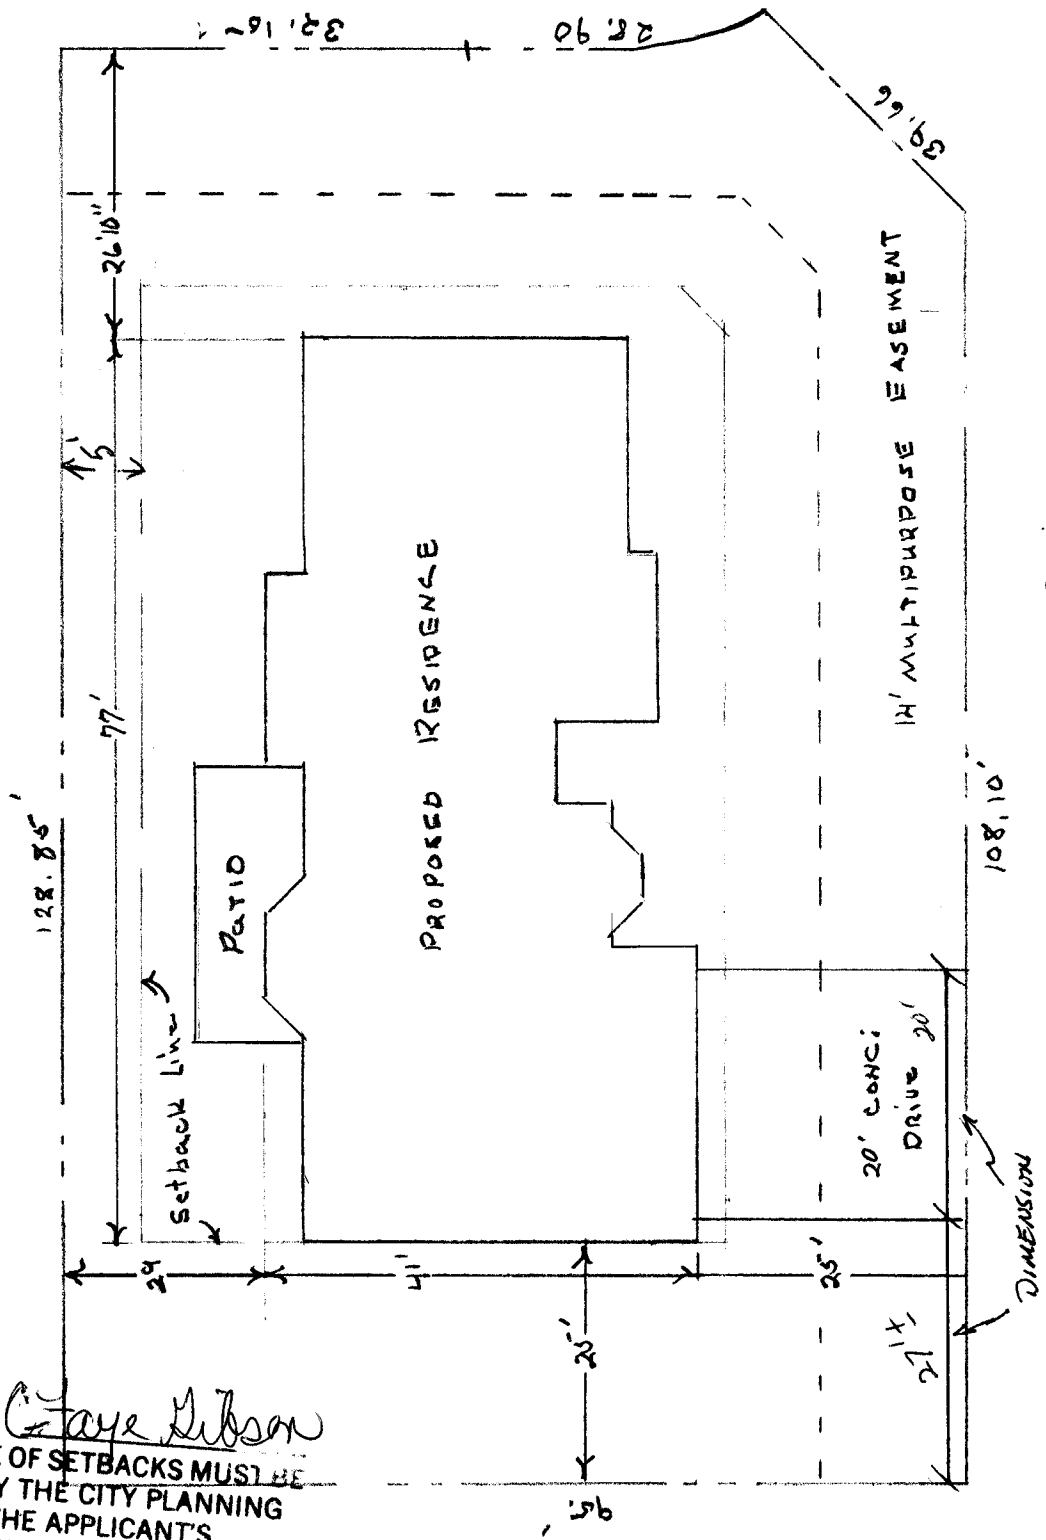

FRIDRA COURT

LOT 6 BLOCK 2
 GRAND VIEW SUB.
 FILING FOUR
 2943-062-30-003

DRIVE OK
David R. Smith
 12/7/2000
 DEPT ENGINEERING

GRAND VIEW DRIVE