

New home

FEE \$	10.00
TCP \$	—
SIF \$	292.00

PLANNING CLEARANCE
 (Single Family Residential and Accessory Structures)
Community Development Department

BLDG PERMIT NO. 74054



Your Bridge to a Better Community

BLDG ADDRESS 2805 Laddie Way SQ. FT. OF PROPOSED BLDGS/ADDITION 1343
 TAX SCHEDULE NO. 2943-062-00-048 SQ. FT. OF EXISTING BLDGS —
 SUBDIVISION Northster II TOTAL SQ. FT. OF EXISTING & PROPOSED 1343
 FILING 1 BLK 1 LOT 5 NO. OF DWELLING UNITS:
 Before: 0 After: 1 this Construction
 NO. OF BUILDINGS ON PARCEL
 Before: 0 After: 1 this Construction
 (1) OWNER Peck Construction, Spec.
 (1) ADDRESS 2347 S. Rin Drive USE OF EXISTING BUILDINGS —
 (1) TELEPHONE 255-8010 DESCRIPTION OF WORK & INTENDED USE Single Family
 (2) APPLICANT Milo Johnson TYPE OF HOME PROPOSED:
 (2) ADDRESS 2347 South Rin Dr. Site Built Manufactured Home (UBC)
 (2) TELEPHONE 255-8010 Manufactured Home (HUD)
 Other (please specify) _____

REQUIRED: One plot plan, on 8 1/2" x 11" paper, showing all existing & proposed structure location(s), parking, setbacks to all property lines, ingress/egress to the property, driveway location & width & all easements & rights-of-way which abut the parcel.

THIS SECTION TO BE COMPLETED BY COMMUNITY DEVELOPMENT DEPARTMENT STAFF

ZONE RSF-5 Maximum coverage of lot by structures 35%
 SETBACKS: Front 20' from property line (PL) Permanent Foundation Required: YES NO
 or 45' from center of ROW, whichever is greater
 Side 5' from PL, Rear 25' from PL Parking Req'mt 2
 Maximum Height 32' Special Conditions _____
 CENSUS 10 TRAFFIC 22 ANNEX# _____

Modifications to this Planning Clearance must be approved, in writing, by the Community Development Department. The structure authorized by this application cannot be occupied until a final inspection has been completed and a Certificate of Occupancy has been issued, if applicable, by the Building Department (Section 305, Uniform Building Code).

I hereby acknowledge that I have read this application and the information is correct; I agree to comply with any and all codes, ordinances, laws, regulations or restrictions which apply to the project. I understand that failure to comply shall result in legal action, which may include but not necessarily be limited to non-use of the building(s).


Applicant Signature [Signature] Date 2/24/00
 Department Approval [Signature] Date 3-15-00

Additional water and/or sewer tap fee(s) are required:	YES <input checked="" type="checkbox"/>	NO <input type="checkbox"/>	W/O No. <u>12940</u>
Utility Accounting	<u>[Signature]</u>		Date <u>3/15/00</u>

VALID FOR SIX MONTHS FROM DATE OF ISSUANCE (Section 9-3-2C Grand Junction Zoning & Development Code)

(White: Planning) (Yellow: Customer) (Pink: Building Department) (Goldenrod: Utility Accounting)

ACCEPTED SLC 3-15-00
ANY CHANGE OF SETBACKS MUST BE
APPROVED BY THE CITY PLANNING
DEPT. IT IS THE APPLICANT'S
RESPONSIBILITY TO PROPERLY
LOCATE AND IDENTIFY EASEMENTS
AND PROPERTY LINES.

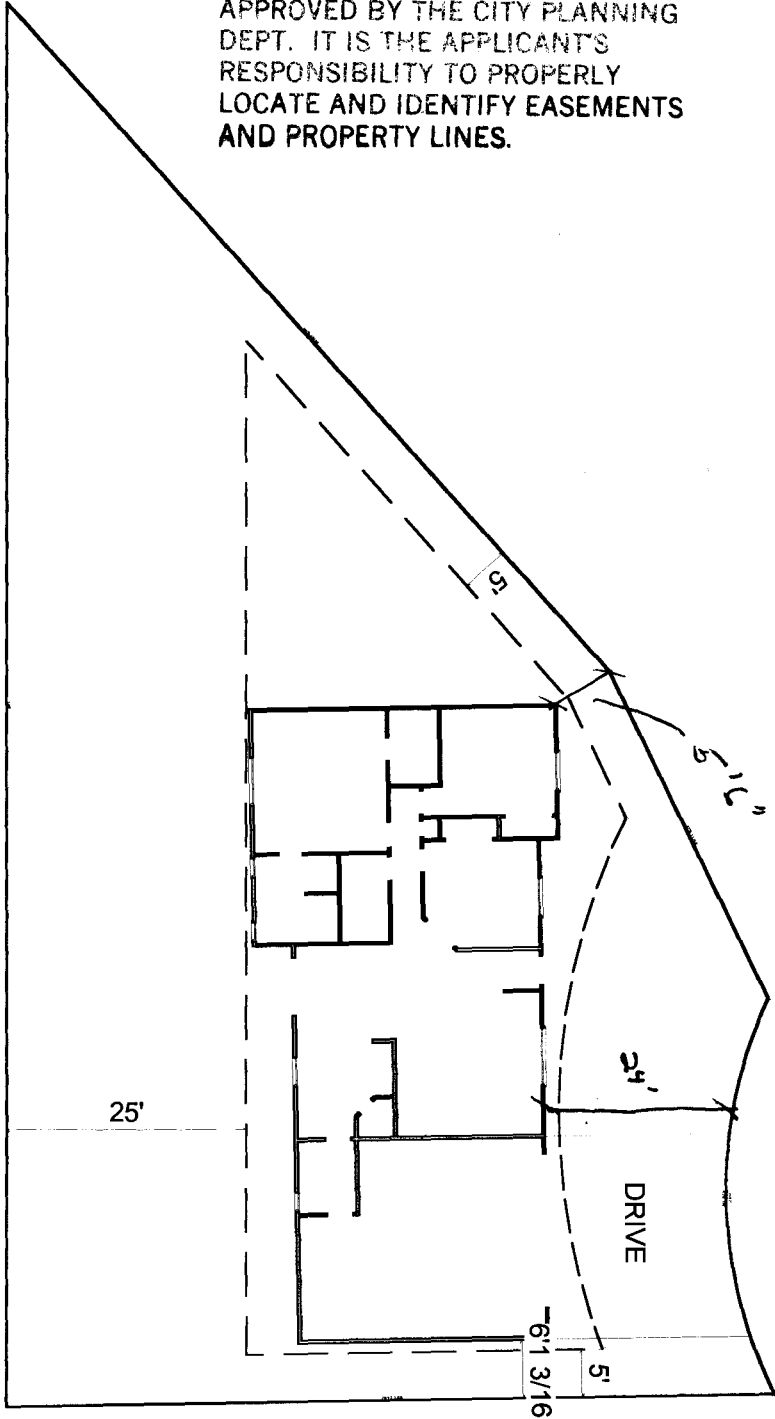

DRIVEWAY OK
Ernie
2/25/00

LADDIE
WAY

2805 Laddie Way