

FEE \$	10.00
TCP \$	—
SIF \$	292.00

**PLANNING CLEARANCE**  
 (Single Family Residential and Accessory Structures)  
**Community Development Department**

BLDG PERMIT NO. 74592



Your Bridge to a Better Community

BLDG ADDRESS 2812 Lodd: eVey SQ. FT. OF PROPOSED BLDGS/ADDITION 1481

TAX SCHEDULE NO. 2943-062-00-048 SQ. FT. OF EXISTING BLDGS —

SUBDIVISION Northstar II TOTAL SQ. FT. OF EXISTING & PROPOSED 1481

FILING 1 BLK 1 LOT 13 NO. OF DWELLING UNITS:  
 Before: — After: 1 this Construction

(1) OWNER Peak Construction Spec NO. OF BUILDINGS ON PARCEL  
 Before: — After: 1 this Construction

(1) ADDRESS 2347 South Rin Dr. USE OF EXISTING BUILDINGS —

(1) TELEPHONE 255-8010 DESCRIPTION OF WORK & INTENDED USE Single Family

(2) APPLICANT Milo Johnson TYPE OF HOME PROPOSED:  
 Site Built  Manufactured Home (UBC)  
 Manufactured Home (HUD)  
 Other (please specify) \_\_\_\_\_

(2) ADDRESS 2347 S. Rin Dr.

(2) TELEPHONE 255-8010

**REQUIRED: One plot plan, on 8 1/2" x 11" paper, showing all existing & proposed structure location(s), parking, setbacks to all property lines, ingress/egress to the property, driveway location & width & all easements & rights-of-way which abut the parcel.**

**THIS SECTION TO BE COMPLETED BY COMMUNITY DEVELOPMENT DEPARTMENT STAFF**

ZONE RSF-5 Maximum coverage of lot by structures \_\_\_\_\_

SETBACKS: Front 20' new code from property line (PL) Permanent Foundation Required: YES  NO   
 or \_\_\_\_\_ from center of ROW, whichever is greater

Side 5' from PL, Rear 25' from PL Parking Req'mt 2

Maximum Height 32' Special Conditions \_\_\_\_\_

CENSUS 10 TRAFFIC 22 ANN# \_\_\_\_\_

Modifications to this Planning Clearance must be approved, in writing, by the Community Development Department. The structure authorized by this application cannot be occupied until a final inspection has been completed and a Certificate of Occupancy has been issued, if applicable, by the Building Department (Section 305, Uniform Building Code).

I hereby acknowledge that I have read this application and the information is correct; I agree to comply with any and all codes, ordinances, laws, regulations or restrictions which apply to the project. I understand that failure to comply shall result in legal action, which may include but not necessarily be limited to non-use of the building(s).

Applicant Signature [Signature] Date 4/1/00


Department Approval Bonnie Edwards Date 4-24-00

Additional water and/or sewer tap fee(s) are required:	YES <input checked="" type="checkbox"/>	NO	W/O No. <u>3042</u>
Utility Accounting <u>[Signature]</u>	Date _____		

VALID FOR SIX MONTHS FROM DATE OF ISSUANCE (Section 9-3-2C Grand Junction Zoning & Development Code)

(White: Planning) (Yellow: Customer) (Pink: Building Department) (Goldenrod: Utility Accounting)

2012 Loddie Way  
1" = 20'

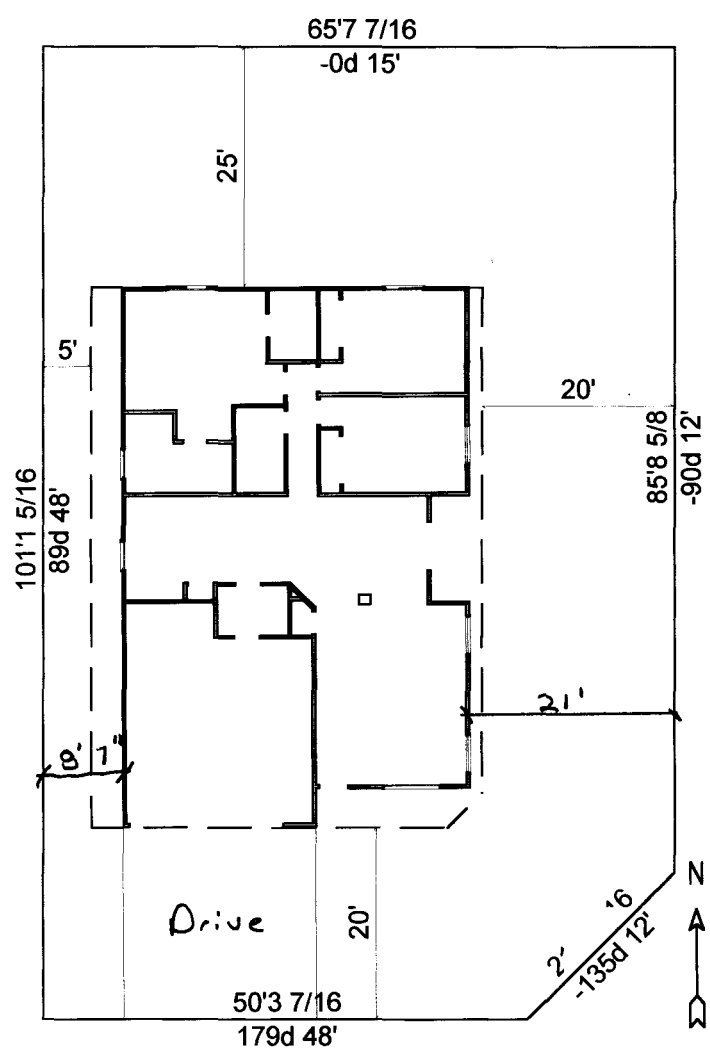

Windster

Loddie Way

DRIVE OK  
EWD  
4/3/00

4/24/00  
ACCEPTED *Ronne*  
ANY CHANGE OF SETBACKS MUST BE  
APPROVED BY THE CITY PLANNING  
DEPT. IT IS THE APPLICANT'S  
RESPONSIBILITY TO PROPERLY  
LOCATE AND IDENTIFY EASEMENTS  
AND PROPERTY LINES.