

Multi-

Duplexes (1 per planning clearance)

FEE \$	—
TCP \$	—
SIF \$	292.00

PLANNING CLEARANCE

BLDG PERMIT NO. 74206

(Single Family Residential and Accessory Structures)
Community Development Department



Your Bridge to a Better Community

BLDG ADDRESS 663 LAREDO CT SQ. FT. OF PROPOSED BLDGS/ADDITION 1027 ~~41~~

TAX SCHEDULE NO. 2945-032-W-130 SQ. FT. OF EXISTING BLDGS 2

SUBDIVISION WESTWOOD RANCH TOTAL SQ. FT. OF EXISTING & PROPOSED 1027 ~~41~~

FILING 2 BLK 1 LOT 4A NO. OF DWELLING UNITS:
 Before: 0 After: 1 this Construction
 NO. OF BUILDINGS ON PARCEL
 Before: 2 After: 1 this Construction

(1) OWNER Lee Hones USE OF EXISTING BUILDINGS 2

(1) ADDRESS 2755 N. AVE DESCRIPTION OF WORK & INTENDED USE new residence

(1) TELEPHONE 248-4612 TYPE OF HOME PROPOSED:
 Site Built Manufactured Home (UBC)
 Manufactured Home (HUD)
 Other (please specify) _____

(2) APPLICANT Lee Hones

(2) ADDRESS 2755 N. AVE

(2) TELEPHONE 248-4612

REQUIRED: One plot plan, on 8 1/2" x 11" paper, showing all existing & proposed structure location(s), parking, setbacks to all property lines, ingress/egress to the property, driveway location & width & all easements & rights-of-way which abut the parcel.

THIS SECTION TO BE COMPLETED BY COMMUNITY DEVELOPMENT DEPARTMENT STAFF

ZONE PR43 Maximum coverage of lot by structures 40%

SETBACKS: Front 20' from property line (PL) Permanent Foundation Required: YES NO
 or _____ from center of ROW, whichever is greater

Side 7' from PL, Rear 25' from PL Parking Req'mt 2

Maximum Height _____ Special Conditions _____

CENSUS 19 TRAFFIC 10 ANN# _____

Modifications to this Planning Clearance must be approved, in writing, by the Community Development Department. The structure authorized by this application cannot be occupied until a final inspection has been completed and a Certificate of Occupancy has been issued, if applicable, by the Building Department (Section 305, Uniform Building Code).

I hereby acknowledge that I have read this application and the information is correct; I agree to comply with any and all codes, ordinances, laws, regulations or restrictions which apply to the project. I understand that failure to comply shall result in legal action, which may include but not necessarily be limited to non-use of the building(s).

Applicant Signature [Signature] Date 6 MARCH

Department Approval [Signature] Date 3/7/00

Additional water and/or sewer tap fee(s) are required:	YES <input checked="" type="checkbox"/>	NO	W/O No/ <u>2907</u>
Utility Accounting	<u>[Signature]</u>	Date	<u>3/7/00</u>

VALID FOR SIX MONTHS FROM DATE OF ISSUANCE (Section 9-3-2C Grand Junction Zoning & Development Code)

(White: Planning) (Yellow: Customer) (Pink: Building Department) (Goldenrod: Utility Accounting)

FEE \$	10.00
TCP \$	—
SIF \$	292.00

PLANNING CLEARANCE
 (Single Family Residential and Accessory Structures)
Community Development Department

BLDG PERMIT NO. 74205



Your Bridge to a Better Community

BLDG ADDRESS 663 LARSON CT SQ. FT. OF PROPOSED BLDGS/ADDITION 1027

TAX SCHEDULE NO. 2445-032-00130 SQ. FT. OF EXISTING BLDGS 2

SUBDIVISION Westwood Ranch TOTAL SQ. FT. OF EXISTING & PROPOSED 1027

FILING 2 BLK 1 LOT 413 NO. OF DWELLING UNITS:
 Before: 0 After: 1 this Construction

(1) OWNER Lee Hones NO. OF BUILDINGS ON PARCEL
 Before: 2 After: 1 this Construction

(1) ADDRESS 2755 N. AVE USE OF EXISTING BUILDINGS 0

(1) TELEPHONE 247-4612 DESCRIPTION OF WORK & INTENDED USE new Residence

(2) APPLICANT Lee Hones TYPE OF HOME PROPOSED:
X Site Built _____ Manufactured Home (UBC)
 _____ Manufactured Home (HUD)
 _____ Other (please specify) _____

(2) ADDRESS 2755 N. AVE

(2) TELEPHONE 247-4612

REQUIRED: One plot plan, on 8 1/2" x 11" paper, showing all existing & proposed structure location(s), parking, setbacks to all property lines, ingress/egress to the property, driveway location & width & all easements & rights-of-way which abut the parcel.

THIS SECTION TO BE COMPLETED BY COMMUNITY DEVELOPMENT DEPARTMENT STAFF

ZONE PR43 Maximum coverage of lot by structures 40%

SETBACKS: Front 20' from property line (PL) Permanent Foundation Required: YES X NO _____
 or _____ from center of ROW, whichever is greater

Side 7' from PL, Rear 25' from PL Parking Req'mt 2

Maximum Height _____ Special Conditions _____

CENSUS 19 TRAFFIC 10 ANN# _____

Modifications to this Planning Clearance must be approved, in writing, by the Community Development Department. The structure authorized by this application cannot be occupied until a final inspection has been completed and a Certificate of Occupancy has been issued, if applicable, by the Building Department (Section 305, Uniform Building Code).

I hereby acknowledge that I have read this application and the information is correct; I agree to comply with any and all codes, ordinances, laws, regulations or restrictions which apply to the project. I understand that failure to comply shall result in legal action, which may include, but not necessarily be limited to non-use of the building(s).

Applicant Signature [Signature] Date 6 MAR 00

Department Approval [Signature] Date 3/7/00

Additional water and/or sewer tap fee(s) are required:	YES <input checked="" type="checkbox"/>	NO <input type="checkbox"/>	W/O No. <u>12907</u>
Utility Accounting	<u>[Signature]</u>		Date <u>3/7/00</u>


VALID FOR SIX MONTHS FROM DATE OF ISSUANCE (Section 9-3-2C Grand Junction Zoning & Development Code)

(White: Planning) (Yellow: Customer) (Pink: Building Department) (Goldenrod: Utility Accounting)

WESTWOOD RANCH SUBDIVISION
FILING NO. TWO

LOT 4A

1027 SF (MODIFIED PORCH)
1 ft shorter

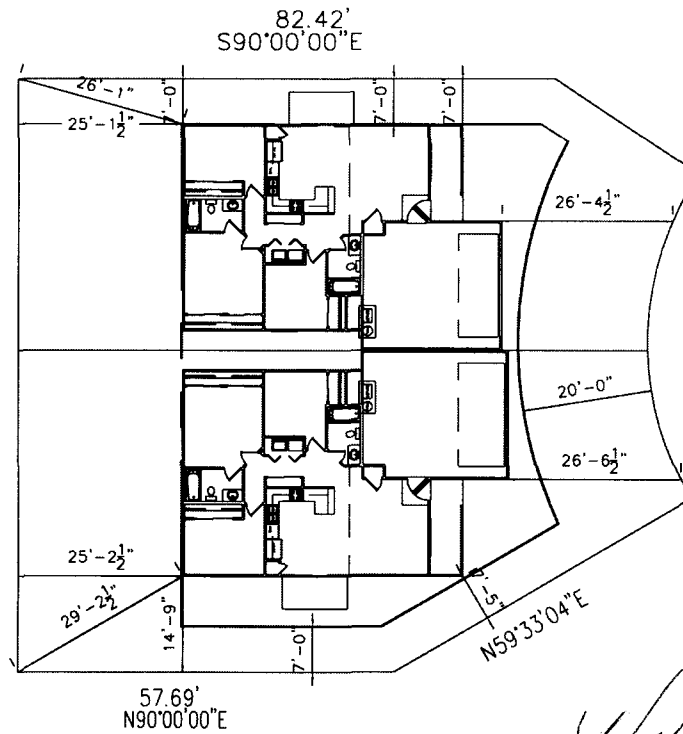

663 LAREDO CT



DRIVE OK
EWD ill
3/6/00

LOT 4B

ACCEPTED 4/15/00 3/7/00
ANY CHANGE OF SETBACKS MUST BE
APPROVED BY THE CITY PLANNING
DEPT. IT IS THE APPLICANT'S
RESPONSIBILITY TO PROPERLY
LOCATE AND IDENTIFY EASEMENTS
AND PROPERTY LINES.