

Planning \$ <u>10<sup>00</sup></u>	Drainage \$ <u>0</u>
TCP \$ <u>0</u>	School Impact \$ <u>0</u>

BLDG PERMIT NO. <u>73734</u>
FILE #

### PLANNING CLEARANCE

(site plan review, multi-family development, non-residential development)  
**Grand Junction Community Development Department**

THIS SECTION TO BE COMPLETED BY APPLICANT

BUILDING ADDRESS <u>2702 Patterson Rd</u>	TAX SCHEDULE NO. <u>2945-013-00-955</u>
SUBDIVISION _____	SQ. FT. OF PROPOSED BLDG(S)/ADDITION <u>960</u>
FILING _____ BLK _____ LOT _____	SQ. FT OF EXISTING BLDG(S) <u>?</u>
OWNER <u>Book Cliff Baptist</u>	NO. OF DWELLING UNITS: BEFORE _____ AFTER _____ CONSTRUCTION
ADDRESS <u>2702 Patterson Rd</u>	NO. OF BLDGS ON PARCEL: BEFORE <u>2</u> AFTER <u>3</u> CONSTRUCTION
TELEPHONE <u>243-9285</u>	USE OF ALL EXISTING BLDGS <u>SCHOOL/CHURCH</u>
APPLICANT _____	DESCRIPTION OF WORK & INTENDED USE: _____
ADDRESS <u>Same</u>	<u>STORAGE SHED</u>
TELEPHONE _____	

✓ Submittal requirements are outlined in the SSID (Submittal Standards for Improvements and Development) document.

THIS SECTION TO BE COMPLETED BY COMMUNITY DEVELOPMENT DEPARTMENT STAFF

ZONE <u>RSF-8</u>	LANDSCAPING/SCREENING REQUIRED: YES _____ NO <u>—</u>
SETBACKS: FRONT: _____ from Property Line (PL) or _____ from center of ROW, whichever is greater	PARKING REQUIREMENT: <u>NO</u>
SIDE: _____ from PL REAR: _____ from PL	SPECIAL CONDITIONS: _____
MAXIMUM HEIGHT <u>OK</u>	
MAXIMUM COVERAGE OF LOT BY STRUCTURES <u>OK</u>	CENSUS TRACT <u>10</u> TRAFFIC ZONE <u>21</u> ANNEX _____

Modifications to this Planning Clearance must be approved, in writing, by the Community Development Department Director. The structure authorized by this application cannot be occupied until a final inspection has been completed and a Certificate of Occupancy has been issued by the Building Department (Section 307, Uniform Building Code). Required improvements in the public right-of-way must be guaranteed prior to issuance of a Planning Clearance. All other required site improvements must be completed or guaranteed prior to issuance of a Certificate of Occupancy. Any landscaping required by this permit shall be maintained in an acceptable and healthy condition. The replacement of any vegetation materials that die or are in an unhealthy condition is required by the Grand Junction Zoning and Development Code.

Four (4) sets of final construction drawings must be submitted and stamped by City Engineering prior to issuing the Planning Clearance. One stamped set must be available on the job site at all times.

I hereby acknowledge that I have read this application and the information is correct; I agree to comply with any and all codes, ordinances, laws, regulations, or restrictions which apply to the project. I understand that failure to comply shall result in legal action, which may include but not necessarily be limited to non-use of the building(s).

Applicant's Signature <u>Lewis E Long</u>	Date <u>1-10-00</u>
Department Approval <u>Bill Neph</u>	Date <u>1-10-00</u>


Additional water and/or sewer tap fee(s) are required: YES <u>NO</u>	W/O No. <u>No chg in use</u>
Utility Accounting <u>CJ Marshall</u>	Date <u>1/10/00</u>

VALID FOR SIX MONTHS FROM DATE OF ISSUANCE (Section 9-3-2C Grand Junction Zoning and Development Code)

(White: Planning) (Yellow: Customer) (Pink: Building Department) (Goldenrod: Utility Accounting)

← 12TH ST

ALLEY

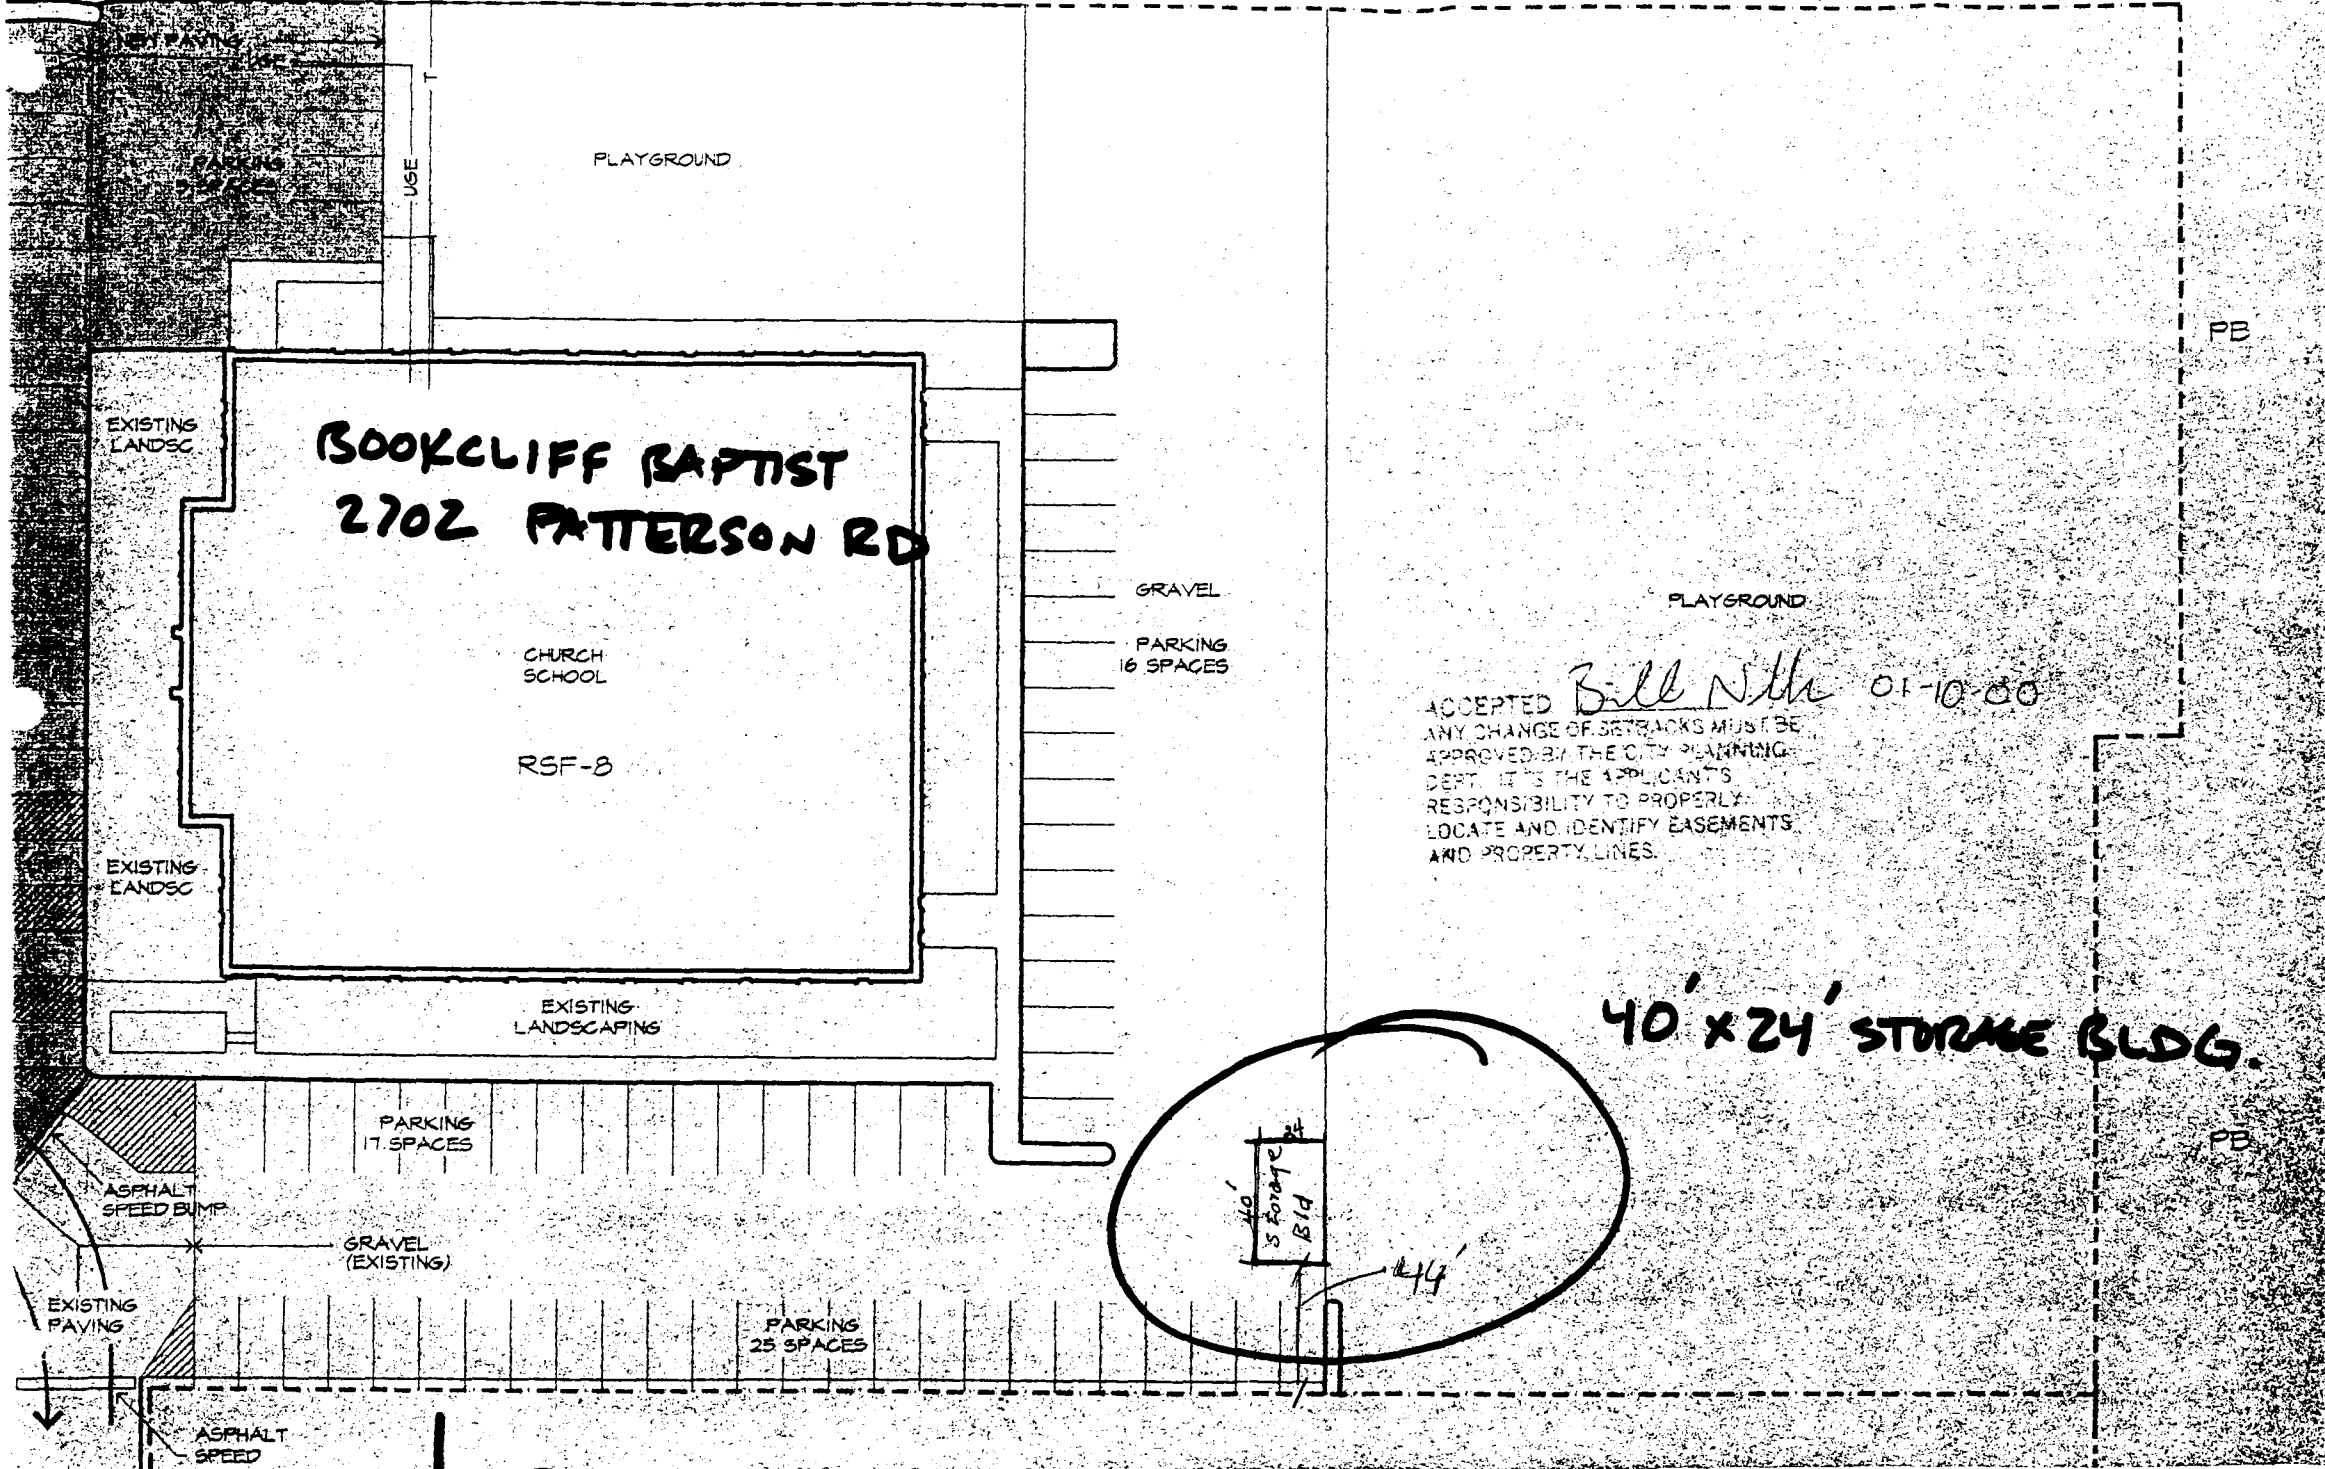


BOOKCLIFF BAPTIST  
2702 PATTERSON RD

CHURCH  
SCHOOL  
  
RSF-8

GRAVEL  
PARKING  
16 SPACES

ACCEPTED *Bill Nth* 01-10-00  
ANY CHANGE OF SETBACKS MUST BE  
APPROVED BY THE CITY PLANNING  
DEPT. IT IS THE APPLICANT'S  
RESPONSIBILITY TO PROPERLY  
LOCATE AND IDENTIFY EASEMENTS  
AND PROPERTY LINES.

40' x 24' STORAGE BLDG.

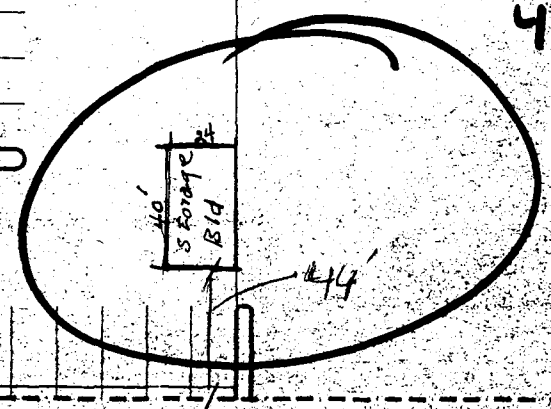

↓ PATTERSON

ROBERT D.

BAPTIST CHURCH