FEE\$	10-
TCP\$	500-
SIF \$	0

PLANNING CLEARANCE

(Single Family Residential and Accessory Structures)


Community Development Department

BLDG PERMIT NO.	73927
-----------------	-------



our Bridge to a Better Community

BLDG ADDRESS 366 Ridge Circle Dr.	SQ. FT. OF PROPOSED BLDGS/ADDITION <u>5299</u>
TAX SCHEDULE NO 2945-201-05-030	SQ. FT. OF EXISTING BLDGS
SUBDIVISION <u>Ridges</u>	TOTAL SQ. FT. OF EXISTING & PROPOSED
FILING 4 BLK 12 LOT 30 C	NO. OF DWELLING UNITS:
(1) OWNER James & Cheryl Wilcox	Before: After: this Construction NO. OF BUILDINGS ON PARCEL
(1) ADDRESS 353 Pifkin ave G.J.	Before: After: this Construction
(1) TELEPHONE <u>241 - 2194</u>	USE OF EXISTING BUILDINGS
(2) APPLICANT J. d. C. Wilcox	DESCRIPTION OF WORK & INTENDED USE <u>Residence</u>
(2) ADDRESS 353 Pilkins	TYPE OF HOME PROPOSED: Site Built Manufactured Home (UBC)
(2) TELEPHONE 241-2194	Manufactured Home (HUD) Other (please specify)
	all existing & proposed structure location(s), parking, setbacks to all cation & width & all easements & rights-of-way which abut the parcel.
	OMMUNITY DEVELOPMENT DEPARTMENT STAFF 🐿
ZONE PRY	Maximum coverage of lot by structures
SETBACKS: Front 201 from property line (PL)	Permanent Foundation Required: YES_X_NO
or from center of ROW, whichever is greater	Parking Req'mt
Side /b' from PL, Rear /b' from F	' L
Maximum Height 28'	Special Conditions
	ved, in writing, by the Community Development Department. The
structure authorized by this application cannot be occup Occupancy has been issued, if applicable, by the Buildir	ied until a final inspection has been completed and a Certificate of ng Department (Section 305, Uniform Building Code).
Lhoroby asknowledge that I have read this application and	A the information is correct: Learne to comply with any and all codes
	the information is correct; I agree to comply with any and all codes, to the project. I understand that failure to comply shall result in legal
action, which may include but not necessarily be limited	
Applicant Signature June Delle	Date
Department Approval Lonnil Edward	Date 2/14/00
dditional water and/or sewer tap fee(s) are required:	YES NO , WONG 5 3
Utility Accounting () () () () (Date //4/7)
VALID FOR SIX MONTHS FROM DATE OF ISSUANCE	(Section 9-3-2C Grand Junction Zoning & Development Code)
(White: Planning) (Yellow: Customer) (Pin	nk: Building Department) (Goldenrod: Utility Accounting)

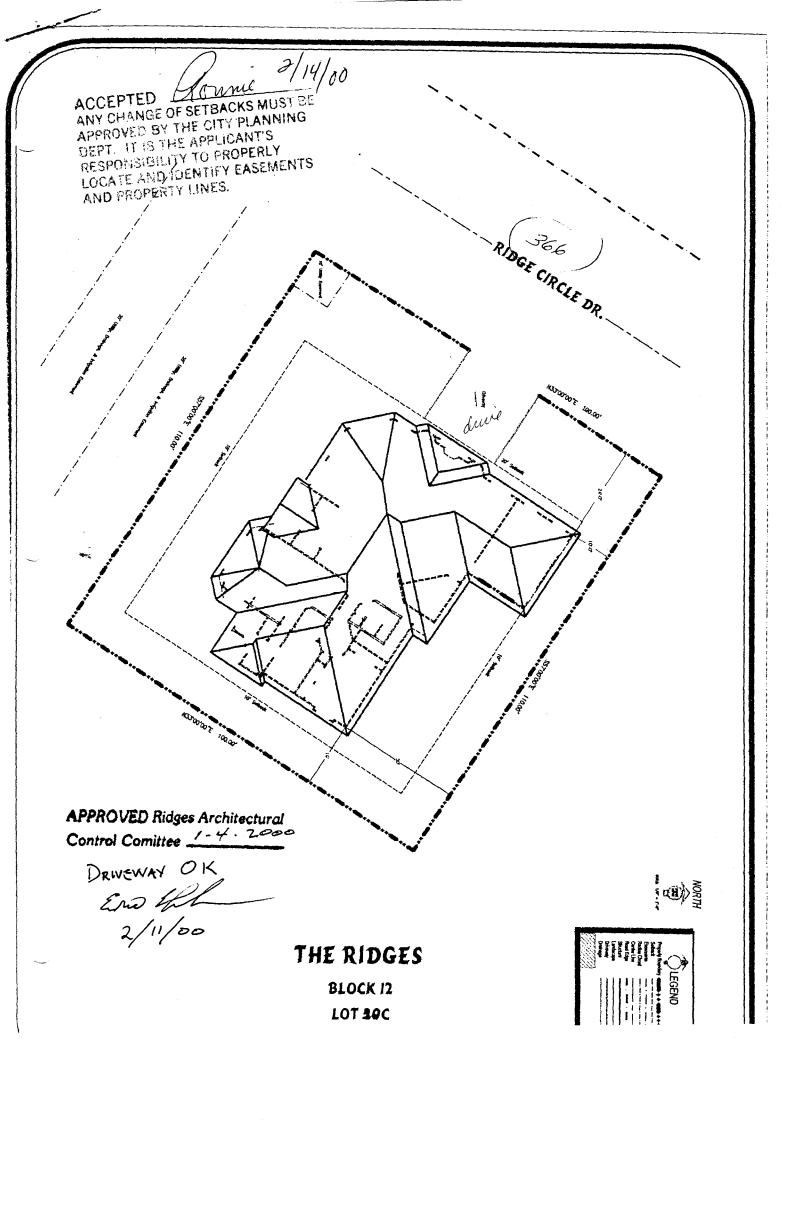

	O 01:22p FreeStyle In Strip # # 0 p.1
APPRO	VAL FOR BUILDING PERMIT. Job No.
Ridges Archit	ectural Control Committee (ACCO) Builder of Homeowner
-	James Wilcox
	RETURN TO Block 12 Lot 30 C
A - Approved	TONY STRASSER Pages Submitted
NA - Not Approv	TEC. 243.3355 Date Submitted
CITE DI AM	
SITE PLAN A NA	
	Front setback (20'-0" minimum)
	Rear setback (10'-0" minimum) NOTE: Architectural Control Com-
	Side setbacks (10'-0" minimum "B" and "C" lots) mittee assumes no responsibility
	Square Footage 3 4 4 / formance to all applicable codes.
	Square Footage Sidewalks NO
	Driveway (asphaltor concrete) V = 5
	Drainage Toward (HE STREET):
	Landscaping SUBMIT LAND SCAPING PLAN FOR
	pricoac of
	NOTE: Driveway shall be constructed of asphalt or concrete and shall extend to street paving with a 12" minimum drainage pipe extended 2'-0" minimum each side of driveway.
•	NOTE: All drainage shall be directed away from the foundation and disposed of without flowing onto adjacent lots.
	NOTE: Water meter and irrigation riser must not be disturbed without permission of Ridges Metropolitan District.
• .	HOTE. Water mater and in ganon had much be distorbed willout permission of hidges metropolitan district.
EXTERIOR E	LEVATIONS Zo'- 0 "
	Height (25'0" maximum)
	Trim - Color
3 C	Siding · Material STUCCO Color TAN
	MaterialColor
d a	BalconyADDROVED Ridges Avabite stural
	Porches or patios Pepulos Pepulos Perus 1. 4. 2000
u L	Other
	(F. Garet (Mass) Vis
	NOTE: All exposed flashing and metal shall be painted so as to blend my adjacent material (1) (3)
APPROVED	SUBJECT TO:
PEFER	APPROJAC PEHDING EFFORTS TO COMBINE DRING
WA93	TO 3 PROPERTIES EAST (UP THE HILL). WISH TO
A-VOUR	
cours	SINCING PRIVE WATS RESOLVED TO PELETE DRIVEWAY ALOUND HOUSE TO UPPER GARAGE.
	NOTE. Sewer, radon, and water permits must be obtained prior to issuance of building permit.
	NOTE: ACCO makes no judgement on founcation design.
By signature to on building pl	below, builder or owner guarantees that improvements will be constructed as shown on this form and
	ans that were submitted, including plot plan, landscaping, and drainage plan.
RIDGES Arch	ans that were submitted, including plot plan, landscaping, and drainage plan. Bulliver/Realtor/Homeowner By By AMO By