

FEE \$	10.00
TCP \$	450.00
SIF \$	292.00

PLANNING CLEARANCE
 (Single Family Residential and Accessory Structures)
Community Development Department

BLDG PERMIT NO. 76270



Your Bridge to a Better Community

BLDG ADDRESS 630 Round Table Rd SQ. FT. OF PROPOSED BLDGS/ADDITION 1196

TAX SCHEDULE NO. 2943-04300-196 SQ. FT. OF EXISTING BLDGS 0

SUBDIVISION MT VISTA TOTAL SQ. FT. OF EXISTING & PROPOSED 1196

FILING 1 BLK 5 LOT 4 NO. OF DWELLING UNITS:
 Before: 0 After: 1 this Construction

(1) OWNER Lee Homes NO. OF BUILDINGS ON PARCEL
 Before: 0 After: 1 this Construction

(1) ADDRESS 2755 N. Ave USE OF EXISTING BUILDINGS 0

(1) TELEPHONE 248-4612 DESCRIPTION OF WORK & INTENDED USE New Residence

(2) APPLICANT Lee Homes TYPE OF HOME PROPOSED:
1 Site Built _____ Manufactured Home (UBC)
 _____ Manufactured Home (HUD)
 _____ Other (please specify)

(2) ADDRESS 2755 N. Ave

(2) TELEPHONE 248-4612

REQUIRED: One plot plan, on 8 1/2" x 11" paper, showing all existing & proposed structure location(s), parking, setbacks to all property lines, ingress/egress to the property, driveway location & width & all easements & rights-of-way which abut the parcel.

THIS SECTION TO BE COMPLETED BY COMMUNITY DEVELOPMENT DEPARTMENT STAFF

ZONE RSF-4 Maximum coverage of lot by structures 50%

SETBACKS: Front 20' from property line (PL) Permanent Foundation Required: YES X NO _____
 or _____ from center of ROW, whichever is greater

Side 7' from PL, Rear 25' from PL Parking Req'mt 2

Maximum Height 35' Special Conditions _____

CENSUS 11 TRAFFIC 46 ANNEX# _____

Modifications to this Planning Clearance must be approved, in writing, by the Community Development Department. The structure authorized by this application cannot be occupied until a final inspection has been completed and a Certificate of Occupancy has been issued, if applicable, by the Building Department (Section 305, Uniform Building Code).

I hereby acknowledge that I have read this application and the information is correct; I agree to comply with any and all codes, ordinances, laws, regulations or restrictions which apply to the project. I understand that failure to comply shall result in legal action, which may include but not necessarily be limited to non-use of the building(s).

Applicant Signature [Signature] Date 1 AUG 00

Department Approval [Signature] Date 8/3/00


Additional water and/or sewer tap fee(s) are required:	YES	NO	W/O No. <u>see attached</u>
Utility Accountir.g	<u>[Signature]</u>	Date <u>8/3/00</u>	<u>collected</u>

VALID FOR SIX MONTHS FROM DATE OF ISSUANCE (Section 9-3-2C Grand Junction Zoning & Development Code)

(White: Planning) (Yellow: Customer) (Pink: Building Department) (Goldenrod: Utility Accounting)

630

ROUND TABLE ROAD

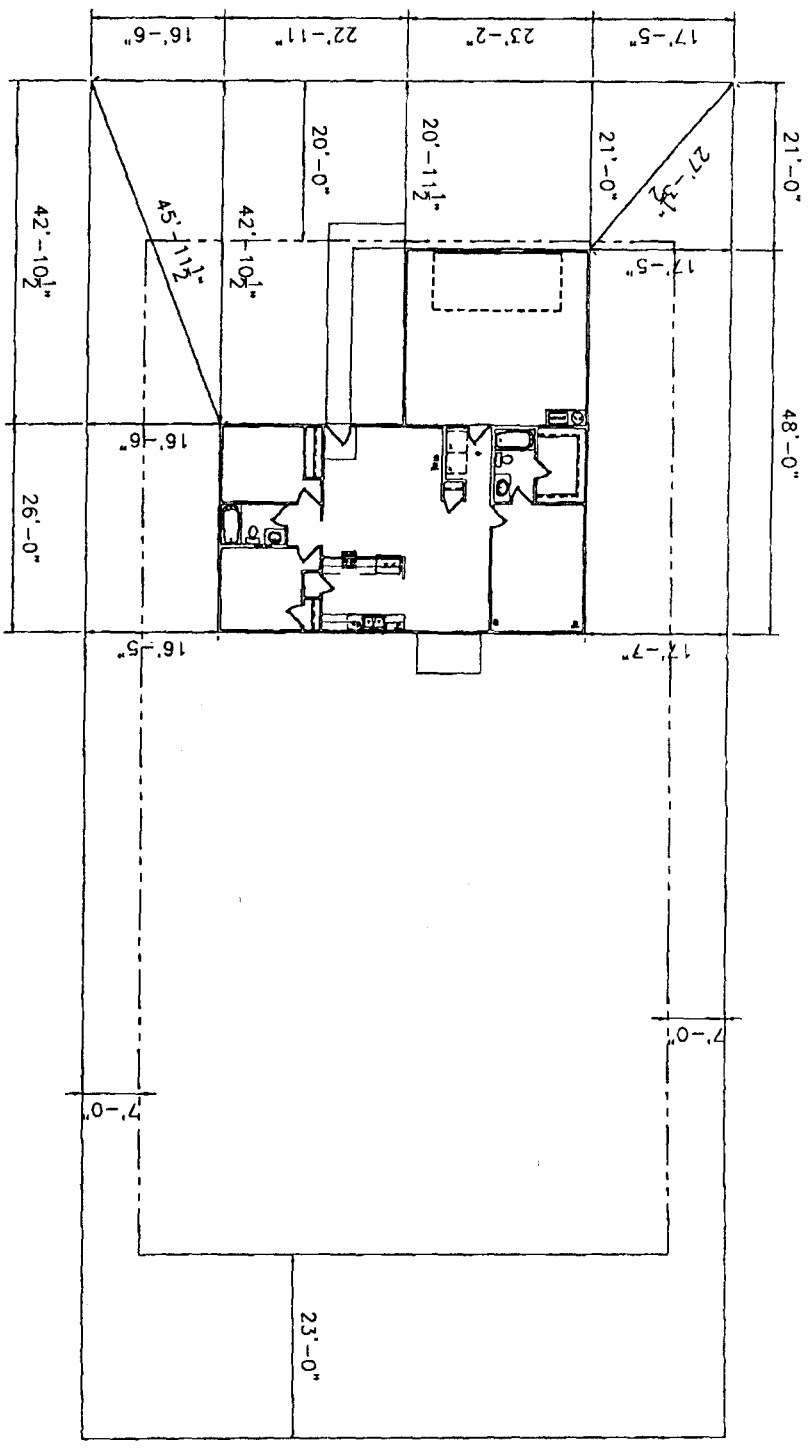

DAVE OK
SLC
8/3/00

MOUNTAIN VISTA
BLOCK 5
LOT 4
13556 SQ FT

ACCEPTED SLC 8/3/00
ANY CHANGE OF SETBACKS MUST BE
APPROVED BY THE CITY PLANNING
DEPT. IT IS THE APPLICANT'S
RESPONSIBILITY TO PROPERLY
LOCATE AND IDENTIFY EASEMENTS
AND PROPERTY LINES.

