

FEE \$	10 ⁰⁰
TCP \$	450 ⁰⁰
SIF \$	292 ⁰⁰

PLANNING CLEARANCE
 (Single Family Residential and Accessory Structures)
Community Development Department

BLDG PERMIT NO. 76272



Your Bridge to a Better Community

BLDG ADDRESS 639 Round Table Rd SQ. FT. OF PROPOSED BLDGS/ADDITION 1400 ϕ
 TAX SCHEDULE NO. 7943-043-00-196 SQ. FT. OF EXISTING BLDGS 0
 SUBDIVISION MT ALISTA TOTAL SQ. FT. OF EXISTING & PROPOSED 1400 ϕ
 FILING 1 BLK 6 LOT 1 NO. OF DWELLING UNITS:
 Before: 0 After: 1 this Construction
 (1) OWNER Lee Homes NO. OF BUILDINGS ON PARCEL
 Before: 0 After: 1 this Construction
 (1) ADDRESS 2755 N. Ave USE OF EXISTING BUILDINGS 0
 (1) TELEPHONE 248-4612 DESCRIPTION OF WORK & INTENDED USE new Residence
 (2) APPLICANT Lee Homes TYPE OF HOME PROPOSED:
 (2) ADDRESS 2755 N. Ave Site Built Manufactured Home (UBC)
 (2) TELEPHONE 248-4612 Manufactured Home (HUD)
 Other (please specify)

REQUIRED: One plot plan, on 8 1/2" x 11" paper, showing all existing & proposed structure location(s), parking, setbacks to all property lines, ingress/egress to the property, driveway location & width & all easements & rights-of-way which abut the parcel.

THIS SECTION TO BE COMPLETED BY COMMUNITY DEVELOPMENT DEPARTMENT STAFF

ZONE RSF-4 Maximum coverage of lot by structures 50%
 SETBACKS: Front 20' from property line (PL) Permanent Foundation Required: YES NO
 or from center of ROW, whichever is greater
 Side 7' from PL, Rear 25' from PL Parking Req'mt 2
 Maximum Height 35' Special Conditions
 CENSUS 11 TRAFFIC 466 ANNEX#

Modifications to this Planning Clearance must be approved, in writing, by the Community Development Department. The structure authorized by this application cannot be occupied until a final inspection has been completed and a Certificate of Occupancy has been issued, if applicable, by the Building Department (Section 305, Uniform Building Code).


I hereby acknowledge that I have read this application and the information is correct; I agree to comply with any and all codes, ordinances, laws, regulations or restrictions which apply to the project. I understand that failure to comply shall result in legal action, which may include but not necessarily be limited to non-use of the building(s).

Applicant Signature [Signature] Date 1 Aug 00
 Department Approval [Signature] Date 8/3/00

Additional water and/or sewer tap fee(s) are required:	YES <input checked="" type="checkbox"/>	NO <input type="checkbox"/>	W/O No. <u>See attached</u>
Utility Accountir.g	<u>[Signature]</u>	Date	<u>8/3/00</u>

VALID FOR SIX MONTHS FROM DATE OF ISSUANCE (Section 9-3-2C Grand Junction Zoning & Development Code)

(White: Planning) (Yellow: Customer) (Pink: Building Department) (Goldenrod: Utility Accounting)

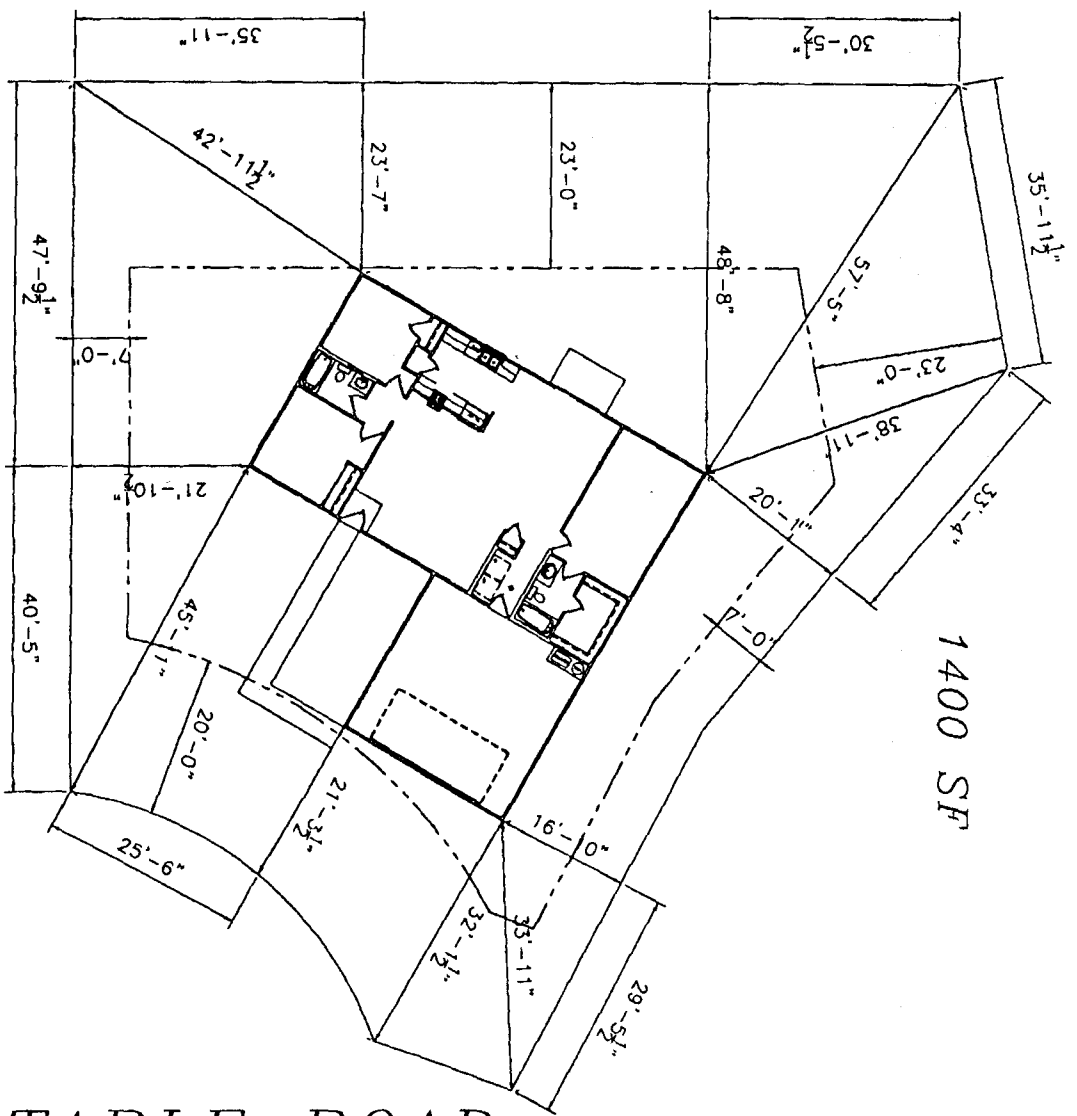

639

ROUND TABLE ROAD

MOUNTAIN VISTA

LOT 1

10317 SQ FT

BK 6

Drive OK
24
8/3/00

ACCEPTED SUC 8/3/00
ANY CHANGE OF SETBACKS MUST BE APPROVED BY THE CITY PLANNING DEPT. IT IS THE APPLICANT'S RESPONSIBILITY TO PROPERLY LOCATE AND IDENTIFY EASEMENTS AND PROPERTY LINES.