FEE \$ 10°C	BLDG PERMIT NO. 14151
TCP\$	
SIF\$ 29200 DI ANNI	
	idential and Accessory Structures)
Community D	Development Department
BLDG ADDRESS 2068 Stagecoach CT	- TAX SCHEDULE NO. 2947-151-40-013
SUBDIVISION Independence Reach	SQ. FT. OF PROPOSED BLDG(S)/ADDITION $1906^{\%}$
FILING BLK 2 LOT 13	SQ. FT. OF EXISTING BLDG(S)
(1) OWNER Norris Miller #501 Des Plains I	NO. OF DWELLING UNITS
(1) ADDRESS 711 River Rd 60016	NO. OF BLDGS ON PARCEL
(1) TELEPHONE (84) -299-577) RED HART Cor	
(2) APPLICANT Daniel R. Gearhert	USE OF EXISTING BLDGS
(2) ADDRESS 12.0 EX 00 C T (2)	
- ADURESS 2320 - E12 Kd. (5. J. SA)	Description of Work and Intended USE: New
(2) TELEPHONE <u>250-0822</u> REQUIRED: One plot plan, on 8 ½" x 11" paper, showing	$\frac{SO}{2} = \frac{1}{2} \frac$
(2) TELEPHONE <u>250-0822</u> REQUIRED: One plot plan, on 8 ½" x 11" paper, showing property lines, ingress/egress to the property, driveway THIS SECTION TO BE COMPLETED BY ZONE <u>PR 1.7</u> SETBACKS: Front <u>25</u> from property line (Pl or from center of ROW, whichever is greater	Reach STyle S/F Residence w/ 2 co a Tile and all existing & proposed structure location(s), parking, setbacks to all location & width & all easements & rights-of-way which abut the parcel. COMMUNITY DEVELOPMENT DEPARTMENT STAFF Maximum coverage of lot by structures 3500 PL) Parking Req'mt Special Conditions
⁽²⁾ TELEPHONE <u>250-0822</u> REQUIRED: One plot plan, on 8 ½" x 11" paper, showing property lines, ingress/egress to the property, driveway ■ THIS SECTION TO BE COMPLETED BY ZONE <u>PR 1.7</u> SETBACKS: Front <u>25</u> from property line (Pl	Reach STyle S/F Residence w/ 2 co a Tile and all existing & proposed structure location(s), parking, setbacks to all location & width & all easements & rights-of-way which abut the parcel. COMMUNITY DEVELOPMENT DEPARTMENT STAFF Maximum coverage of lot by structures 3500 PL) Parking Req'mt Special Conditions
⁽²⁾ TELEPHONE _2.50 - 0.8 2.2 REQUIRED: One plot plan, on 8 ½" x 11" paper, showing property lines, ingress/egress to the property, driveway THIS SECTION TO BE COMPLETED BY ZONE R_ 1.7 SETBACKS: Front from property line (Plot or from center of ROW, whichever is greater Side from PL Rear from Maximum Height 32 from the superior of the property line authorized by this application cannot be occur. Modifications to this Planning Clearance must be application cannot be occur. Occupancy has been issued, if applicable, by the Builded I hereby acknowledge that I have read this application app	Reack STyle S/F Residence w/ 2 certain and all existing & proposed structure location(s), parking, setbacks to all blocation & width & all easements & rights-of-way which abut the parcel. COMMUNITY DEVELOPMENT DEPARTMENT STAFF Maximum coverage of lot by structures 35% PL) Parking Req'mt Special Conditions n PL CENSUS 1402 TRAFFIC 88 ANNX# proved, in writing, by the Community Development Department. The upied until a final inspection has been completed and a Certificate of ding Department (Section 305, Uniform Building Code). and the information is correct; I agree to comply with any and all codes,
(2) TELEPHONE	Reach STyle S/F Residence w/ 2 celearty Ag all existing & proposed structure location(s), parking, setbacks to all location & width & all easements & rights-of-way which abut the parcel. COMMUNITY DEVELOPMENT DEPARTMENT STAFF Maximum coverage of lot by structures 35% PL Special Conditions Special Conditions Maximum, by the Community Development Department. The upied until a final inspection has been completed and a Certificate of ding Department (Section 305, Uniform Building Code). and the information is correct; I agree to comply with any and all codes, by to the project. I understand that failure to comply shall result in legal ed to non-use of the building(s).
⁽²⁾ TELEPHONE _2.50-08.22 REQUIRED: One plot plan, on 8 ½" x 11" paper, showing property lines, ingress/egress to the property, driveway THIS SECTION TO BE COMPLETED BY ZONE	$\frac{\text{Reach STyle S/F Residence w/2cc}{a Tr}{a Tr}{a Tr}{b a content of a location & width & all easements & rights-of-way which abut the parcel COMMUNITY DEVELOPMENT DEPARTMENT STAFF a Maximum coverage of lot by structures 35\%.$


VALID FOR SIX MONTHS FROM DATE OF ISSUANCE (Section 9-3-2C Grand Junction Zoning & Development Code)

(White: Planning)

(Yellow: Customer)

(Pink: Building Department)

(Goldenrod: Utility Accounting)

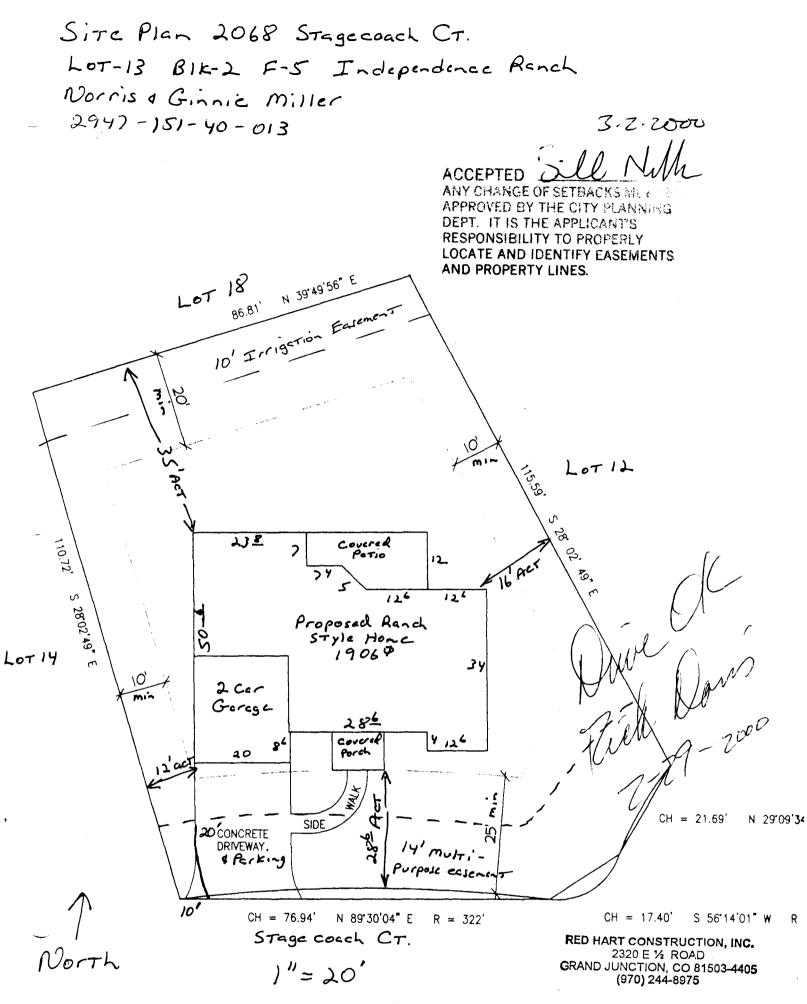

the start of the

.

ан са Сан са