

FEE \$	10
TCP \$	450
IF \$	292

PLANNING CLEARANCE
 (Single Family Residential and Accessory Structures)
Community Development Department

BLDG PERMIT NO. 75665



EX

Your Bridge to a Better Community

BLDG ADDRESS 622 SUNCREST CT SQ. FT. OF PROPOSED BLDGS/ADDITION 1288 φ
 TAX SCHEDULE NO. 2943-043-00196 SQ. FT. OF EXISTING BLDGS 0
 SUBDIVISION MT. VISTA TOTAL SQ. FT. OF EXISTING & PROPOSED 1288 φ
 FILING 1 BLK 2 LOT 8 NO. OF DWELLING UNITS:
 Before: 0 After: 1 this Construction
 (1) OWNER Lee Homes NO. OF BUILDINGS ON PARCEL
 Before: 0 After: 1 this Construction
 (1) ADDRESS 2755 N. Ave USE OF EXISTING BUILDINGS 0
 (1) TELEPHONE 248-4612 DESCRIPTION OF WORK & INTENDED USE New Residence
 (2) APPLICANT Lee Homes TYPE OF HOME PROPOSED:
 (2) ADDRESS 2755 N. Ave Site Built Manufactured Home (UBC)
 (2) TELEPHONE 248-4612 Manufactured Home (HUD)
 Other (please specify) _____

REQUIRED: One plot plan, on 8 1/2" x 11" paper, showing all existing & proposed structure location(s), parking, setbacks to all property lines, ingress/egress to the property, driveway location & width & all easements & rights-of-way which abut the parcel.

THIS SECTION TO BE COMPLETED BY COMMUNITY DEVELOPMENT DEPARTMENT STAFF

ZONE R8F4 Maximum coverage of lot by structures _____
 SETBACKS: Front 20' from property line (PL) Permanent Foundation Required: YES X NO _____
 or _____ from center of ROW, whichever is greater
 Side 7' from PL, Rear 25' from PL Parking Req'mt 2
 Maximum Height 35' Special Conditions _____
 CENSUS 11 TRAFFIC 46 ANNEX# _____

Modifications to this Planning Clearance must be approved, in writing, by the Community Development Department. The structure authorized by this application cannot be occupied until a final inspection has been completed and a Certificate of Occupancy has been issued, if applicable, by the Building Department (Section 305, Uniform Building Code).

I hereby acknowledge that I have read this application and the information is correct; I agree to comply with any and all codes, ordinances, laws, regulations or restrictions which apply to the project. I understand that failure to comply shall result in legal action, which may include but not necessarily be limited to non-use of the building(s).

Applicant Signature [Signature] Date 16 JUN 00
 Department Approval Ronnie Edwards Date 6/19/00

Additional water and/or sewer tap fee(s) are required:	YES <input checked="" type="checkbox"/>	NO <input type="checkbox"/>	W/O No. <u>13188</u>
Utility Accounting <u>[Signature]</u>	Date <u>6/19/00</u>		

VALID FOR SIX MONTHS FROM DATE OF ISSUANCE (Section 9-3-2C Grand Junction Zoning & Development Code)

(White: Planning) (Yellow: Customer) (Pink: Building Department) (Goldenrod: Utility Accounting)


NOTICE

1. IT IS THE RESPONSIBILITY OF THE BUILDER OR OWNER TO VERIFY DETAILS AND DIMENSIONS PRIOR TO CONSTRUCTION

MOUNTAIN VISTA
1288 SF 2 CAR
LOT 8 - BLOCK 2

DRIVE OK
SH
6/19/00

ACCEPTED
ANY CHANGE OF SETBACKS MUST
APPROVED BY THE CITY PLANNING
DEPT. IT IS THE APPLICANT'S
RESPONSIBILITY TO PROPERLY
LOCATE AND IDENTIFY EASEMENTS
AND PROPERTY LINES.
Bonnie 6/19/00

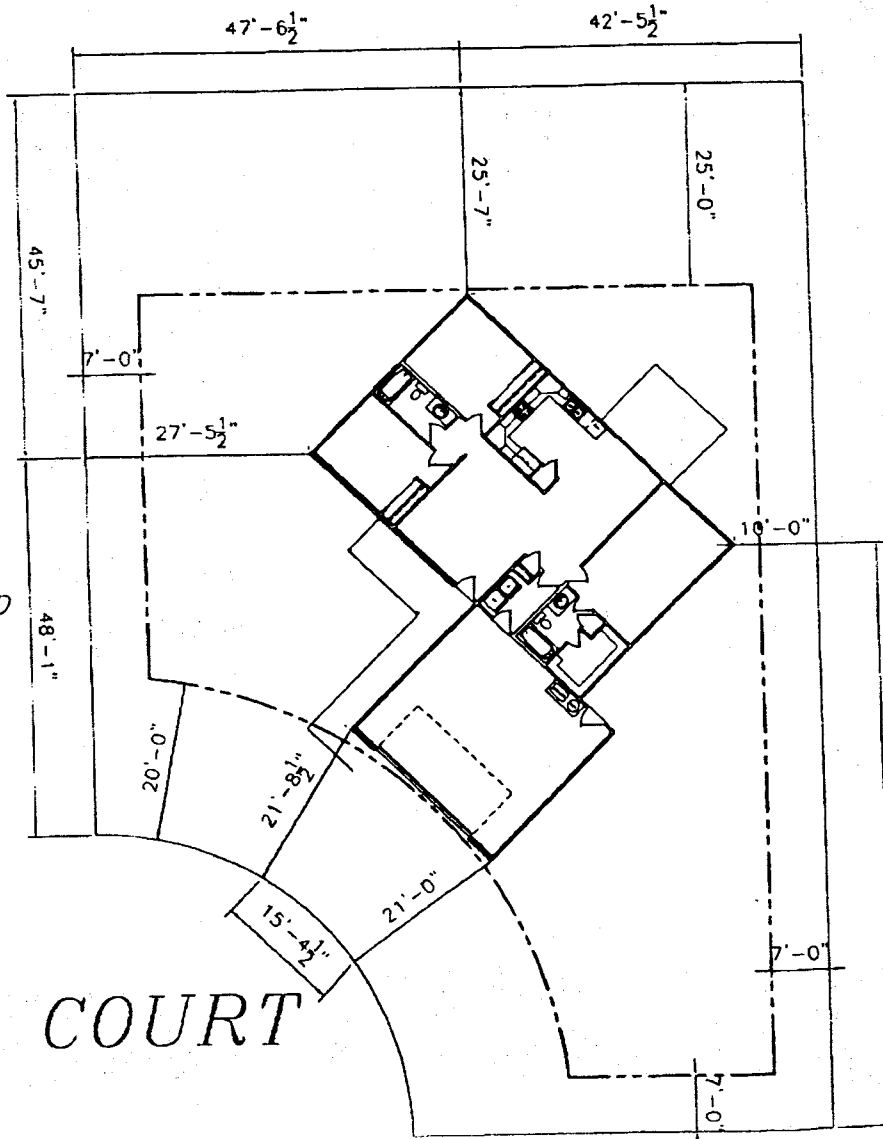

622 SUNCREST COURT

