

FEE \$	10 -
TCP \$	450 -
IF \$	292 -

# PLANNING CLEARANCE

(Single Family Residential and Accessory Structures)  
**Community Development Department**

BLDG PERMIT NO. 75768



EX

Your Bridge to a Better Community

BLDG ADDRESS 3030 VIN-ROSE WAY SQ. FT. OF PROPOSED BLDGS/ADDITION 1196  $\phi$

TAX SCHEDULE NO. 2943-043 - 00196 SQ. FT. OF EXISTING BLDGS 2

SUBDIVISION MT VISTA TOTAL SQ. FT. OF EXISTING & PROPOSED 1196  $\phi$

FILING 1 BLK 4 LOT 1 NO. OF DWELLING UNITS:  
 Before: 2 After: 1 this Construction

(1) OWNER Lee Jones NO. OF BUILDINGS ON PARCEL  
 Before: 2 After: 1 this Construction

(1) ADDRESS 2755 N. AVE USE OF EXISTING BUILDINGS 2

(1) TELEPHONE 248-4612 DESCRIPTION OF WORK & INTENDED USE New Residence

(2) APPLICANT Lee Jones TYPE OF HOME PROPOSED:  
 Site Built  Manufactured Home (UBC)  
 Manufactured Home (HUD)  
 Other (please specify) PATH

(2) ADDRESS 2755 N. AVE

(2) TELEPHONE 248-4612

**REQUIRED: One plot plan, on 8 1/2" x 11" paper, showing all existing & proposed structure location(s), parking, setbacks to all property lines, ingress/egress to the property, driveway location & width & all easements & rights-of-way which abut the parcel.**

**THIS SECTION TO BE COMPLETED BY COMMUNITY DEVELOPMENT DEPARTMENT STAFF**

ZONE RSF-4 Maximum coverage of lot by structures 50%

SETBACKS: Front 20' from property line (PL) Permanent Foundation Required: YES  NO   
 or \_\_\_\_\_ from center of ROW, whichever is greater

Side 7' from PL, Rear 25' from PL Parking Req'mt 2

Maximum Height 35' Special Conditions \_\_\_\_\_

CENSUS 11 TRAFFIC 46 ANNEX# \_\_\_\_\_

Modifications to this Planning Clearance must be approved, in writing, by the Community Development Department. The structure authorized by this application cannot be occupied until a final inspection has been completed and a Certificate of Occupancy has been issued, if applicable, by the Building Department (Section 305, Uniform Building Code).

I hereby acknowledge that I have read this application and the information is correct; I agree to comply with any and all codes, ordinances, laws, regulations or restrictions which apply to the project. I understand that failure to comply shall result in legal action, which may include but not necessarily be limited to non-use of the building(s).

Applicant Signature [Signature] Date 27 Jun 00

Department Approval C. Faye Gibson Date 6-28-00

Additional water and/or sewer tap fee(s) are required:	YES <input checked="" type="checkbox"/>	NO <input type="checkbox"/>	W/O No. <u>13205</u>
Utility Accounting	<u>[Signature]</u>		Date <u>6/28/00</u>

VALID FOR SIX MONTHS FROM DATE OF ISSUANCE (Section 9-3-2C Grand Junction Zoning & Development Code)

(White: Planning) (Yellow: Customer) (Pink: Building Department) (Goldenrod: Utility Accounting)


NOTICE  
I, AS THE RESPONSIBILITY OF THE BUILDER OR OWNER TO VERIFY SETBACKS  
AND PROVISIONS PRIOR TO CONSTRUCTION.

MOUNTAIN VISTA  
LOT 1 BLOCK 4  
9451 SQ FT

1196 SF 2 CAR

DRIVE OK  
GH  
6/27/00

ACCEPTED *C. J. Taylor*  
ANY CHANGE OF SETBACKS MUST BE  
APPROVED BY THE CITY PLANNING  
DEPT. IT IS THE APPLICANT'S  
RESPONSIBILITY TO PROPERLY  
LOCATE AND IDENTIFY EASEMENTS  
AND PROPERTY LINES.

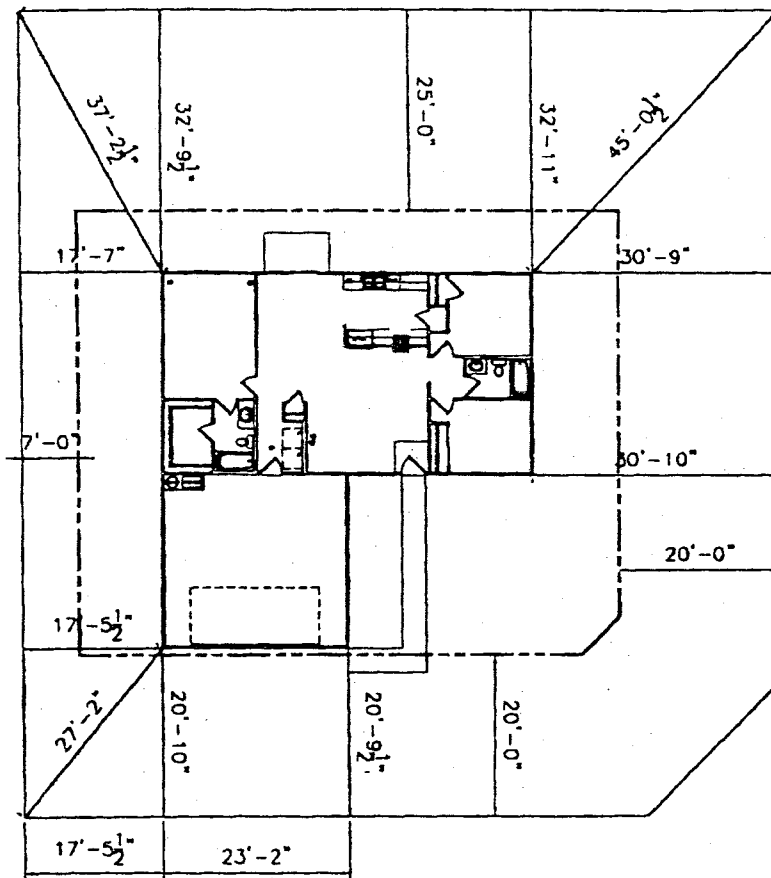

ROUND TABLE ROAD

3030 VIN-ROSE WAY