

FEE \$	10.00
TCP \$	400.00
SIF \$	292.00

**PLANNING CLEARANCE**  
(Single Family Residential and Accessory Structures)  
**Community Development Department**

BLDG PERMIT NO. 79362



Your Bridge to a Better Community

BLDG ADDRESS 220 DREAM ST. SQ. FT. OF PROPOSED BLDGS/ADDITION ~~1399~~ 1399  
UNIT B  
TAX SCHEDULE NO. 2943-294-19-014 SQ. FT. OF EXISTING BLDGS NA  
SUBDIVISION CHIPETA PINES TOTAL SQ. FT. OF EXISTING & PROPOSED ~~1399~~ 1399  
FILING 1 BLK 4 LOT 13 NO. OF DWELLING UNITS:  
Before: 0 After: 1 this Construction  
(1) OWNER JUST COMPANIES, INC NO. OF BUILDINGS ON PARCEL  
Before: 0 After: 1 this Construction  
(1) ADDRESS 826 2 1/2 ROAD USE OF EXISTING BUILDINGS NA  
(1) TELEPHONE (970) 245-9316 DESCRIPTION OF WORK & INTENDED USE NEW SINGLE FAMILY TOWNHOUSE  
(2) APPLICANT JUST COMPANIES, INC TYPE OF HOME PROPOSED:  
(2) ADDRESS 826 2 1/2 RD  Site Built  Manufactured Home (UBC)  
 Manufactured Home (HUD)  
(2) TELEPHONE (970) 245-9316  Other (please specify) \_\_\_\_\_

**REQUIRED: One plot plan, on 8 1/2" x 11" paper, showing all existing & proposed structure location(s), parking, setbacks to all property lines, ingress/egress to the property, driveway location & width & all easements & rights-of-way which abut the parcel.**

**THIS SECTION TO BE COMPLETED BY COMMUNITY DEVELOPMENT DEPARTMENT STAFF**

ZONE PD Maximum coverage of lot by structures uldgenvelope  
SETBACKS: Front \_\_\_\_\_ from property line (PL) Permanent Foundation Required: YES  NO \_\_\_\_\_  
or \_\_\_\_\_ from center of ROW, whichever is greater  
Side \_\_\_\_\_ from PL, Rear attached Parking Req't 2  
plot Special Conditions Ⓢ  
Maximum Height \_\_\_\_\_ CENSUS 13 TRAFFIC 87 ANNEX# \_\_\_\_\_

Modifications to this Planning Clearance must be approved, in writing, by the Community Development Department. The structure authorized by this application cannot be occupied until a final inspection has been completed and a Certificate of Occupancy has been issued, if applicable, by the Building Department (Section 305, Uniform Building Code).

I hereby acknowledge that I have read this application and the information is correct; I agree to comply with any and all codes, ordinances, laws, regulations or restrictions which apply to the project. I understand that failure to comply shall result in legal action, which may include but not necessarily be limited to non-use of the building(s).


Applicant Signature [Signature] Date 4-12-01  
Department Approval [Signature] Date 4/12/01

Additional water and/or sewer tap fee(s) are required:	YES <input checked="" type="checkbox"/>	NO	W/O No. <u>13899</u>
Utility Accounting	<u>Khatt</u>	Date	<u>4/12/01</u>

VALID FOR SIX MONTHS FROM DATE OF ISSUANCE (Section 9-3-2C Grand Junction Zoning & Development Code)

(White: Planning) (Yellow: Customer) (Pink: Building Department) (Goldenrod: Utility Accounting)

NORTH

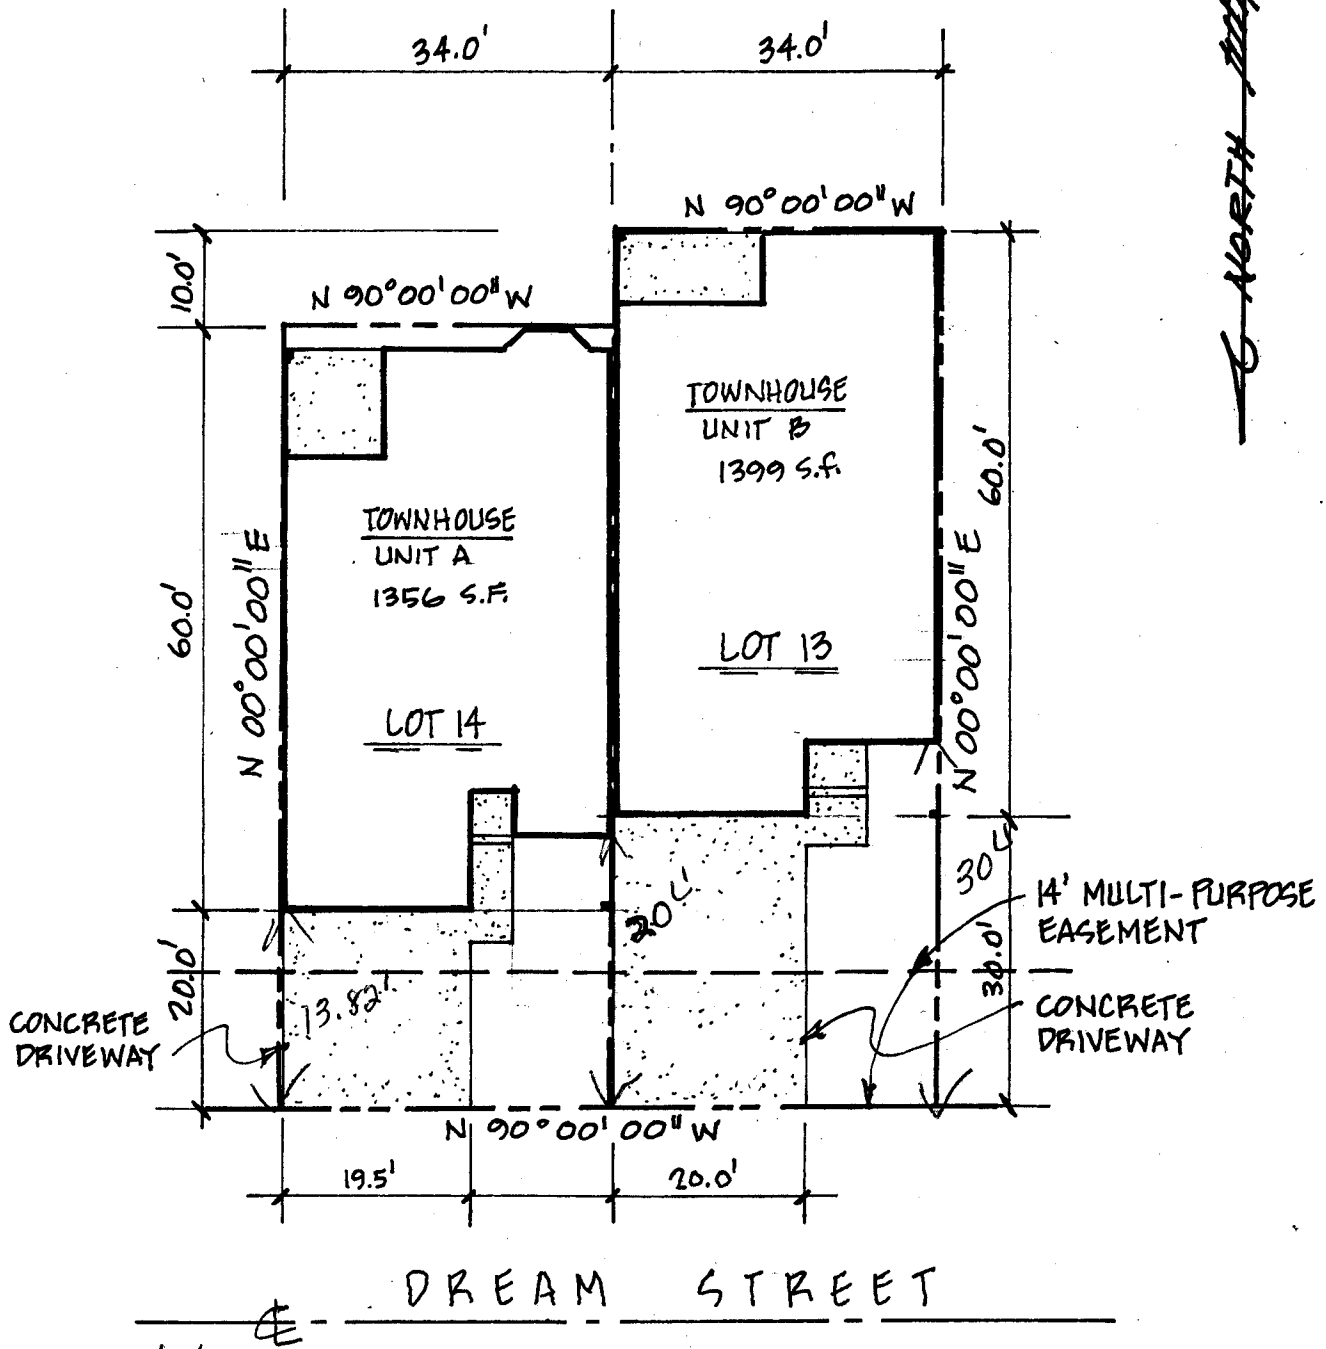

ACCEPTED *C. Jaye Johnson* 4/10/01  
 ANY CHANGE OF SETBACKS MUST BE APPROVED BY THE CITY PLANNING DEPT. IT IS THE APPLICANT'S RESPONSIBILITY TO PROPERLY LOCATE AND IDENTIFY EASEMENTS AND PROPERTY LINES.

220 DREAM STREET  
CHIPETA PINES SUBDIVISION  
BLOCK 4 LOT 14 & 13  
 SCALE 1" = 20'

DRIVE OK  
 DML  
 4/10/01