

FEE \$	10 ⁻
TCP \$	500 ⁻
SIF \$	298 ⁻

PLANNING CLEARANCE
 (Single Family Residential and Accessory Structures)
Community Development Department

BLDG PERMIT NO. 79097



Your Bridge to a Better Community

BLDG ADDRESS 2812 ELORA CT SQ. FT. OF PROPOSED BLDGS/ADDITION 1600

TAX SCHEDULE NO. 2943-062-34-005 SQ. FT. OF EXISTING BLDGS 0

SUBDIVISION GRAND VIEW TOTAL SQ. FT. OF EXISTING & PROPOSED 1600

FILING 4 BLK 2 LOT 5 NO. OF DWELLING UNITS:
 Before: 0 After: 1 this Construction

(1) OWNER SKOTTON CONSTRUCTION INC NO. OF BUILDINGS ON PARCEL
 Before: 0 After: 1 this Construction

(1) ADDRESS PO Box 4247 USE OF EXISTING BUILDINGS N/A

(1) TELEPHONE 245-9008 DESCRIPTION OF WORK & INTENDED USE NEW HOME

(2) APPLICANT SAMS TYPE OF HOME PROPOSED:
 Site Built Manufactured Home (UBC)
 Manufactured Home (HUD)
 Other (please specify) _____

(2) ADDRESS _____

(2) TELEPHONE _____

REQUIRED: One plot plan, on 8 1/2" x 11" paper, showing all existing & proposed structure location(s), parking, setbacks to all property lines, ingress/egress to the property, driveway location & width & all easements & rights-of-way which abut the parcel.

THIS SECTION TO BE COMPLETED BY COMMUNITY DEVELOPMENT DEPARTMENT STAFF

ZONE RMF-5 Maximum coverage of lot by structures 60%

SETBACKS: Front 20 from property line (PL) Permanent Foundation Required: YES NO
 or _____ from center of ROW, whichever is greater

Side 5' from PL, Rear 25' from PL Parking Req'mt 2

Maximum Height 35' Special Conditions _____

CENSUS 10 TRAFFIC 22 ANN# _____

Modifications to this Planning Clearance must be approved, in writing, by the Community Development Department. The structure authorized by this application cannot be occupied until a final inspection has been completed and a Certificate of Occupancy has been issued, if applicable, by the Building Department (Section 305, Uniform Building Code).

I hereby acknowledge that I have read this application and the information is correct; I agree to comply with any and all codes, ordinances, laws, regulations or restrictions which apply to the project. I understand that failure to comply shall result in legal action, which may include but not necessarily be limited to non-use of the building(s).


Applicant Signature [Signature] Date 3/19/07

Department Approval [Signature] Date 03/22/01

Additional water and/or sewer tap fee(s) are required:	YES <input checked="" type="checkbox"/>	NO <input type="checkbox"/>	W/G No. <u>13834</u>
Utility Accounting	<u>AM Cole</u>	Date	<u>3/22/01</u>

VALID FOR SIX MONTHS FROM DATE OF ISSUANCE (Section 9-3-2C Grand Junction Zoning & Development Code)

(White: Planning) (Yellow: Customer) (Pink: Building Department) (Goldenrod: Utility Accounting)

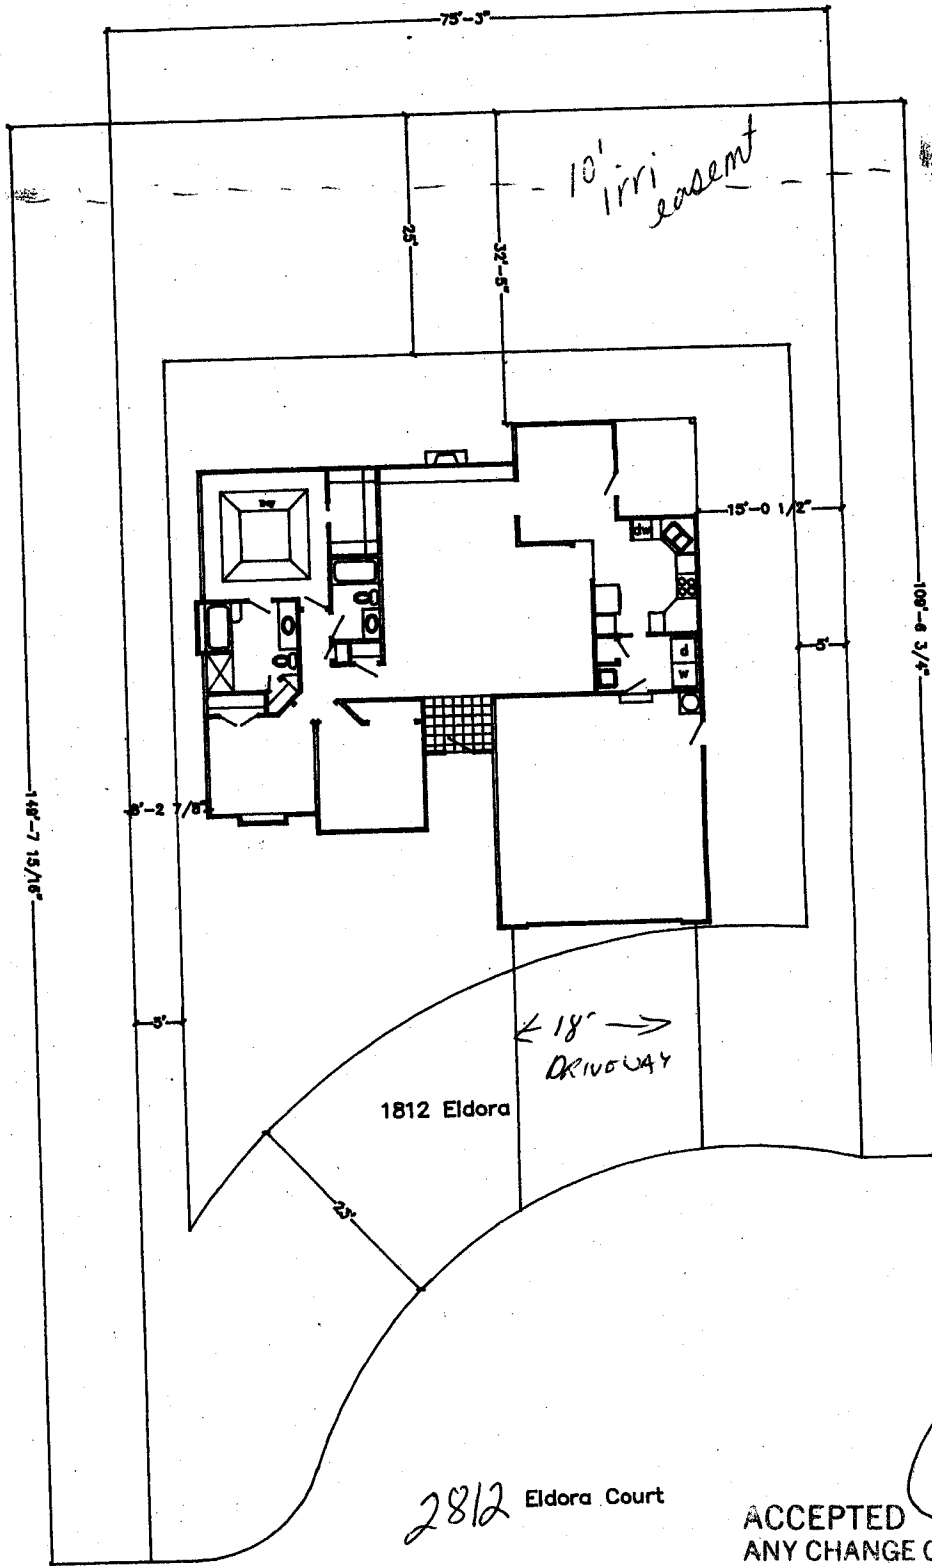

3/20/01
 DR
 DRIVE OK

[Signature]

ACCEPTED
 ANY CHANGE OF SETBACKS MUST BE
 APPROVED BY THE CITY PLANNING
 DEPT. IT IS THE APPLICANT'S
 RESPONSIBILITY TO PROPERLY
 LOCATE AND IDENTIFY EASEMENTS
 AND PROPERTY LINES.