FEE\$	10.00
TCP\$	Ð
SIF\$	292.00

(White: Planning)

(Yellow: Customer)

PLANNING CLEARANCE

ructures)

BLDG PERM	IT NO.	79/112	

(Single Family Residential and Accessory Structures)

Community Development Department




Your Bridge to a Better Community

(Goldenrod: Utility Accounting)

BLDG ADDRESS 655 Fair Loud Way	SQ. FT. OF PROPOSED BLDGS/ADDITION 448
TAX SCHEDULE NO. 2943-042-66-807	SQ. FT. OF EXISTING BLDGS
SUBDIVISION Faircloua	TOTAL SQ. FT. OF EXISTING & PROPOSED 1448
FILING 2 BLK L LOT LOT LOT SWING BLK LOT	NO. OF DWELLING UNITS: Before:
property lines, ingress/egress to the property, driveway lo	all existing & proposed structure location(s), parking, setbacks to all cation & width & all easements & rights-of-way which abut the parcel. OMMUNITY DEVELOPMENT DEPARTMENT STAFF
SETBACKS: Front $23'$ from property line (PL) or from center of ROW, whichever is greater Side $5'$ from PL, Rear $25'$ from P Maximum Height $32'$	Parking Req'mt
structure authorized by this application cannot be occup Occupancy has been issued, if applicable, by the Buildin I hereby acknowledge that I have read this application and	I the information is correct; I agree to comply with any and all codes, to the project. I understand that failure to comply shall result in legal to non-use of the building(s). The GNH Date 4/5/0/ Date 4/10/0/ YES NO W/O No. 13892
- M Diville	Section 9-3-2C Grand Junction Zoning & Development Code)

(Pink: Building Department)

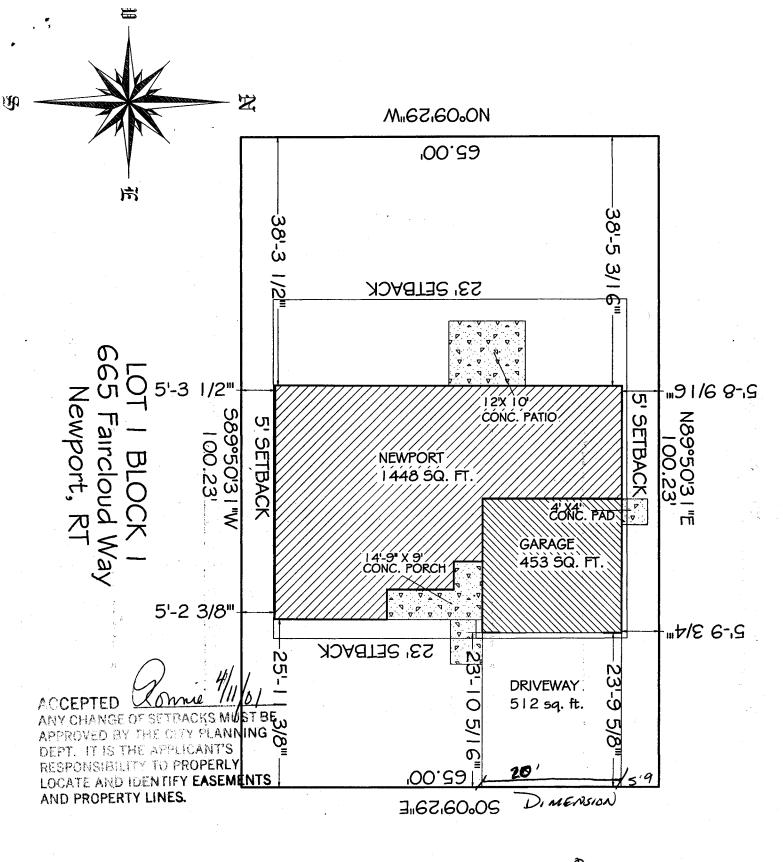

FAIRCLOUD WAY

DRIVE OK DRIVE OK 3/23/0 4/5/0/



529 25 1/2 Road, Suite 8-101 Grand Junction, Colorado 81505 (970) 241-7700 • Fax (970) 241-7783

E-mail: wct@gj.net

Website: www.westerncolorado.com

April 2, 2001 WCT # 200901

Great New Homes, Ltd. 3032 I-70 Business Loop Grand Junction, Colorado 81504

Attn: Pat Mullennix

Development Superintendent

Subject: 665 Faircloud Way

Grand Junction, Colorado

Faircloud Subdivision, Filings II & III

At your request, on March 30, 2001, we observed the soil conditions in the proposed foundation excavation at the above referenced address. The purpose of our work was to determine if fill of an unknown nature, or if soft virgin soils are present below the proposed footings. This is a requirement of City of Grand Junction Planning Commission, Final Decision FPP-1999-280.

At the time of our visit, the foundation area had been staked for excavation in preparation for a monolithic slab.

Two test holes were hand-augered within the proposed building location. Holes were three to four feet in depth and located on the East and West sides of the excavation.

The soils were non-expansive, slightly moist, and comprised of native light brown silty clay with sand and gypsum. Soil type and gradation was consistent throughout the augered depth.

Our visual observations indicated that no unknown fill or soft soil conditions are present. The staked area should be excavated and wheel-rolled prior to forming and pouring the foundation.

If you have any questions or if we may be of further assistance, please do not hesitate to contact us.

Respectfully Submitted: WESTERN COLORADO TESTING, INC.

" Juliano

Michael J. Weigand, PE

Msb:jobs/2009L0402a