


ACCEPTED
 ANY CHANGE OF SETBACKS MUST BE
 APPROVED BY THE CITY PLANNING
 DEPT. IT IS THE APPLICANT'S
 RESPONSIBILITY TO PROPERLY
 LOCATE AND IDENTIFY EASEMENTS
 AND PROPERTY LINES.

Miska Magor 4/18/01

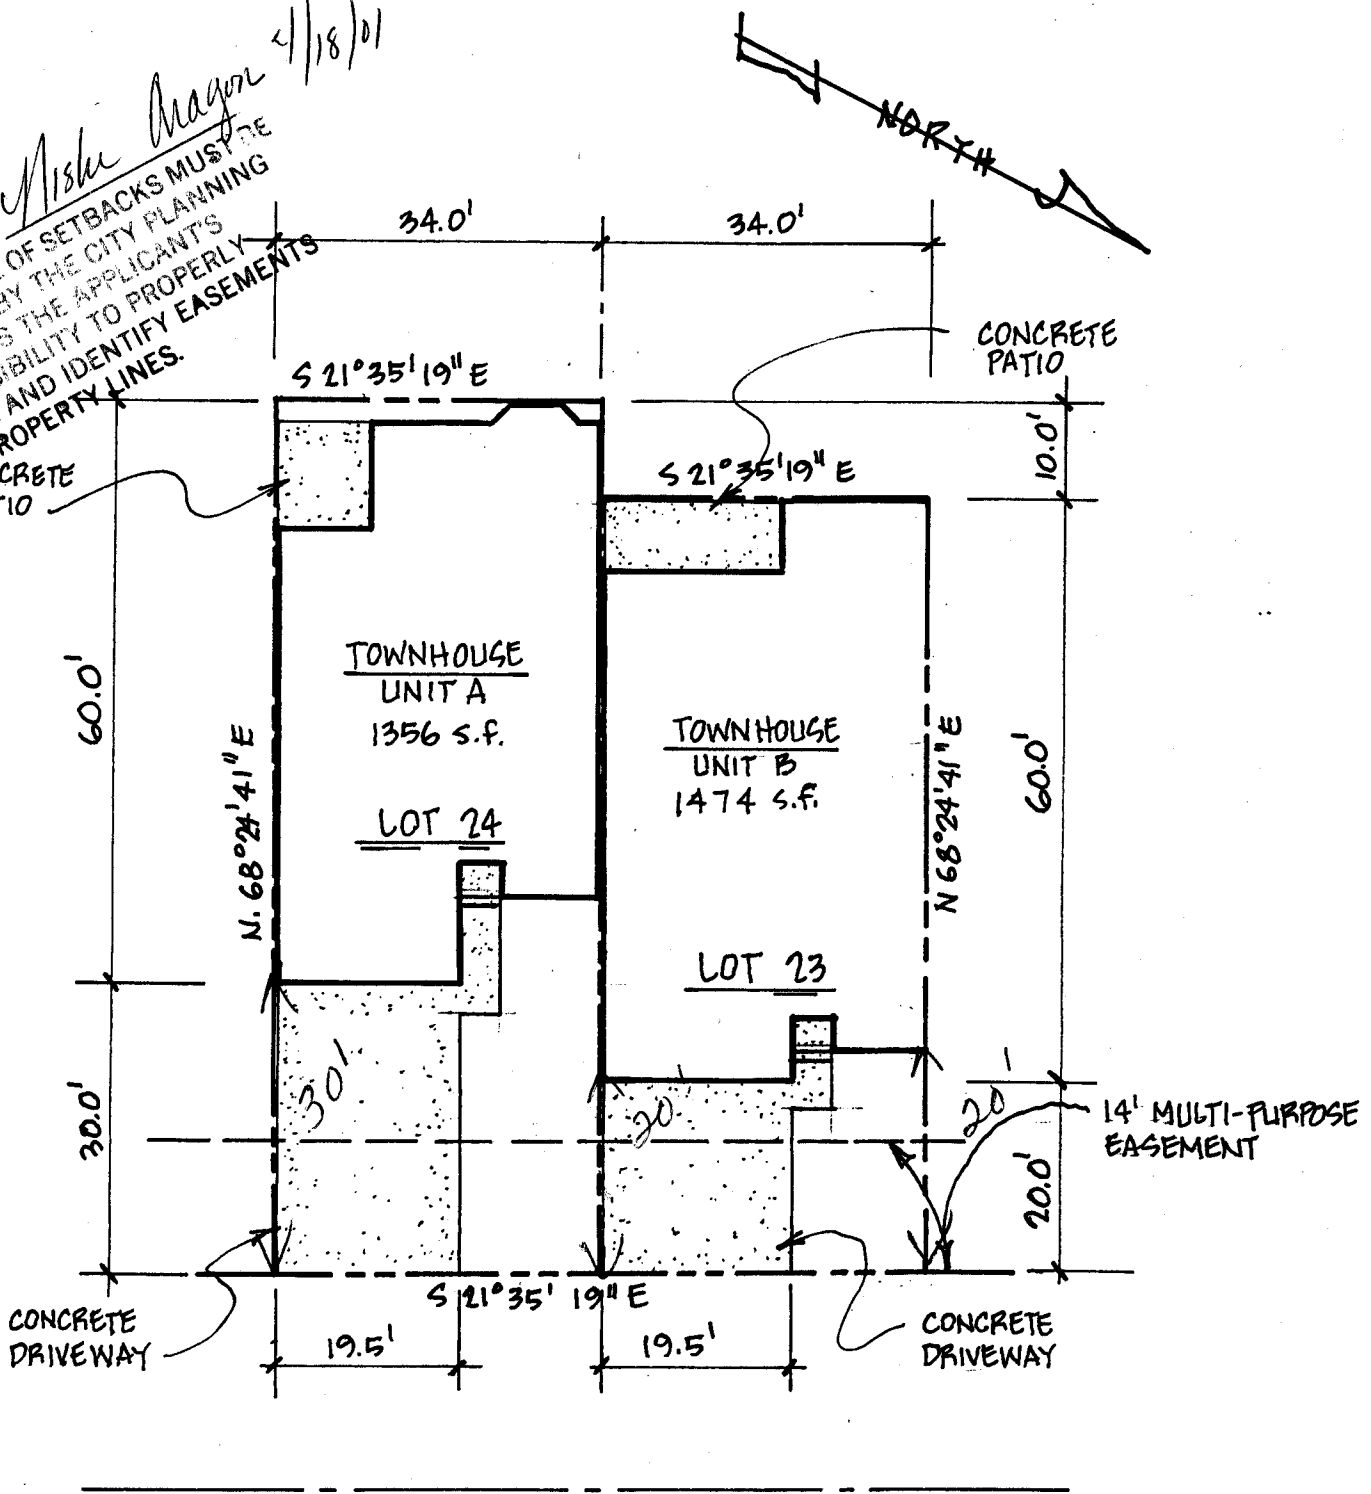

209 FRONTIER STREET
CHIPETA PINES SUBDIVISION
BLOCK 2 LOT 24 & 23
 SCALE 1" = 20'

DRIVE OK
 ORL
 4/10/01