

FEE \$	10.00
TCP \$	0
SIF \$	292.00

PLANNING CLEARANCE
 (Single Family Residential and Accessory Structures)
Community Development Department

BLDG PERMIT NO. 80113



Your Bridge to a Better Community

BLDG ADDRESS 655 CARRETT WAY SQ. FT. OF PROPOSED BLDGS/ADDITION 1644

TAX SCHEDULE NO. 2945-032-00-166 SQ. FT. OF EXISTING BLDGS 2

SUBDIVISION Carrett Estates TOTAL SQ. FT. OF EXISTING & PROPOSED 1644

FILING 1 BLK 1 LOT 8 NO. OF DWELLING UNITS:
 Before: 2 After: 1 this Construction

(1) OWNER Lee Homes NO. OF BUILDINGS ON PARCEL
 Before: 2 After: 1 this Construction

(1) ADDRESS 655 CROSSING USE OF EXISTING BUILDINGS X TB

(1) TELEPHONE 234-1091 DESCRIPTION OF WORK & INTENDED USE new residence

(2) APPLICANT [Signature] TYPE OF HOME PROPOSED:
 Site Built Manufactured Home (UBC)
 Manufactured Home (HUD)
 Other (please specify) _____

(2) ADDRESS _____

(2) TELEPHONE _____

PAYD
MAY 23 2001

REQUIRED: One plot plan, on 8 1/2" x 11" paper, showing all existing & proposed structure location(s), parking, setbacks to all property lines, ingress/egress to the property, driveway location & width & all easements & rights-of-way which abut the parcel.

THIS SECTION TO BE COMPLETED BY COMMUNITY DEVELOPMENT DEPARTMENT STAFF

ZONE BMF-8 Maximum coverage of lot by structures 70%

SETBACKS: Front 20' from property line (PL) Permanent Foundation Required: YES X NO _____
 or _____ from center of ROW, whichever is greater

Side 5' from PL, Rear 10' from PL Parking Req'mt 2

Maximum Height 35' Special Conditions _____

CENSUS 10 TRAFFIC 19 ANNX# _____

Modifications to this Planning Clearance must be approved, in writing, by the Community Development Department. The structure authorized by this application cannot be occupied until a final inspection has been completed and a Certificate of Occupancy has been issued, if applicable, by the Building Department (Section 305, Uniform Building Code).

I hereby acknowledge that I have read this application and the information is correct; I agree to comply with any and all codes, ordinances, laws, regulations or restrictions which apply to the project. I understand that failure to comply shall result in legal action, which may include but not necessarily be limited to non-use of the building(s).

Applicant Signature [Signature] Date 23 MAY 01

Department Approval [Signature] Date 5/24/01

Additional water and/or sewer tap fee(s) are required:	YES <input checked="" type="checkbox"/>	NO <input type="checkbox"/>	W/O No. <u>13980</u>
Utility Accounting	<u>T. Bensley</u>		Date <u>5/24/01</u>

VALID FOR SIX MONTHS FROM DATE OF ISSUANCE (Section 9-3-2C Grand Junction Zoning & Development Code)

(White: Planning) (Yellow: Customer) (Pink: Building Department) (Goldenrod: Utility Accounting)


GARRETT ESTATES SUBDIVISION

BLCK 1

LOT 8

8213 SQ. FT.

25 ROAD

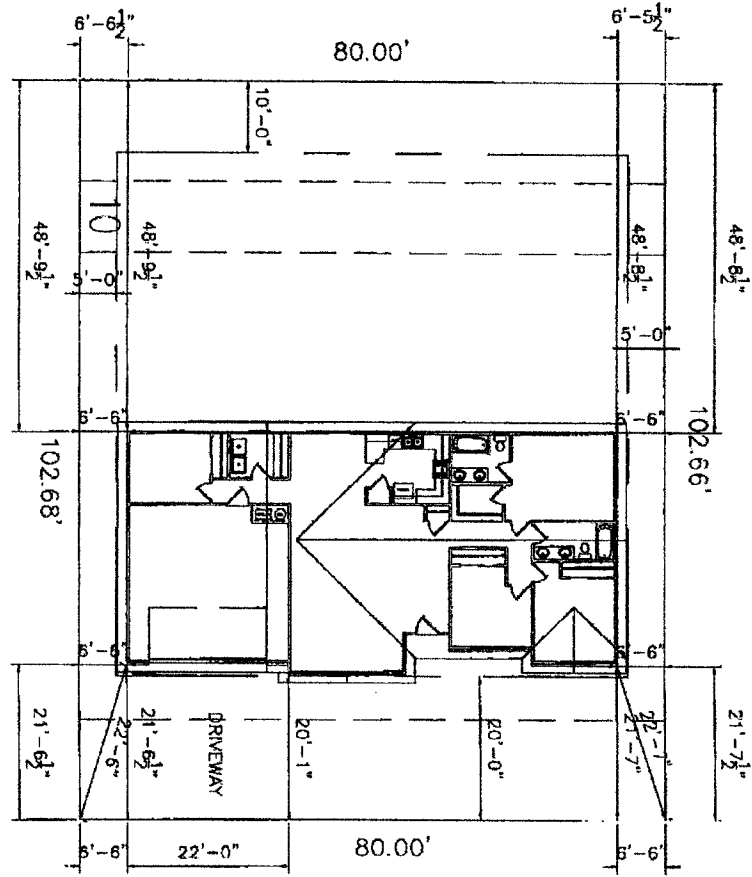

665 GARRETT WAY

DRIVE OK
DMD
5/23/01

5/24/01
ACCEPTED *C. Lynn Robinson*
ANY CHANGE OF SETBACKS MUST BE APPROVED BY THE CITY PLANNING DEPT. IT IS THE APPLICANT'S RESPONSIBILITY TO PROPERLY LOCATE AND IDENTIFY EASEMENTS AND PROPERTY LINES.


GARRETT ESTATES SUBDIVISION

B L O C K 1

LOT 8

8213 SQ. FT.

25 ROAD

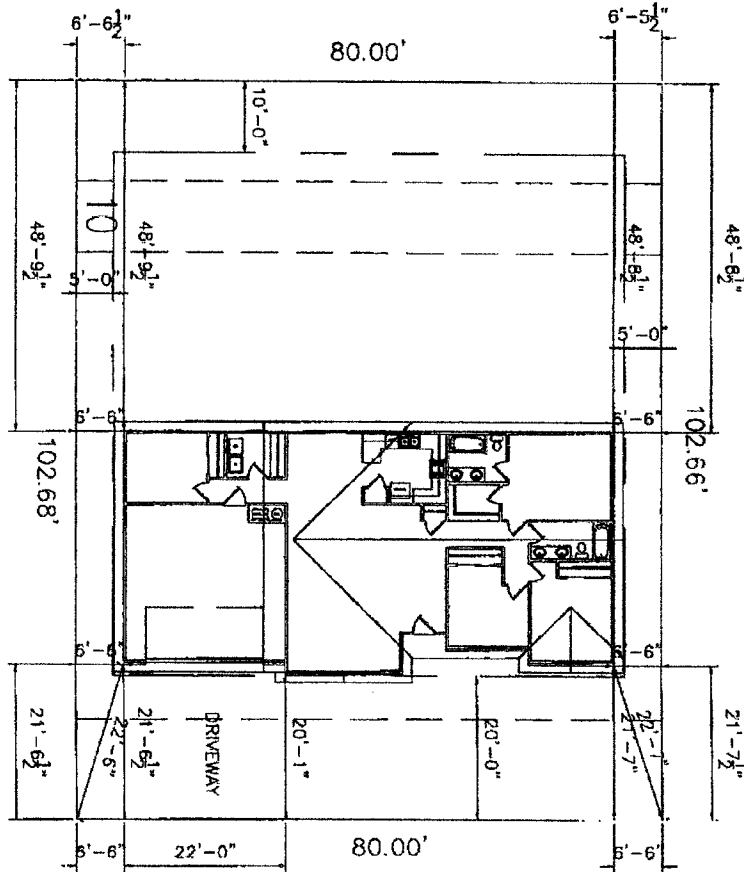

665 GARRETT WAY

DRIVE OK
OK
5/23/01

5/24/01
ACCEPTED *C. Gaye Robinson*
ANY CHANGE OF SETBACKS MUST BE APPROVED BY THE CITY PLANNING DEPT. IT IS THE APPLICANT'S RESPONSIBILITY TO PROPERLY LOCATE AND IDENTIFY EASEMENTS AND PROPERTY LINES.