

FEE \$	10.00
TCP \$	500.00
SIF \$	292.00

**PLANNING CLEARANCE**  
 (Single Family Residential and Accessory Structures)  
**Community Development Department**

BLDG PERMIT NO. 81209



Your Bridge to a Better Community

BLDG ADDRESS 661 Grand View Dr SQ. FT. OF PROPOSED BLDGS/ADDITION 2,000  
 TAX SCHEDULE NO. 2943-062-33-005 SQ. FT. OF EXISTING BLDGS 0  
 SUBDIVISION GRAND VIEW S4S TOTAL SQ. FT. OF EXISTING & PROPOSED 2,000  
 FILING 4 BLK 1 LOT 5 NO. OF DWELLING UNITS:  
 Before: 0 After: 1 this Construction  
 (1) OWNER SKELTON CONSTRUCTION INC. NO. OF BUILDINGS ON PARCEL  
 Before: 0 After: 1 this Construction  
 (1) ADDRESS PO Box 4247 USE OF EXISTING BUILDINGS N/A  
 (1) TELEPHONE 245-9008 DESCRIPTION OF WORK & INTENDED USE Now HOME  
 (2) APPLICANT SKELTON CONSTRUCTION INC. TYPE OF HOME PROPOSED:  
 (2) ADDRESS PO Box 4247  Site Built  Manufactured Home (UBC)  
 Manufactured Home (HUD)  
 (2) TELEPHONE 245-9008  Other (please specify) \_\_\_\_\_

**REQUIRED: One plot plan, on 8 1/2" x 11" paper, showing all existing & proposed structure location(s), parking, setbacks to all property lines, ingress/egress to the property, driveway location & width & all easements & rights-of-way which abut the parcel.**

**THIS SECTION TO BE COMPLETED BY COMMUNITY DEVELOPMENT DEPARTMENT STAFF**

ZONE RMF-5 Maximum coverage of lot by structures 60%  
 SETBACKS: Front 20' from property line (PL) Permanent Foundation Required: YES  NO   
 or \_\_\_\_\_ from center of ROW, whichever is greater  
 Side 5' from PL, Rear 25' from PL Parking Req'mt 2  
 Maximum Height 35' Special Conditions \_\_\_\_\_  
 CENSUS 10 TRAFFIC 22 ANNEX# \_\_\_\_\_

Modifications to this Planning Clearance must be approved, in writing, by the Community Development Department. The structure authorized by this application cannot be occupied until a final inspection has been completed and a Certificate of Occupancy has been issued, if applicable, by the Building Department (Section 305, Uniform Building Code).


I hereby acknowledge that I have read this application and the information is correct; I agree to comply with any and all codes, ordinances, laws, regulations or restrictions which apply to the project. I understand that failure to comply shall result in legal action, which may include but not necessarily be limited to non-use of the building(s).

Applicant Signature \_\_\_\_\_ Date 8/22/01  
 Department Approval [Signature] Date 8/27/01

Additional water and/or sewer tap fee(s) are required:	YES <input checked="" type="checkbox"/>	NO	W/O No. <u>14220</u>
Utility Accounting	<u>[Signature]</u>	Date	<u>8/27/01</u>

VALID FOR SIX MONTHS FROM DATE OF ISSUANCE (Section 9-3-2C Grand Junction Zoning & Development Code)

(White: Planning) (Yellow: Customer) (Pink: Building Department) (Goldenrod: Utility Accounting)

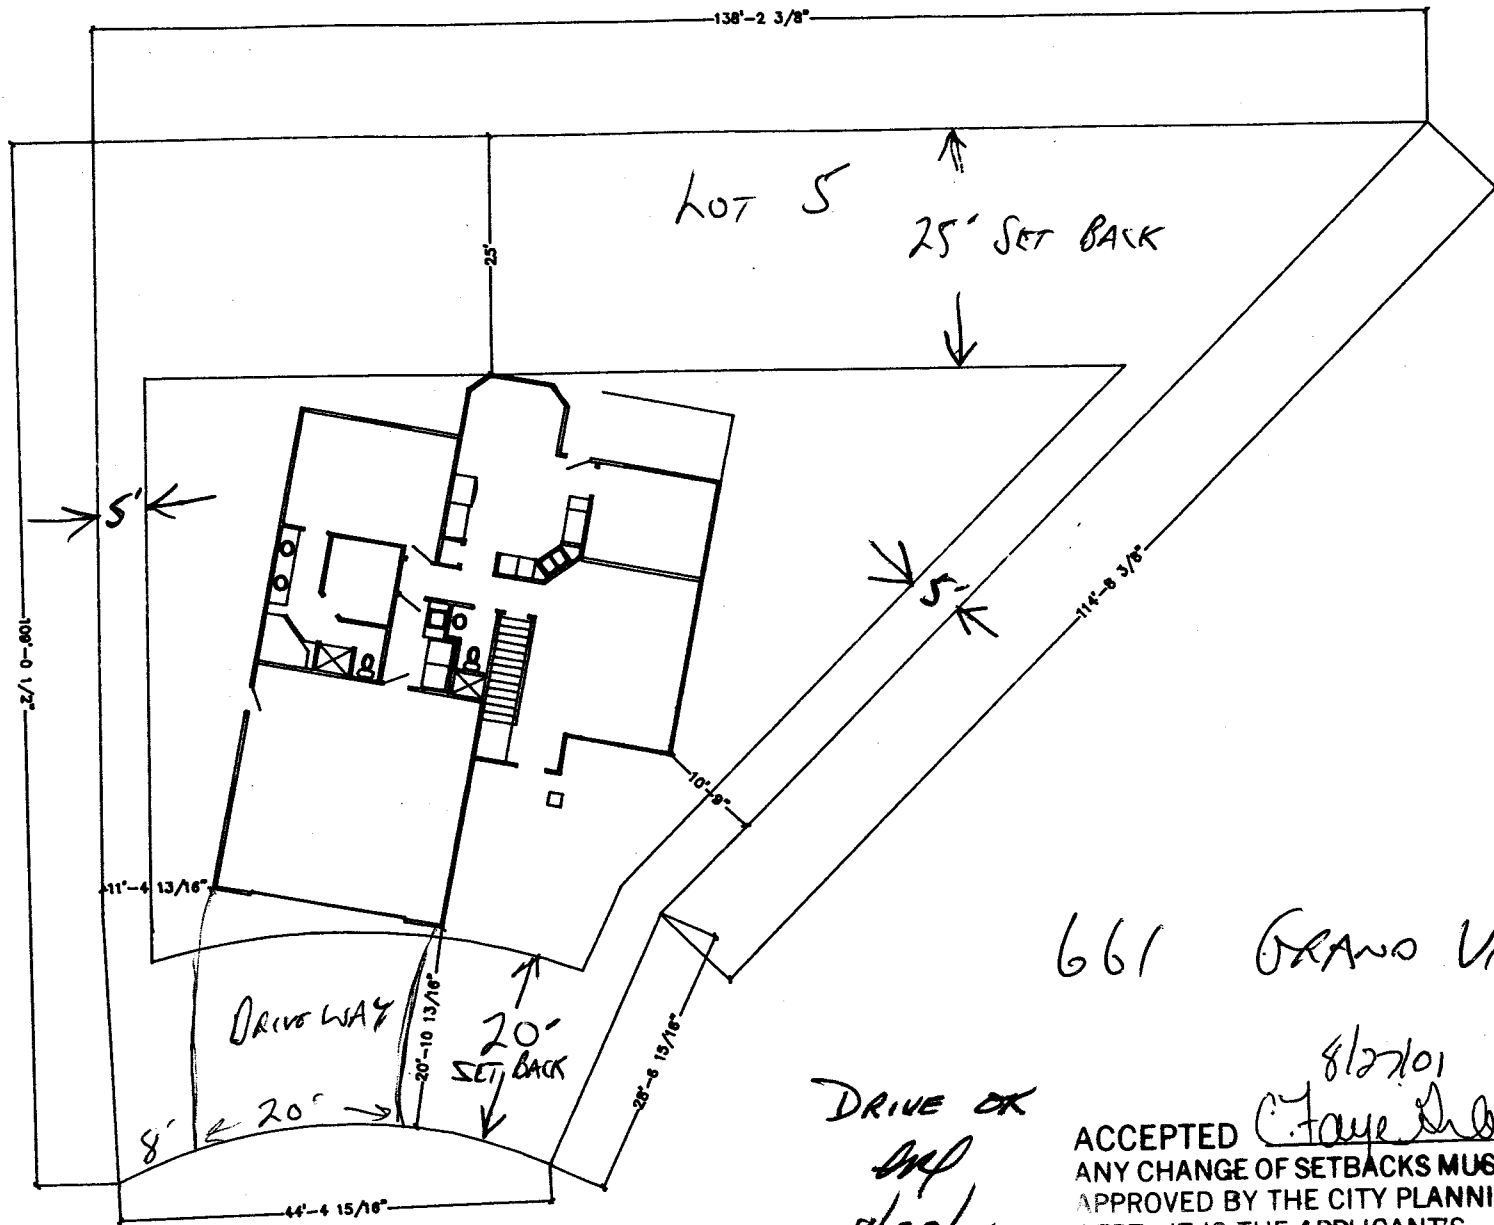

661 GRAND VIEW DR.

DRIVE OK  
 [Signature]  
 8/22/01

8/27/01  
 C. Faye Johnson  
 ACCEPTED  
 ANY CHANGE OF SETBACKS MUST BE APPROVED BY THE CITY PLANNING DEPT. IT IS THE APPLICANT'S RESPONSIBILITY TO PROPERLY LOCATE AND IDENTIFY EASEMENTS AND PROPERTY LINES.

— GRAND VIEW DR →