

FEE \$ 10.00
 T&P \$ 158.50
 SIF \$ 292.00

PLANNING CLEARANCE
 (Single Family Residential and Accessory Structures)
Community Development Department

BLDG PERMIT NO. 80646

AC



Your Bridge to a Better Community

BLDG ADDRESS 2495 A INTERLOCKAN SQ. FT. OF PROPOSED BLDGS/ADDITION 1150
 TAX SCHEDULE NO. 2701-334-31-026 SQ. FT. OF EXISTING BLDGS 0
 SUBDIVISION FOUNTAIN GREEN TOTAL SQ. FT. OF EXISTING & PROPOSED 2550
 FILING 1 BLK 1 LOT 6 NO. OF DWELLING UNITS:
 Before: 0 After: 2 this Construction
 (1) OWNER SKELTON CONSTRUCTION INC NO. OF BUILDINGS ON PARCEL
 Before: 0 After: 1 this Construction
 (1) ADDRESS PO Box 4247 USE OF EXISTING BUILDINGS N/A
 (1) TELEPHONE 245-9008 DESCRIPTION OF WORK & INTENDED USE Now Home
 (2) APPLICANT SKELTON CONSTRUCTION INC TYPE OF HOME PROPOSED:
 (2) ADDRESS PO Box 4247 Site Built Manufactured Home (UBC)
 (2) TELEPHONE 245-9008 Manufactured Home (HUD)
 Other (please specify) _____

REQUIRED: One plot plan, on 8 1/2" x 11" paper, showing all existing & proposed structure location(s), parking, setbacks to all property lines, ingress/egress to the property, driveway location & width & all easements & rights-of-way which abut the parcel.

THIS SECTION TO BE COMPLETED BY COMMUNITY DEVELOPMENT DEPARTMENT STAFF

ZONE PD Maximum coverage of lot by structures 45%
 SETBACKS: Front 20' from property line (PL) Permanent Foundation Required: YES NO
 or _____ from center of ROW, whichever is greater
 Side 5' outside from PL, Rear _____ from PL Parking Req'mt 2
 Maximum Height 32' Special Conditions _____
 CENSUS 4 TRAFFIC 9 ANN# _____

Modifications to this Planning Clearance must be approved, in writing, by the Community Development Department. The structure authorized by this application cannot be occupied until a final inspection has been completed and a Certificate of Occupancy has been issued, if applicable, by the Building Department (Section 305, Uniform Building Code).

I hereby acknowledge that I have read this application and the information is correct; I agree to comply with any and all codes, ordinances, laws, regulations or restrictions which apply to the project. I understand that failure to comply shall result in legal action, which may include but not necessarily be limited to non-use of the building(s).

Applicant Signature _____ Date 7/19/01
 Department Approval C. J. Jensen Date 7/11/01

Additional water and/or sewer tap fee(s) are required:	YES <input checked="" type="checkbox"/>	NO <input type="checkbox"/>	W/O No. <u>14116</u>
Utility Accounting	_____		Date <u>7/11/01</u>

VALID FOR SIX MONTHS FROM DATE OF ISSUANCE (Section 9-3-2C Grand Junction Zoning & Development Code)

(White: Planning) (Yellow: Customer) (Pink: Building Department) (Goldenrod: Utility Accounting)


ACCEPTED *C. Jay Nelson*
ANY CHANGE OF SETBACKS MUST BE APPROVED BY THE CITY PLANNING DEPT. IT IS THE APPLICANT'S RESPONSIBILITY TO PROPERLY LOCATE AND IDENTIFY EASEMENTS AND PROPERTY LINES.

7/10/01

Fountainhead Boulevard

DRIVE
2/11/01

DRIVE OK

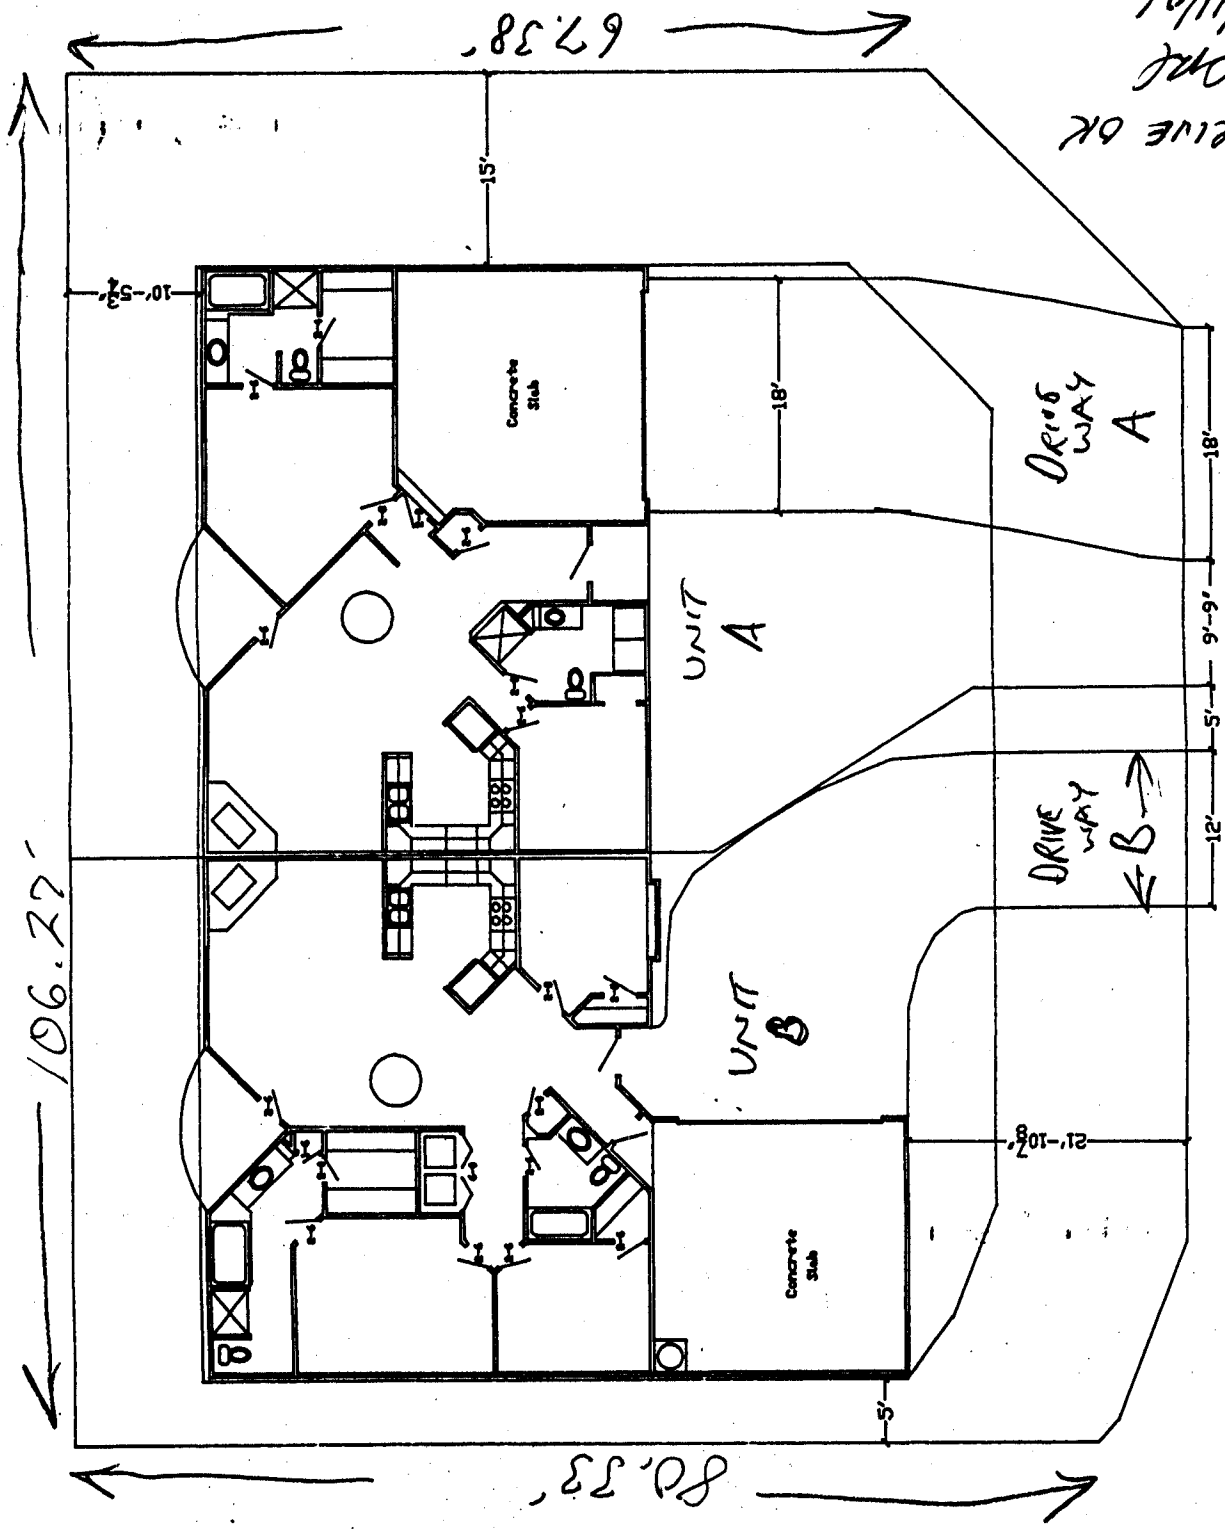

2495

Interlocken