

FEE \$	10 <sup>00</sup>
TCP \$	500 <sup>00</sup>
SIF \$	292 <sup>03</sup>

# PLANNING CLEARANCE

(Single Family Residential and Accessory Structures)  
**Community Development Department**

BLDG PERMIT NO. 81042



Your Bridge to a Better Community

BLDG ADDRESS 2820 Key Stone Ct SQ. FT. OF PROPOSED BLDGS/ADDITION \_\_\_\_\_

TAX SCHEDULE NO. 2943-062-35-013 SQ. FT. OF EXISTING BLDGS \_\_\_\_\_

SUBDIVISION Grand View TOTAL SQ. FT. OF EXISTING & PROPOSED \_\_\_\_\_

FILING 4 BLK 3 LOT 13 NO. OF DWELLING UNITS:  
 Before: 0 After: 1 this Construction

(1) OWNER SKELTON CONDO NO. OF BUILDINGS ON PARCEL  
 Before: 0 After: 1 this Construction

(1) ADDRESS P.O. Box 4247 / G.J. 81502 USE OF EXISTING BUILDINGS OK

(1) TELEPHONE 245-9008 DESCRIPTION OF WORK & INTENDED USE RESIDENTIAL

(2) APPLICANT SAME TYPE OF HOME PROPOSED:  
 \_\_\_\_\_ Site Built \_\_\_\_\_ Manufactured Home (UBC)  
 \_\_\_\_\_ Manufactured Home (HUD)  
 \_\_\_\_\_ Other (please specify) \_\_\_\_\_

(2) ADDRESS \_\_\_\_\_  
 (2) TELEPHONE \_\_\_\_\_

**REQUIRED: One plot plan, on 8 1/2" x 11" paper, showing all existing & proposed structure location(s), parking, setbacks to all property lines, ingress/egress to the property, driveway location & width & all easements & rights-of-way which abut the parcel.**

**THIS SECTION TO BE COMPLETED BY COMMUNITY DEVELOPMENT DEPARTMENT STAFF**

ZONE RMF-5 Maximum coverage of lot by structures 60%

SETBACKS: Front 20' from property line (PL) Permanent Foundation Required: YES X NO \_\_\_\_\_  
 or \_\_\_\_\_ from center of ROW, whichever is greater

Side 5' from PL, Rear 25' from PL Parking Req'mt 2

Maximum Height 35' Special Conditions \_\_\_\_\_

CENSUS 10 TRAFFIC 22 ANNEX# \_\_\_\_\_

Modifications to this Planning Clearance must be approved, in writing, by the Community Development Department. The structure authorized by this application cannot be occupied until a final inspection has been completed and a Certificate of Occupancy has been issued, if applicable, by the Building Department (Section 305, Uniform Building Code).

I hereby acknowledge that I have read this application and the information is correct; I agree to comply with any and all codes, ordinances, laws, regulations or restrictions which apply to the project. I understand that failure to comply shall result in legal action, which may include but not necessarily be limited to non-use of the building(s).


Applicant Signature Doris Skelton Date 8-8-01

Department Approval Wendy Spurr Date 8/10/01

Additional water and/or sewer tap fee(s) are required:	YES <input checked="" type="checkbox"/>	NO	W/O No. <u>14197</u>
Utility Accounting	<u>Kate Holt</u>	Date	<u>8/10/01</u>

VALID FOR SIX MONTHS FROM DATE OF ISSUANCE (Section 9-3-2C Grand Junction Zoning & Development Code)

(White: Planning) (Yellow: Customer) (Pink: Building Department) (Goldenrod: Utility Accounting)

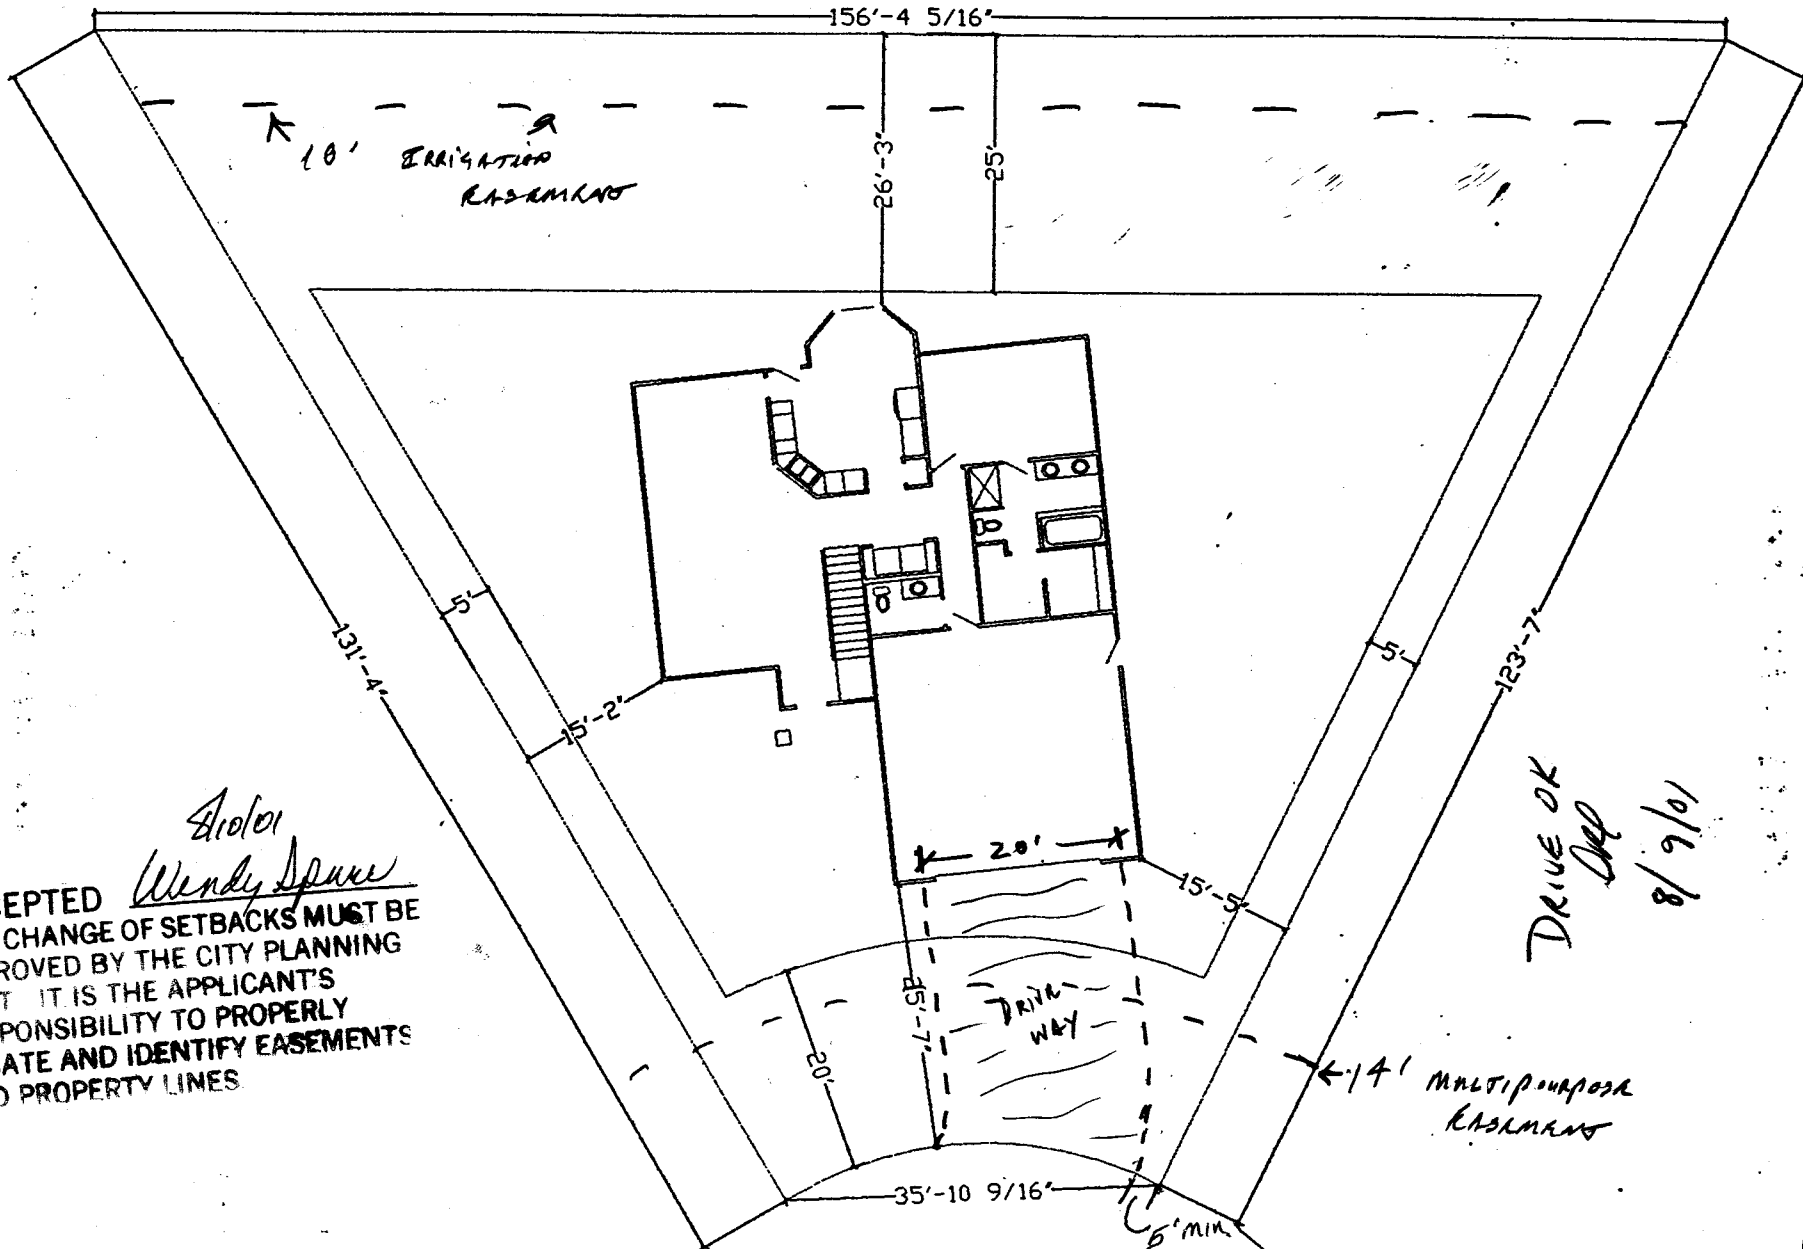

ACCEPTED *8/10/01 Wendy Spivey*  
 ANY CHANGE OF SETBACKS MUST BE APPROVED BY THE CITY PLANNING DEPT. IT IS THE APPLICANT'S RESPONSIBILITY TO PROPERLY LOCATE AND IDENTIFY EASEMENTS AND PROPERTY LINES.

DRIVE OK  
*Del*  
 8/9/01

← 14' MULTIPURPOSE EASEMENT

Drive of adjacent lot on opposite side of lot.

2820 KEY STONE CT