

FEE \$	10 ⁻
TCP \$	0
SIF \$	292 ⁻

PLANNING CLEARANCE

(Single Family Residential and Accessory Structures)
Community Development Department

BLDG PERMIT NO. 78947



Your Bridge to a Better Community

BLDG ADDRESS 661 W MARSHALL ST SQ. FT. OF PROPOSED BLDGS/ADDITION 1196

TAX SCHEDULE NO. 2945-032-00-166 SQ. FT. OF EXISTING BLDGS 0

SUBDIVISION GARRETT ESTATES TOTAL SQ. FT. OF EXISTING & PROPOSED 1196

FILING 1 BLK 3 LOT 20 NO. OF DWELLING UNITS:
 Before: 0 After: 1 this Construction

(1) OWNER Lee Hones NO. OF BUILDINGS ON PARCEL
 Before: 0 After: 1 this Construction

(1) ADDRESS 3030 FLAMECREST USE OF EXISTING BUILDINGS 0

(1) TELEPHONE 234-1091 DESCRIPTION OF WORK & INTENDED USE new Residence

(2) APPLICANT [Signature] TYPE OF HOME PROPOSED:
 Site Built Manufactured Home (UBC)
 Manufactured Home (HUD)
 Other (please specify) _____

(2) ADDRESS _____

(2) TELEPHONE _____

REQUIRED: One plot plan, on 8 1/2" x 11" paper, showing all existing & proposed structure location(s), parking, setbacks to all property lines, ingress/egress to the property, driveway location & width & all easements & rights-of-way which abut the parcel.

THIS SECTION TO BE COMPLETED BY COMMUNITY DEVELOPMENT DEPARTMENT STAFF

ZONE RMF-8 Maximum coverage of lot by structures 70%

SETBACKS: Front 20' from property line (PL) Permanent Foundation Required: YES X NO _____
 or _____ from center of ROW, whichever is greater

Side 5' from PL, Rear 10' from PL Parking Req'mt 2

Maximum Height 35' Special Conditions 5' irri easement in rear

CENSUS 10 TRAFFIC 19 ANN# _____

Modifications to this Planning Clearance must be approved, in writing, by the Community Development Department. The structure authorized by this application cannot be occupied until a final inspection has been completed and a Certificate of Occupancy has been issued, if applicable, by the Building Department (Section 305, Uniform Building Code).

I hereby acknowledge that I have read this application and the information is correct; I agree to comply with any and all codes, ordinances, laws, regulations or restrictions which apply to the project. I understand that failure to comply shall result in legal action, which may include but not necessarily be limited to non-use of the building(s).

Applicant Signature [Signature] Date 16 Feb 01

Department Approval [Signature] Date 2/23/01

Additional water and/or sewer tap fee(s) are required:	YES <input checked="" type="checkbox"/>	NO	W/O No. <u>13761</u>
Utility Accounting <u>[Signature]</u>		Date <u>2/23/01</u>	

VALID FOR SIX MONTHS FROM DATE OF ISSUANCE (Section 9-3-2C Grand Junction Zoning & Development Code)


(White: Planning) (Yellow: Customer) (Pink: Building Department) (Goldenrod: Utility Accounting)

2/23/01

C. Gaye Gibson

ACCEPTED
ANY CHANGE OF SETBACKS MUST BE APPROVED BY THE CITY PLANNING DEPT. IT IS THE APPLICANT'S RESPONSIBILITY TO PROPERLY LOCATE AND IDENTIFY EASEMENTS AND PROPERTY LINES.

GARRETT ESTATES SUBDIVISION

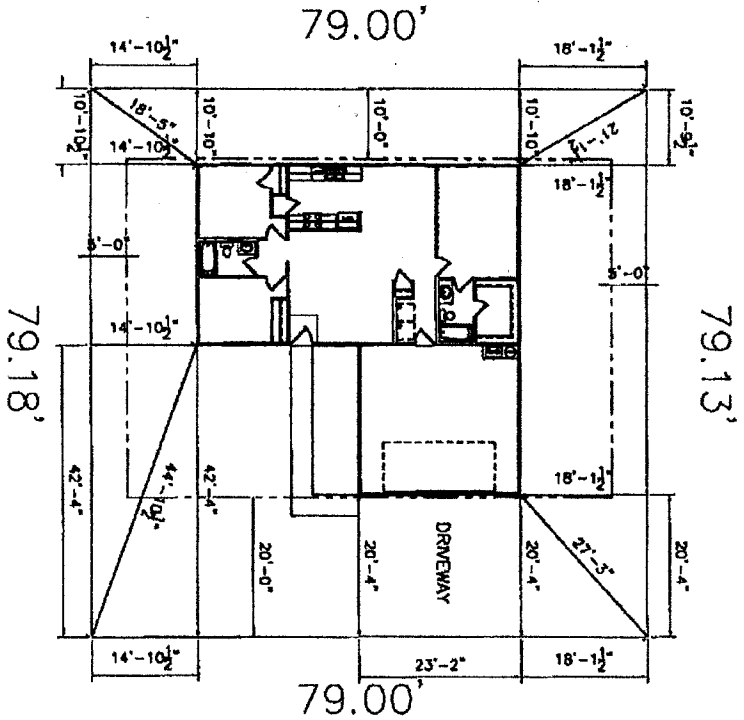

MARSHALL STREET
661

DRIVE OK
BRD
2/21/01

BLOCK 3
LOT 20
6253 SQ.FT.
1196 PLAN

Need to start

Measurements to be applicant's

WJ