

FEE \$ 10.00
TCP \$ 0
SIF \$ 292.00

**PLANNING CLEARANCE**  
(Single Family Residential and Accessory Structures)  
**Community Development Department**

BLDG PERMIT NO. 79474



Your Bridge to a Better Community

BLDG ADDRESS 665 MARSHAL ST SQ. FT. OF PROPOSED BLDGS/ADDITION 1335

TAX SCHEDULE NO. 2945-03200-166 SQ. FT. OF EXISTING BLDGS 0

SUBDIVISION GARRETT ESTATES TOTAL SQ. FT. OF EXISTING & PROPOSED 1335

FILING 1 BLK 3 LOT 18

NO. OF DWELLING UNITS:  
Before: 0 After: 1 this Construction

(1) OWNER Lee Homes NO. OF BUILDINGS ON PARCEL  
Before: 0 After: 1 this Construction

(1) ADDRESS 3030 FLAMECREST

USE OF EXISTING BUILDINGS 0

(1) TELEPHONE 234-1091

DESCRIPTION OF WORK & INTENDED USE new Residence

(2) APPLICANT [Signature]

TYPE OF HOME PROPOSED:  
 Site Built  Manufactured Home (UBC)  
 Manufactured Home (HUD)  
 Other (please specify) \_\_\_\_\_

(2) ADDRESS \_\_\_\_\_

(2) TELEPHONE \_\_\_\_\_

**REQUIRED: One plot plan, on 8 1/2" x 11" paper, showing all existing & proposed structure location(s), parking, setbacks to all property lines, ingress/egress to the property, driveway location & width & all easements & rights-of-way which abut the parcel.**

**THIS SECTION TO BE COMPLETED BY COMMUNITY DEVELOPMENT DEPARTMENT STAFF**

ZONE RMF-8 Maximum coverage of lot by structures 70%

SETBACKS: Front 20' from property line (PL) Permanent Foundation Required: YES  NO   
or \_\_\_\_\_ from center of ROW, whichever is greater

Side 5' from PL, Rear 10' from PL Parking Req'mt 2

Maximum Height 35' Special Conditions Licensed Geotech letter required

CENSUS 10 TRAFFIC 19 ANNEX# \_\_\_\_\_

Modifications to this Planning Clearance must be approved, in writing, by the Community Development Department. The structure authorized by this application cannot be occupied until a final inspection has been completed and a Certificate of Occupancy has been issued, if applicable, by the Building Department (Section 305, Uniform Building Code).

I hereby acknowledge that I have read this application and the information is correct; I agree to comply with any and all codes, ordinances, laws, regulations or restrictions which apply to the project. I understand that failure to comply shall result in legal action, which may include but not necessarily be limited to non-use of the building(s).

Applicant Signature [Signature] Date 2 APR 01

Department Approval [Signature] Date 4/9/01


Additional water and/or sewer tap fee(s) are required:	YES <input checked="" type="checkbox"/>	NO <input type="checkbox"/>	W/O No. <u>13879</u>
Utility Accounting	<u>[Signature]</u>	Date	<u>4/9/01</u>

VALID FOR SIX MONTHS FROM DATE OF ISSUANCE (Section 9-3-2C Grand Junction Zoning & Development Code)

(White: Planning) (Yellow: Customer) (Pink: Building Department) (Goldenrod: Utility Accounting)

# GARRETT ESTATES SUBDIVISION

ATTN: PAT

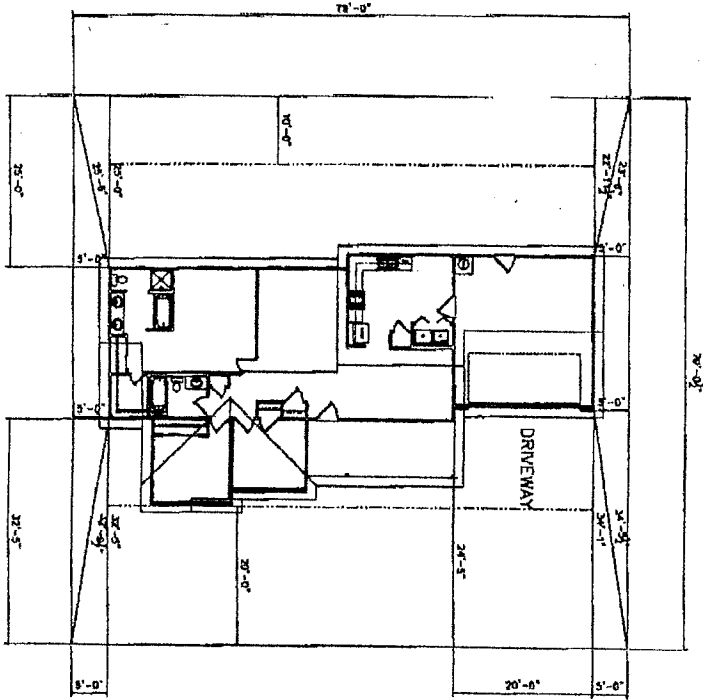

DRIVE OK  
DRL  
4/16/01

## MARSHALL STREET

ACCEPTED *Alise Meyer* 4/16/01  
ANY CHANGE OF SETBACKS MUST BE APPROVED BY THE CITY PLANNING DEPT. IT IS THE APPLICANT'S RESPONSIBILITY TO PROPERLY LOCATE AND IDENTIFY EASEMENTS AND PROPERTY LINES

665 *Marshall St.*  
RUCKMAN 1335 PLAN  
LOT 18  
6246 SQ.FT.  
BLOCK 3

**Geotechnical  
Engineering  
Group, Inc.**

April 23, 2001

Lee Homes Inc.  
P.O. Box 40521  
Grand Junction, CO 81504

Attention: Mr. Rick Brown

Subject: Excavation Observation  
665 Marshall Street  
Lot 18, Garrett Estates Subdivision, Block 3  
Grand Junction, Colorado  
Job No. 646

As requested, a Geotechnical Engineering Group, Inc. representative visited the site and observed the open foundation excavation on April 19 and 20, 2001. Soils found in the excavation appeared to be consistent with those identified by the "Geotechnical Exploration for Garrett Estates in Grand Junction, Colorado" dated April 20, 2000, prepared by Western Colorado Testing Inc. (their Job No. 205900). We observed the completed excavation prior to fill placement and a proof roll, made by a JD500C with a full bucket of a 12-inch depth lift of fill that revealed no significant yielding on the area observed. We believe the foundation soils are suitable to support a shallow foundation system with a maximum bearing pressure of 1,000 psf as described in the referenced report. We understand turned down slab foundations are proposed for the residence and foundation plans have been reviewed by Mesa County Building Department. In our opinion, turned down slab foundations designed and constructed to meet or exceed Mesa County Minimum House Foundation Standards and the referenced report will be suitable for the residence. This opinion is based on observation of the completed excavation and proof roll of the proposed foundation subgrade.

We appreciate the opportunity to provide geotechnical services. When we can be of further service, please call.

Sincerely,  
GEOTECHNICAL ENGINEERING GROUP, INC.

  
John P. Withers, P.E.  
Principal Engineer



JPW:mk  
(1 copy faxed)

Geotechnical, Environmental and Materials Testing Consultants

(970) 245-4078 • fax (970) 245-7115  
685 West Gunnison Ave., Suite 110, Grand Junction, Colorado 81505