

FEE \$	10'
TCP \$	0
SIF \$	292

**PLANNING CLEARANCE**  
 (Single Family Residential and Accessory Structures)  
**Community Development Department**

BLDG PERMIT NO. 78917



Your Bridge to a Better Community

BLDG ADDRESS 671 MARSHAL ST SQ. FT. OF PROPOSED BLDGS/ADDITION 1410

TAX SCHEDULE NO. 2945-032-00-166 SQ. FT. OF EXISTING BLDGS 0

SUBDIVISION BARRETT ESTATES TOTAL SQ. FT. OF EXISTING & PROPOSED 1410

FILING 1 BLK 3 LOT 5 NO. OF DWELLING UNITS:  
 Before: 2 After: 1 this Construction

(1) OWNER Lee Homes NO. OF BUILDINGS ON PARCEL  
 Before: 2 After: 1 this Construction

(1) ADDRESS 3030 FLAMECREST USE OF EXISTING BUILDINGS 0

(1) TELEPHONE 234-1071 DESCRIPTION OF WORK & INTENDED USE new Residence

(2) APPLICANT [Signature] TYPE OF HOME PROPOSED:  
 Site Built  Manufactured Home (UBC)  
 Manufactured Home (HUD)  
 Other (please specify) \_\_\_\_\_

(2) ADDRESS \_\_\_\_\_

(2) TELEPHONE \_\_\_\_\_

**REQUIRED: One plot plan, on 8 1/2" x 11" paper, showing all existing & proposed structure location(s), parking, setbacks to all property lines, ingress/egress to the property, driveway location & width & all easements & rights-of-way which abut the parcel.**

**THIS SECTION TO BE COMPLETED BY COMMUNITY DEVELOPMENT DEPARTMENT STAFF**

ZONE RMF-8 Maximum coverage of lot by structures 70%

SETBACKS: Front 20' from property line (PL) Permanent Foundation Required: YES  NO   
 or \_\_\_\_\_ from center of ROW, whichever is greater

Side 5' from PL, Rear 10' from PL Parking Req'mt 2

Maximum Height 35' Special Conditions 5' irri easment in rear

CENSUS 10 TRAFFIC 19 ANN# \_\_\_\_\_

Modifications to this Planning Clearance must be approved, in writing, by the Community Development Department. The structure authorized by this application cannot be occupied until a final inspection has been completed and a Certificate of Occupancy has been issued, if applicable, by the Building Department (Section 305, Uniform Building Code).

I hereby acknowledge that I have read this application and the information is correct; I agree to comply with any and all codes, ordinances, laws, regulations or restrictions which apply to the project. I understand that failure to comply shall result in legal action, which may include but not necessarily be limited to non-use of the building(s).

Applicant Signature [Signature] Date 16 Feb 01


Department Approval [Signature] Date 2/23/01

Additional water and/or sewer tap fee(s) are required:	YES <input checked="" type="checkbox"/>	NO <input type="checkbox"/>	W/O No. <u>13757</u>
Utility Accounting	<u>[Signature]</u>	Date	<u>2/23/01</u>

VALID FOR SIX MONTHS FROM DATE OF ISSUANCE (Section 9-3-2C Grand Junction Zoning & Development Code)

(White: Planning) (Yellow: Customer) (Pink: Building Department) (Goldenrod: Utility Accounting)

GARRETT ESTATES SUBDIVISION

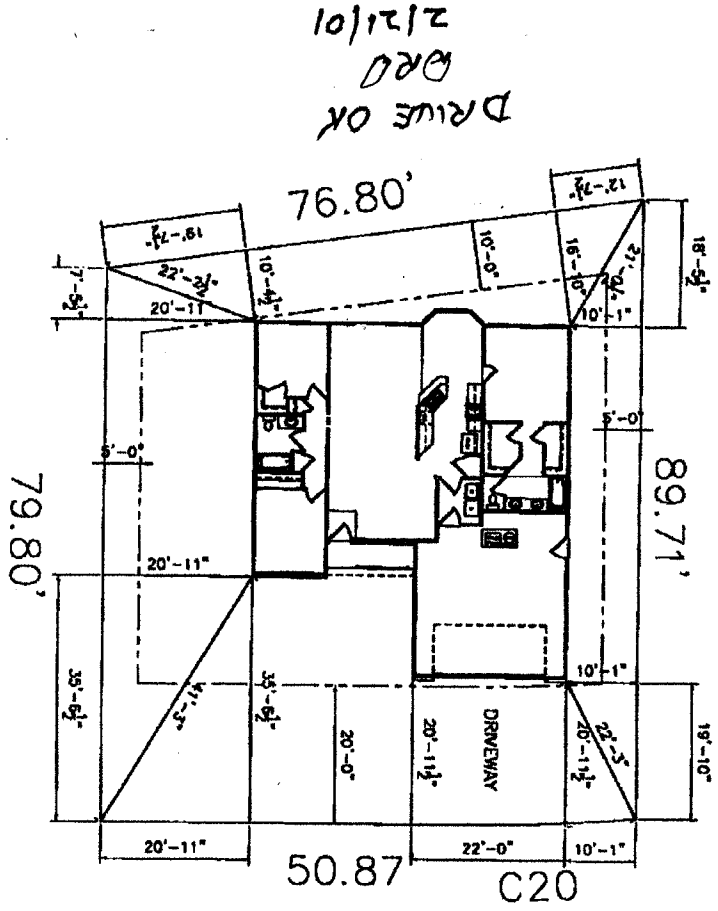

671 MARSHALL STREET

ACCEPTED *2/23/01*  
*C. Faye Gibson*  
 ANY CHANGE OF SETBACKS MUST BE APPROVED BY THE CITY PLANNING DEPT. IT IS THE APPLICANT'S RESPONSIBILITY TO PROPERLY LOCATE AND IDENTIFY EASEMENTS AND PROPERTY LINES.

1410

BLOCK 3  
 LOT 15  
 6475 SQ.FT.