

FEE \$	10 ⁰⁰
TCP \$	0
SIF \$	292 ⁰⁰

PLANNING CLEARANCE

(Single Family Residential and Accessory Structures)

Community Development Department

BLDG PERMIT NO. 78686



Your Bridge to a Better Community

BLDG ADDRESS 675 MARSHALL CT SQ. FT. OF PROPOSED BLDGS/ADDITION 1410 #

TAX SCHEDULE NO. 2945-032-00-166 SQ. FT. OF EXISTING BLDGS 0

SUBDIVISION CHARCETT ESTATES TOTAL SQ. FT. OF EXISTING & PROPOSED 1410 #

FILING 1 BLK 3 LOT 10 NO. OF DWELLING UNITS:
 Before: 0 After: 1 this Construction

(1) OWNER Lee Harris NO. OF BUILDINGS ON PARCEL
 Before: 0 After: 1 this Construction

(1) ADDRESS 3030 FLAMINGO ST USE OF EXISTING BUILDINGS X

(1) TELEPHONE 234-1091 DESCRIPTION OF WORK & INTENDED USE New Res Home

(2) APPLICANT PH PH TYPE OF HOME PROPOSED:
 Site Built Manufactured Home (UBC)
 Manufactured Home (HUD)
 Other (please specify) _____

(2) ADDRESS _____

(2) TELEPHONE _____

REQUIRED: One plot plan, on 8 1/2" x 11" paper, showing all existing & proposed structure location(s), parking, setbacks to all property lines, ingress/egress to the property, driveway location & width & all easements & rights-of-way which abut the parcel.

THIS SECTION TO BE COMPLETED BY COMMUNITY DEVELOPMENT DEPARTMENT STAFF

ZONE RMF-8 Maximum coverage of lot by structures 70%

SETBACKS: Front 20' from property line (PL) Permanent Foundation Required: YES X NO _____
 or _____ from center of ROW, whichever is greater

Side 5' from PL, Rear 10' from PL Parking Req'mt 2

Maximum Height 35' Special Conditions _____

CENSUS 10 TRAFFIC 19 ANN# _____

Modifications to this Planning Clearance must be approved, in writing, by the Community Development Department. The structure authorized by this application cannot be occupied until a final inspection has been completed and a Certificate of Occupancy has been issued, if applicable, by the Building Department (Section 305, Uniform Building Code).

I hereby acknowledge that I have read this application and the information is correct; I agree to comply with any and all codes, ordinances, laws, regulations or restrictions which apply to the project. I understand that failure to comply shall result in legal action, which may include but not necessarily be limited to non-use of the building(s).

Applicant Signature [Signature] Date 8 Feb 01

Department Approval Ronnie Edwards Date 2/13/01

Additional water and/or sewer tap fee(s) are required:	YES <input checked="" type="checkbox"/>	NO <input type="checkbox"/>	W/O No <u>13714</u>
Utility Accounting	<u>[Signature]</u>	Date	<u>2/13/01</u>

VALID FOR SIX MONTHS FROM DATE OF ISSUANCE (Section 9-3-2C Grand Junction Zoning & Development Code)

(White: Planning) (Yellow: Customer) (Pink: Building Department) (Goldenrod: Utility Accounting)

GARRETT ESTATES SUBDIVISION


BLOCK 3

LOT 10

8558 SQ.FT.

675 Marshall

1410 PLAN

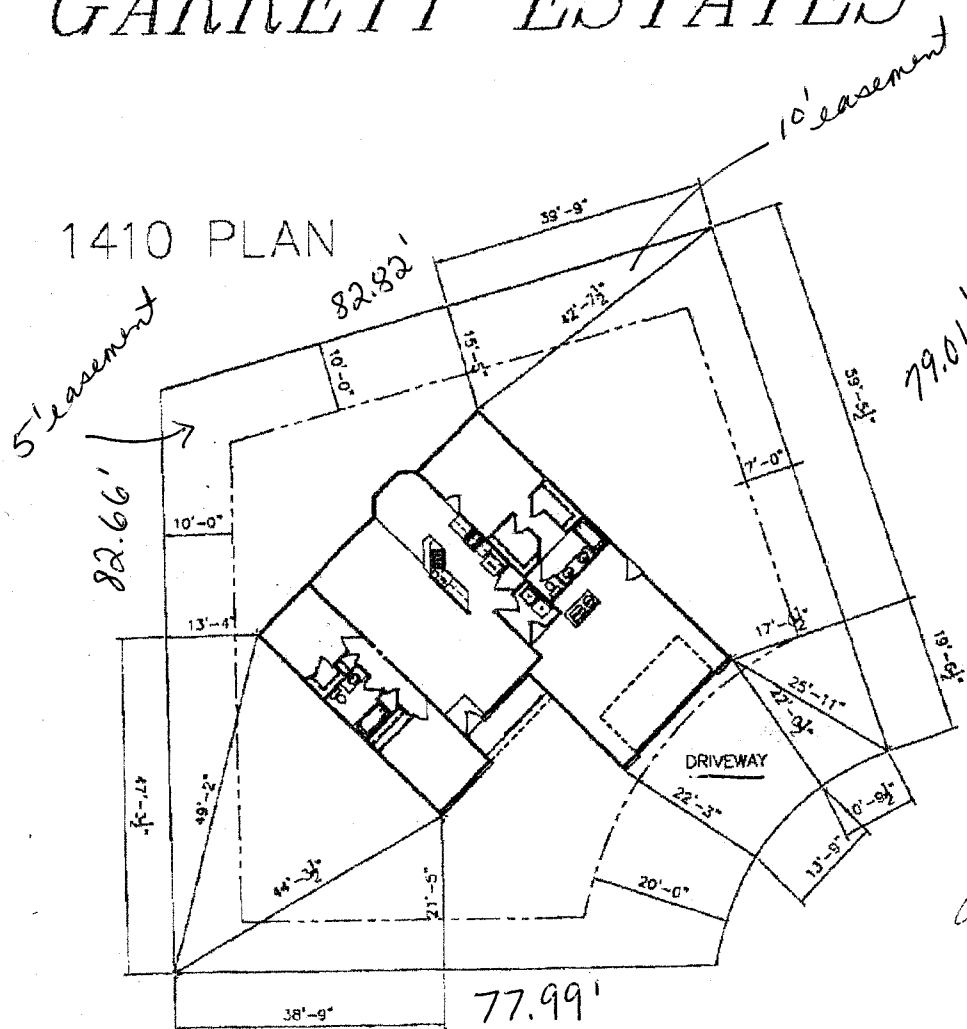

DRIVE OK AS DIMENSIONED

DAL
2/9/01

measurements are approximate & subject to change by builder

ACCEPTED Ronnie 7/13/01

ANY CHANGE OF SETBACKS MUST BE APPROVED BY THE CITY PLANNING DEPT. IT IS THE APPLICANT'S RESPONSIBILITY TO PROPERLY LOCATE AND IDENTIFY EASEMENTS AND PROPERTY LINES.

geotech report req'd before placing footings

FEB-05-01 11:02:10 AM



**Geotechnical
Engineering
Group, Inc.**

February 26, 2001

Lee Homes Inc.
P.O. Box 40521
Grand Junction, CO 81504

Attention: Mr. Rick Brown

Subject: Excavation Observation
675 Marshall Court
Lot 10, Garrett Estates Subdivision, Block 3
Grand Junction, Colorado
Job No. 646

As requested, a Geotechnical Engineering Group, Inc. representative visited the site and observed the open foundation excavation on February 16 and 20, 2001. Soils found in the excavation appeared to be consistent with those identified by the "Geotechnical Exploration for Garrett Estates in Grand Junction, Colorado" dated April 20, 2000, prepared by Western Colorado Testing, Inc. (their Job No. 205900). We observed the completed excavation prior to fill placement and a proof roll, made by a JD500C with a full bucket of a 12 inch depth lift of fill that revealed no significant yielding on the area observed. We believe the foundation soils are suitable to support a shallow foundation system with a maximum bearing pressure of 1,000 psf as described in the referenced report. We understand turned down slab foundations are proposed for the residence and foundation plans have been reviewed by Mesa County Building Department. In our opinion, turned down slab foundations designed and constructed to meet or exceed Mesa County Minimum House Foundation Standards and the referenced report will be suitable for the residence. This opinion is based on observation of the completed excavation and proof roll of the proposed slab subgrade.

We appreciate the opportunity to provide professional services. When we can be of further service, please call.

Sincerely,
GEOTECHNICAL ENGINEERING GROUP, INC.


John P. Withers, P.E.
Principal Engineer



JPW:mk
(1 copy faxed)

Geotechnical, Environmental and Materials Testing Consultants

(970) 245-4078 • fax (970) 245-7115

685 West Gunnison Ave., Suite 110, Grand Junction, Colorado 81505