

FEE \$	10.00
TCP \$	450.00
SIF \$	292.00

PLANNING CLEARANCE
 (Single Family Residential and Accessory Structures)
Community Development Department

BLDG PERMIT NO. 80112



Your Bridge to a Better Community

BLDG ADDRESS 640 Monnett CT
 TAX SCHEDULE NO. 2943-043-84-011
 SUBDIVISION MT VISTA
 FILING 1 BLK 6 LOT 12
 (1) OWNER Lee Jones
 (1) ADDRESS 655 Crossing
 (1) TELEPHONE 234-1091
 (2) APPLICANT [Signature]
 (2) ADDRESS _____
 (2) TELEPHONE _____

SQ. FT. OF PROPOSED BLDGS/ADDITION 1400
 SQ. FT. OF EXISTING BLDGS 0
 TOTAL SQ. FT. OF EXISTING & PROPOSED 1400
 NO. OF DWELLING UNITS:
 Before: 0 After: 1 this Construction
 NO. OF BUILDINGS ON PARCEL
 Before: 0 After: 1 this Construction
 USE OF EXISTING BUILDINGS 0 TB
 DESCRIPTION OF WORK & INTENDED USE new Res
 TYPE OF HOME PROPOSED:
 Site Built Manufactured Home (UBC)
 Manufactured Home (HUD)
 Other (please specify) _____

PAID
MAY 23 2001

REQUIRED: One plot plan, on 8 1/2" x 11" paper, showing all existing & proposed structure location(s), parking, setbacks to all property lines, ingress/egress to the property, driveway location & width & all easements & rights-of-way which abut the parcel.

THIS SECTION TO BE COMPLETED BY COMMUNITY DEVELOPMENT DEPARTMENT STAFF

ZONE RSF-4
 SETBACKS: Front 20' from property line (PL)
 or _____ from center of ROW, whichever is greater
 Side 7' from PL, Rear 25' from PL
 Maximum Height 35'

Maximum coverage of lot by structures 50%
 Permanent Foundation Required: YES X NO _____
 Parking Req'mt 2
 Special Conditions _____
 CENSUS 11 TRAFFIC 46 ANN# _____

Modifications to this Planning Clearance must be approved, in writing, by the Community Development Department. The structure authorized by this application cannot be occupied until a final inspection has been completed and a Certificate of Occupancy has been issued, if applicable, by the Building Department (Section 305, Uniform Building Code).

I hereby acknowledge that I have read this application and the information is correct; I agree to comply with any and all codes, ordinances, laws, regulations or restrictions which apply to the project. I understand that failure to comply shall result in legal action, which may include but not necessarily be limited to non-use of the building(s).

Applicant Signature [Signature] Date 22 MAY 01
 Department Approval C. J. Jaye Date 5/24/01

Additional water and/or sewer tap fee(s) are required:	YES	NO <input checked="" type="checkbox"/>	W/O No. <u>Paid at CGUSD</u>
Utility Accounting	<u>[Signature]</u>	Date	<u>5/24/01</u>


VALID FOR SIX MONTHS FROM DATE OF ISSUANCE (Section 9-3-2C Grand Junction Zoning & Development Code)
 (White: Planning) (Yellow: Customer) (Pink: Building Department) (Goldenrod: Utility Accounting)

640

MONARCH COURT

① DIMENSIONS WITH

3 to 5-foot setbacks @ right edge of lot

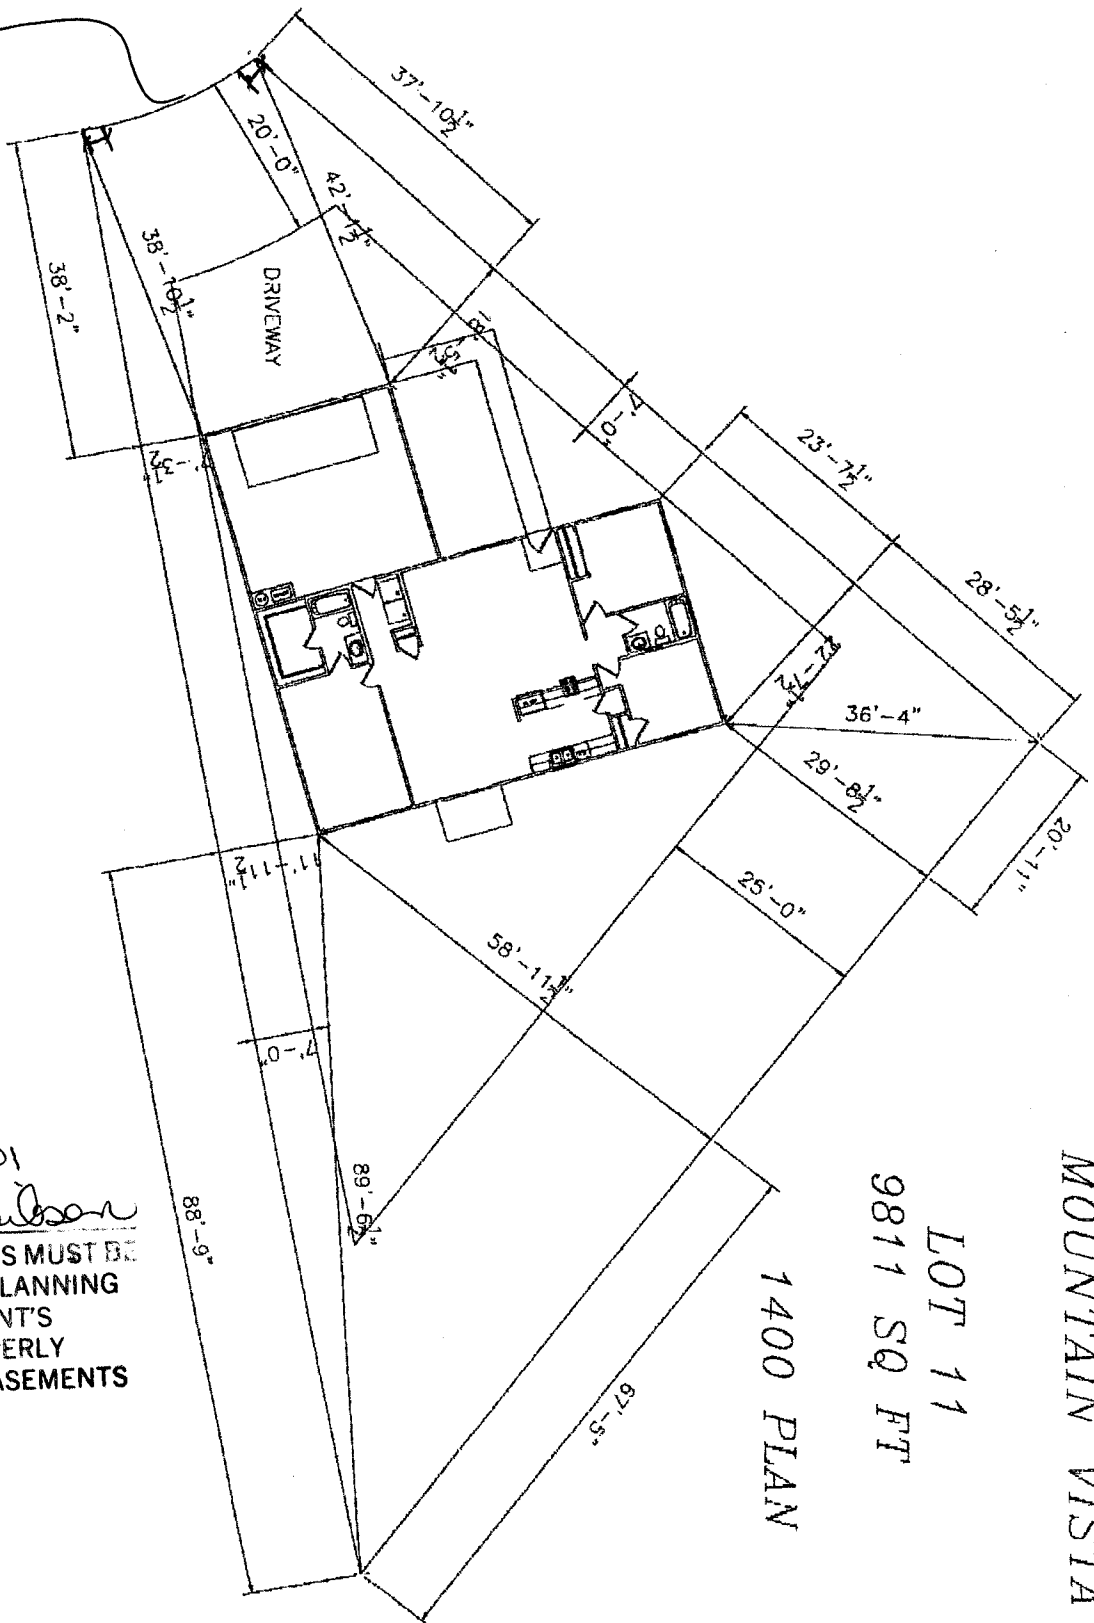

5/24/01
 ACCEPTED *Clay Gibson*
 ANY CHANGE OF SETBACKS MUST BE APPROVED BY THE CITY PLANNING DEPT. IT IS THE APPLICANT'S RESPONSIBILITY TO PROPERLY LOCATE AND IDENTIFY EASEMENTS AND PROPERTY LINES.

MOUNTAIN VISTA
 LOT 11
 9811 SQ FT
 1400 PLAN