

FEE \$	10
TCP \$	0
SIF \$	292.00

PLANNING CLEARANCE
 (Single Family Residential and Accessory Structures)
Community Development Department

BLDG PERMIT NO. 79742



Your Bridge to a Better Community

BLDG ADDRESS 2843 1/2 Maverick Dr. SQ. FT. OF PROPOSED BLDGS/ADDITION 2010 house
433 garage

TAX SCHEDULE NO. 2943-303-67-013 SQ. FT. OF EXISTING BLDGS - NA -

SUBDIVISION Arrowhead Acres II TOTAL SQ. FT. OF EXISTING & PROPOSED 2010 house
433 garage

FILING 2 BLK 4 LOT 13 NO. OF DWELLING UNITS:
 Before: 0 After: 1 this Construction

(1) OWNER H W Grace NO. OF BUILDINGS ON PARCEL
 Before: 0 After: 1 this Construction

(1) ADDRESS 518 28 Road G.S. CO
81501 USE OF EXISTING BUILDINGS - NA -

(1) TELEPHONE 241-6646 DESCRIPTION OF WORK & INTENDED USE New Home Const.

(2) APPLICANT H W Grace TYPE OF HOME PROPOSED:
 Site Built Manufactured Home (UBC)

(2) ADDRESS 518 28 Road G.S. CO 81501 Manufactured Home (HUD)
 Other (please specify) _____

(2) TELEPHONE 241-6646

REQUIRED: One plot plan, on 8 1/2" x 11" paper, showing all existing & proposed structure location(s), parking, setbacks to all property lines, ingress/egress to the property, driveway location & width & all easements & rights-of-way which abut the parcel.

THIS SECTION TO BE COMPLETED BY COMMUNITY DEVELOPMENT DEPARTMENT STAFF

ZONE RMF-5 Maximum coverage of lot by structures 60%

SETBACKS: Front 20' from property line (PL) Permanent Foundation Required: YES NO
 or _____ from center of ROW, whichever is greater

Side 5' from PL, Rear 25' from PL Parking Req'mt 2

Maximum Height 35' Special Conditions _____

CENSUS 13 TRAFFIC 84 ANN# _____

Modifications to this Planning Clearance must be approved, in writing, by the Community Development Department. The structure authorized by this application cannot be occupied until a final inspection has been completed and a Certificate of Occupancy has been issued, if applicable, by the Building Department (Section 305, Uniform Building Code).

I hereby acknowledge that I have read this application and the information is correct; I agree to comply with any and all codes, ordinances, laws, regulations or restrictions which apply to the project. I understand that failure to comply shall result in legal action, which may include but not necessarily be limited to non-use of the building(s).

Applicant Signature x Paul Doby Date 6/4/01

Department Approval Rae Wilson Oregon Date 6/8/01

Additional water and/or sewer tap fee(s) are required: YES NO W/O No MSD

Utility Accounting Tracy Shaffer Date 6/8/01

VALID FOR SIX MONTHS FROM DATE OF ISSUANCE (Section 9-3-2C Grand Junction Zoning & Development Code)

(White: Planning) (Yellow: Customer) (Pink: Building Department) (Goldenrod: Utility Accounting)


ARROWHEAD ACRES II, FILING TWO

B.4 ROAD



DRIVE OK
10/14/01

MAVERICK DRIVE

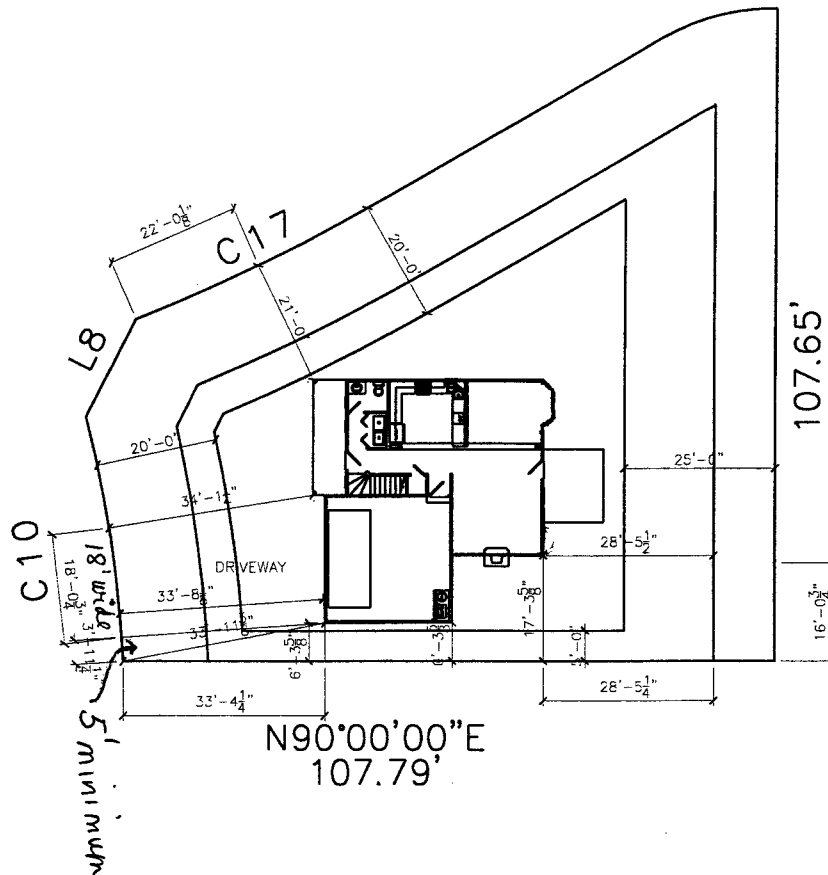

13
9049 SQ. FT.

ACCEPTED
ANY CHANGE OF SETBACKS MUST BE APPROVED BY THE CITY PLANNING DEPT. IT IS THE APPLICANT'S RESPONSIBILITY TO PROPERLY LOCATE AND IDENTIFY EASEMENTS AND PROPERTY LINES.

Alicia Aragon 10/8/01

2843 1/2 Maverick Drive Lot 13 Block 4