TCP\$ 600.00

(White: Planning)

(Yellow: Customer)

PLANNING CLEARANCE

(Single Family Residential and Accessory Structures)

Community Development Department


BLDG PERMIT NO. 8082/



(Goldenrod: Utility Accounting)

BLDG ADDRESS 311 1/2 Pins St.	SQ. FT. OF PROPOSED BLDGS/ADDITION 1344
TAX SCHEDULE NO. <u>2946 - 243 - 40 - 00</u> 1	SQ. FT. OF EXISTING BLDGS
SUBDIVISION BARRON SUBDIVISION	TOTAL SQ. FT. OF EXISTING & PROPOSED 1344
FILING BLK LOT LOT LOT OWNER BYGNE BOLLON (1) ADDRESS 310 PINE ST (1) TELEPHONE 970-254-8567 (2) APPLICANT Shown NEwton (2) ADDRESS 2465 Hwy 6 & So (2) TELEPHONE 970-256-1604	NO. OF DWELLING UNITS: Before: After: this Construction NO. OF BUILDINGS ON PARCEL Before: After: this Construction USE OF EXISTING BUILDINGS RESIDENCE DESCRIPTION OF WORK & INTENDED USE HOME. TYPE OF HOME PROPOSED: Site Built Manufactured Home (UBC) Manufactured Home (HUD) Other (please specify)
	Parking Regimt
structure authorized by this application cannot be occup Occupancy has been issued, if applicable, by the Buildin I hereby acknowledge that I have read this application and	d the information is correct; I agree to comply with any and all codes, to the project. I understand that failure to comply shall result in legal to non-use of the building(s). Date
Utility Accounting	Date 7/15/0/
VALID FOR SIX MONTHS FROM DATE OF SSHANOI	= (Section 9.3.2C Grand Junction Zoning & Development Code)

(Pink: Building Department)

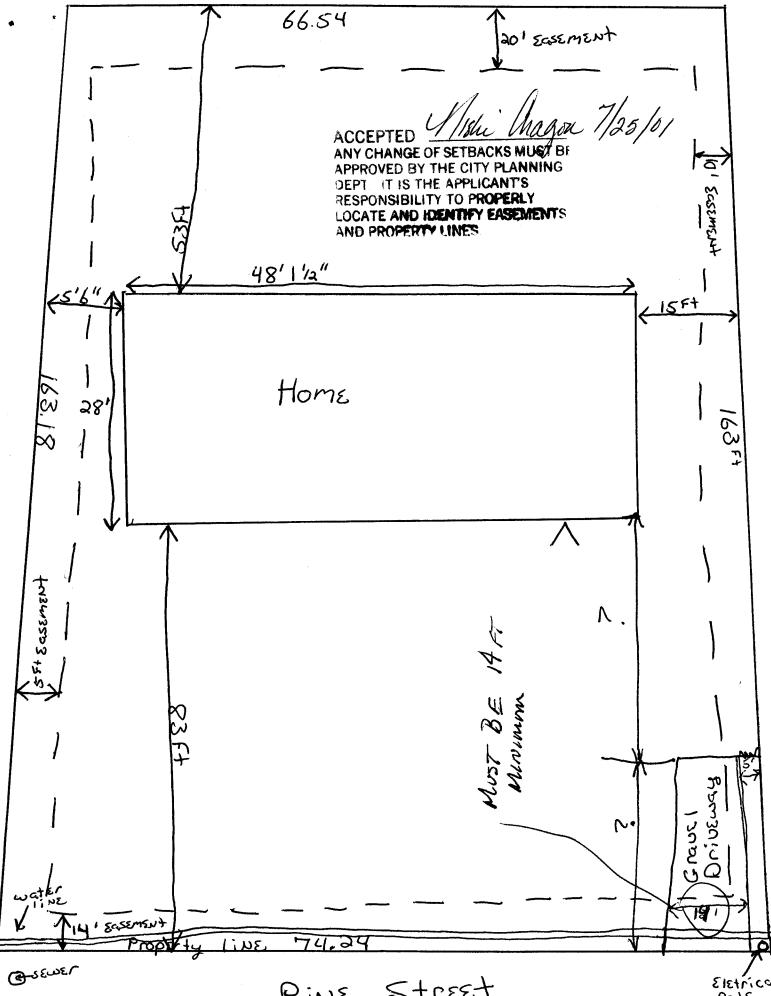

PINE StrEET

Eletrical Pole