

FEE \$	10.00
TCP \$	500.00
SIF \$	292.00

PLANNING CLEARANCE
 (Single Family Residential and Accessory Structures)
Community Development Department

BLDG PERMIT NO. 82673



Your Bridge to a Better Community

BLDG ADDRESS 2441 ROAN RIDGE ROAD SQ. FT. OF PROPOSED BLDGS/ADDITION 1735#

TAX SCHEDULE NO. 2701-333-01001 SQ. FT. OF EXISTING BLDGS —

SUBDIVISION SPANISH TRAILS TOTAL SQ. FT. OF EXISTING & PROPOSED 1735#

FILING 1 BLK 2 LOT 8 NO. OF DWELLING UNITS:
 Before: 0 After: 1 this Construction

(1) OWNER TML ENTERPRISES INC NO. OF BUILDINGS ON PARCEL
 Before: 0 After: 1 this Construction

(1) ADDRESS Box 2569, GJ CO 81502 USE OF EXISTING BUILDINGS SINGLE FAMILY

(1) TELEPHONE 201-8022 DESCRIPTION OF WORK & INTENDED USE SINGLE FAMILY

(2) APPLICANT TML ENTERPRISES INC TYPE OF HOME PROPOSED:
 Site Built Manufactured Home (UBC)
 Manufactured Home (HUD)
 Other (please specify) _____

(2) ADDRESS Box 2569 GJ CO 81502

(2) TELEPHONE 201-8022

REQUIRED: One plot plan, on 8 1/2" x 11" paper, showing all existing & proposed structure location(s), parking, setbacks to all property lines, ingress/egress to the property, driveway location & width & all easements & rights-of-way which abut the parcel.

THIS SECTION TO BE COMPLETED BY COMMUNITY DEVELOPMENT DEPARTMENT STAFF

ZONE PD Maximum coverage of lot by structures _____

SETBACKS: Front 20' from property line (PL) Permanent Foundation Required: YES NO
 or _____ from center of ROW, whichever is greater

Side 5'6" from PL, Rear 20' from PL Parking Req'mt 2

Maximum Height 32' Special Conditions Letter from Engineer Reg'd

CENSUS 9 TRAFFIC 5 ANNEX# _____

Modifications to this Planning Clearance must be approved, in writing, by the Community Development Department. The structure authorized by this application cannot be occupied until a final inspection has been completed and a Certificate of Occupancy has been issued, if applicable, by the Building Department (Section 305, Uniform Building Code).

I hereby acknowledge that I have read this application and the information is correct; I agree to comply with any and all codes, ordinances, laws, regulations or restrictions which apply to the project. I understand that failure to comply shall result in legal action, which may include but not necessarily be limited to non-use of the building(s).

Applicant Signature [Signature] Date _____


Department Approval [Signature] Date 12/19/01

Additional water and/or sewer tap fee(s) are required:	YES <input checked="" type="checkbox"/>	NO <input type="checkbox"/>	W/O No. <u>14443</u>
Utility Accounting <u>[Signature]</u>	Date <u>12/19/01</u>		

VALID FOR SIX MONTHS FROM DATE OF ISSUANCE (Section 9-3-2C Grand Junction Zoning & Development Code)

(White: Planning) (Yellow: Customer) (Pink: Building Department) (Goldenrod: Utility Accounting)

ACCEPTED *SLC 12/19/01*
ANY CHANGE OF SETBACKS MUST BE APPROVED BY THE CITY PLANNING DEPT. IT IS THE APPLICANT'S RESPONSIBILITY TO PROPERLY LOCATE AND IDENTIFY EASEMENTS AND PROPERTY LINES.

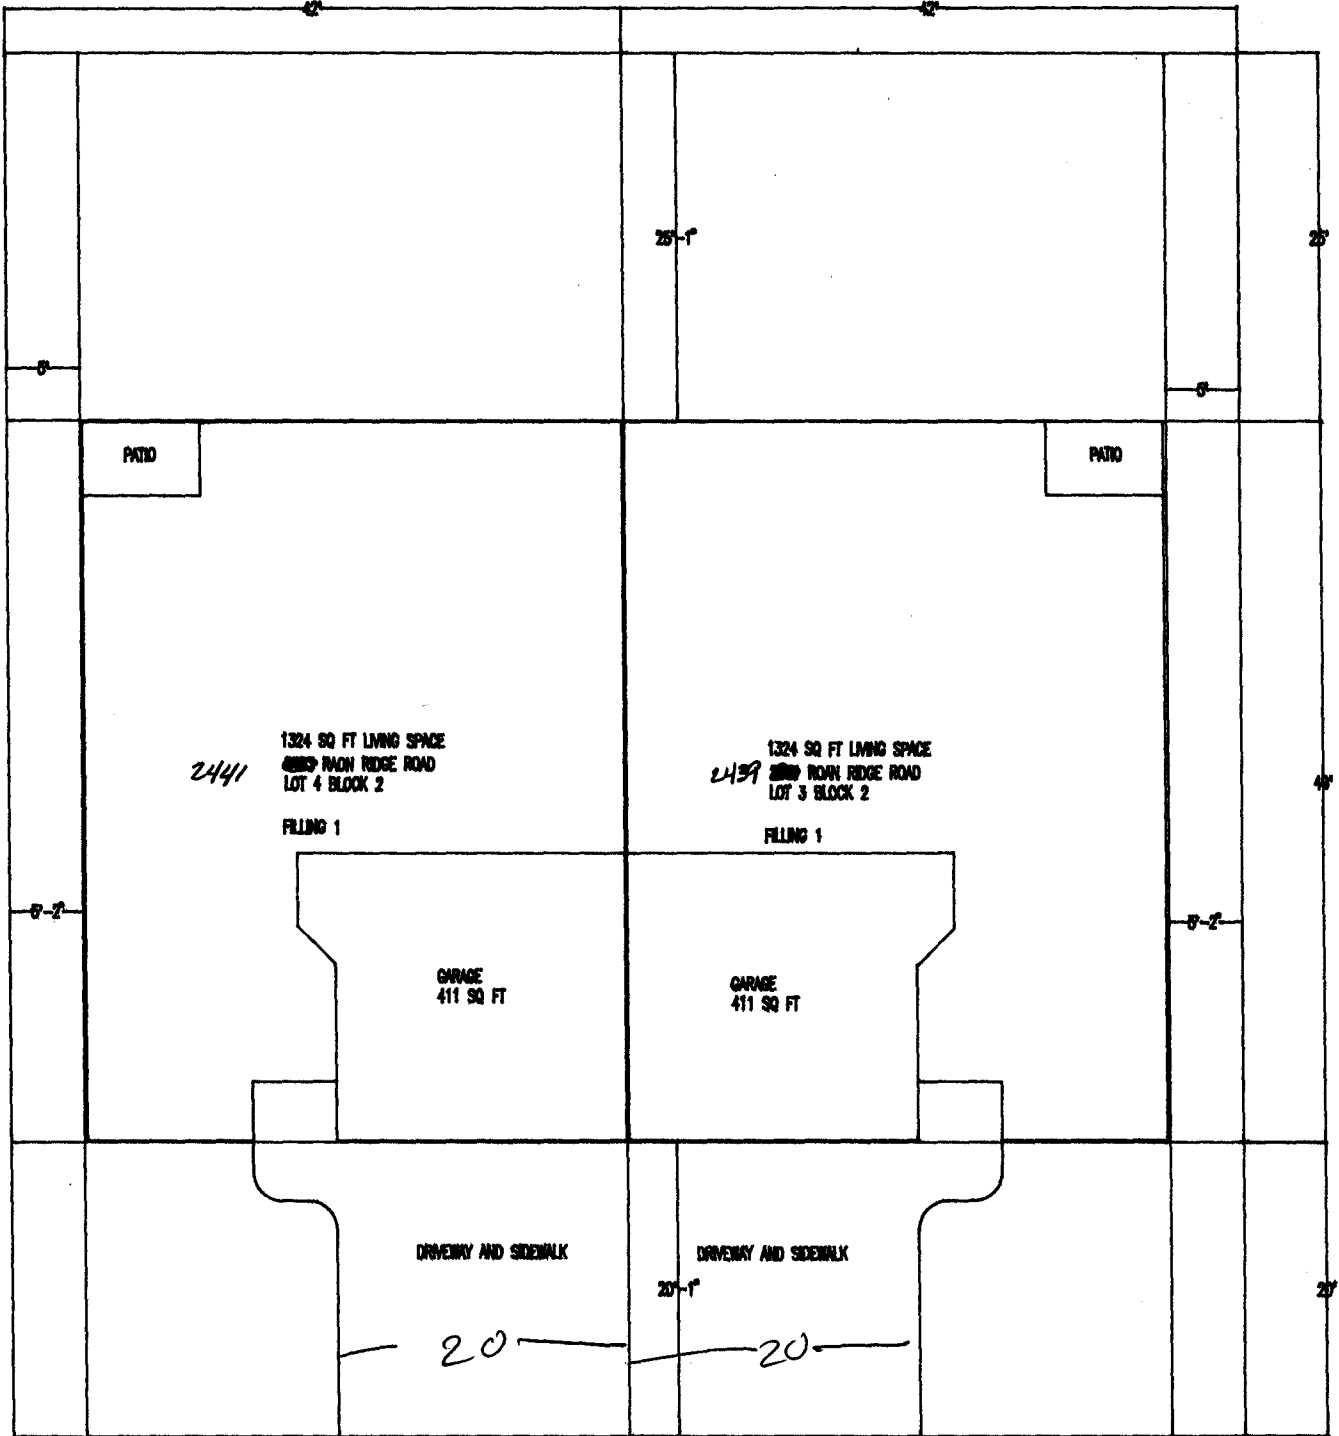

*DRIVE OR
DIP
12/19/01*

ROAN RIDGE ROAD

