

FEE \$	10.00
TCP \$	550.00
SIF \$	292.00

PLANNING CLEARANCE
 (Single Family Residential and Accessory Structures)
Community Development Department

BLDG PERMIT NO. 79101



Your Bridge to a Better Community

BLDG ADDRESS 635 Round Table SQ. FT. OF PROPOSED BLDGS/ADDITION 1644

TAX SCHEDULE NO. 2943-043-00-196 SQ. FT. OF EXISTING BLDGS 0

SUBDIVISION MT VISTA TOTAL SQ. FT. OF EXISTING & PROPOSED 1644

FILING 1 BLK 6 LOT 3

NO. OF DWELLING UNITS:
 Before: 0 After: 1 this Construction
 NO. OF BUILDINGS ON PARCEL
 Before: 0 After: 1 this Construction

(1) OWNER Lee Homes

(1) ADDRESS 3030 FLAMECREST

(1) TELEPHONE 234-1091

(2) APPLICANT [Signature]

(2) ADDRESS [Signature]

(2) TELEPHONE _____

USE OF EXISTING BUILDINGS 0

DESCRIPTION OF WORK & INTENDED USE New Residence

TYPE OF HOME PROPOSED:
 Site Built _____ Manufactured Home (UBC)
 _____ Manufactured Home (HUD)
 _____ Other (please specify) _____

REQUIRED: One plot plan, on 8 1/2" x 11" paper, showing all existing & proposed structure location(s), parking, setbacks to all property lines, ingress/egress to the property, driveway location & width & all easements & rights-of-way which abut the parcel.

THIS SECTION TO BE COMPLETED BY COMMUNITY DEVELOPMENT DEPARTMENT STAFF

ZONE RSF-4 Maximum coverage of lot by structures 50%

SETBACKS: Front 20' from property line (PL) Permanent Foundation Required: YES X NO _____
 or _____ from center of ROW, whichever is greater

Side 7' from PL, Rear 25' from PL Parking Req'mt 2

Maximum Height 36' Special Conditions _____

CENSUS 11 TRAFFIC 40 ANN# _____

Modifications to this Planning Clearance must be approved, in writing, by the Community Development Department. The structure authorized by this application cannot be occupied until a final inspection has been completed and a Certificate of Occupancy has been issued, if applicable, by the Building Department (Section 305, Uniform Building Code).

I hereby acknowledge that I have read this application and the information is correct; I agree to comply with any and all codes, ordinances, laws, regulations or restrictions which apply to the project. I understand that failure to comply shall result in legal action, which may include but not necessarily be limited to non-use of the building(s).

Applicant Signature [Signature] Date 28 Feb 01

Department Approval [Signature] Date 3/5/01


Additional water and/or sewer tap fee(s) are required:	YES <input checked="" type="checkbox"/>	NO <input type="checkbox"/>	WFO No. <u>paid @ CEV.</u>
Utility Accounting <u>[Signature]</u>	Date <u>3/5/01</u>		

VALID FOR SIX MONTHS FROM DATE OF ISSUANCE (Section 9-3-2C Grand Junction Zoning & Development Code)

(White: Planning) (Yellow: Customer) (Pink: Building Department) (Goldenrod: Utility Accounting)

MOUNTAIN VISTA
LOT 3
9479 SQ FT
BLOCK 6
1644-3 CAR

10/8/01
2/2/01
17

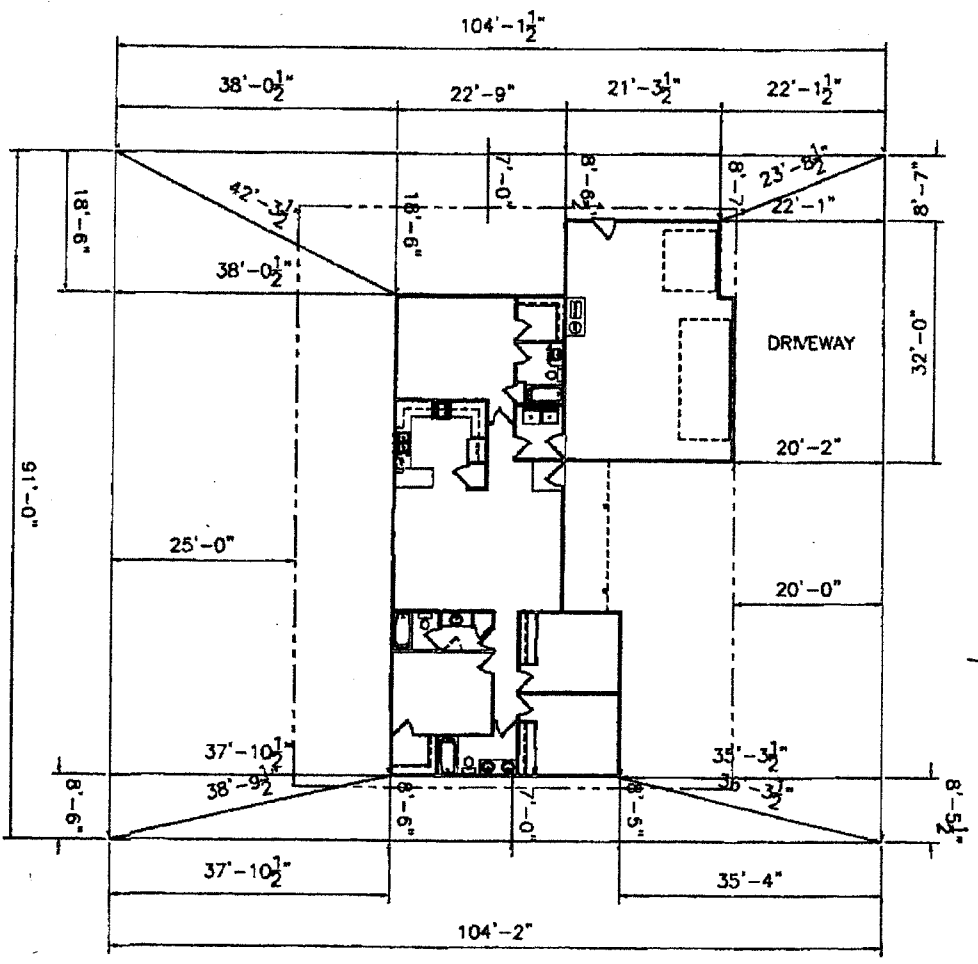

635 ROUND TABLE ROAD

DRIVE OF
DRP
3/1/01

ACCEPTED
 ANY CHANGE OF SETBACKS MUST BE
 APPROVED BY THE CITY PLANNING
 DEPT. IT IS THE APPLICANT'S
 RESPONSIBILITY TO PROPERLY
 LOCATE AND IDENTIFY EASEMENTS
 AND PROPERTY LINES.