FEE\$	10.00	
TCP\$		


PLANNING CLEARANCE

BLDG PERMIT NO.	78730

SIF \$ 292.00

(Single Family Residential and Accessory Structures) **Community Development Department**

· -	Your Bridge to a Better Community
BLDG ADDRESS 650 Starlight	SQ. FT. OF PROPOSED BLDGS/ADDITION 1904
TAX SCHEDULE NO. 2943-042-58-004	SQ. FT. OF EXISTING BLDGS
SUBDIVISION Fairclowa	TOTAL SQ. FT. OF EXISTING & PROPOSED 1904
FILING 3 BLK 3 LOT 1	NO. OF DWELLING UNITS:
(1) OWNER Grand Ridge Properties	
(1) ADDRESS 3032 1-70 B. Loop	Before: After: this Construction
(1) TELEPHONE 434 - 41e16	USE OF EXISTING BUILDINGS NA Sunda
(2) APPLICANT <u>Erreat Services</u>	DESCRIPTION OF WORK & INTENDED USE Single Family Les dence
(2) ADDRESS 3032 1-70 B. LOOP	TYPE OF HOME PROPOSED: Site Built Manufactured Home (UBC)
(2) TELEPHONE 434 - 4616	Manufactured Home (HUD) Other (please specify)
	all existing & proposed structure location(s), parking, setbacks to all cation & width & all easements & rights-of-way which abut the parcel.
THIS SECTION TO BE COMPLETED BY CONTENT OF THE SECTION TO BE CO	Parking Reg'mt
structure authorized by this application cannot be occup Occupancy has been issued, if applicable, by the Buildin	
	the information is correct; I agree to comply with any and all codes, to the project. I understand that failure to comply shall result in legal to non-use of the building(s).
Applicant Signature / Kel N M C	GMGNIT Date Z-2-01
Department Approval 4/18hu Magor	Date 2/22/0/
Additional water and/or sewer tap fee(s) are required:	YES NO WOND COVE
Utility Accounting Labi () Uchol	T Date 2 22 101

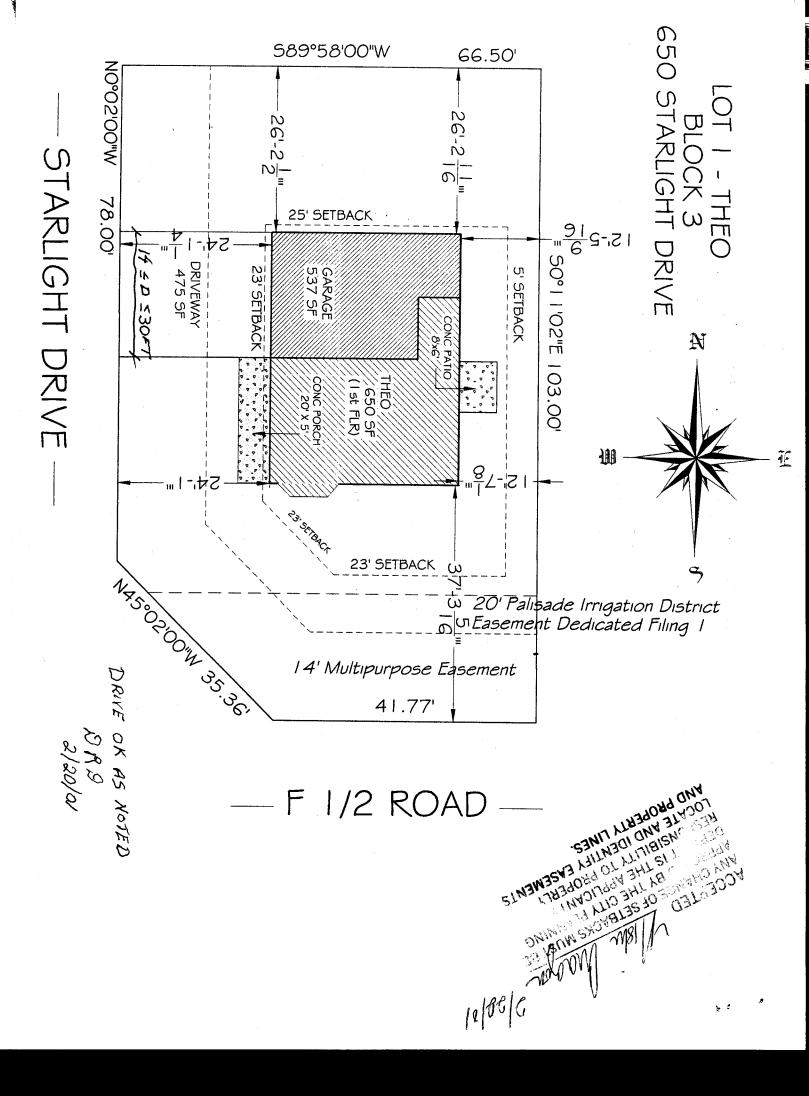



529 25 1/2 Road, Suite B-101 Grand Junction, Colorado 81505 (970) 241-7700 • Fax (970) 241-7783

E-mail: wct@gj.net

Website: www.westerncolorado.com

February 9, 2001 WCT #200901

Great New Homes, Ltd. 3032 I-70 Business Loop Grand Junction, Colorado 81504

Attn: Pat Mullennix

Development Superintendent

Subject: 650 Starlight Drive

Grand Junction, Colorado

Faircloud Subdivision, Filings II & III

At your request, on February 9, 2001, we observed the soil conditions in the foundation excavation at the above referenced address. The purpose of our work was to determine if fill of an unknown nature, or if soft virgin soils are present below the proposed footings. This is a requirement of City of Grand Junction Planning Commission, Final Decision FPP-1999-280.

At the time of our visit, the foundation area had been excavated in preparation for a monolithic slab. The area was level, wheel-rolled and covered with plastic.

Two Test holes were hand augered within the proposed building location. Holes were three to four feet in depth and located on the East and West sides of the excavation.

The soils were non-expansive, slightly moist, and comprised of native light brown silty clay with sand and gypsum. Soil type and gradation was consistent throughout the augered depth.

This building location lies partially on a fill area which was originally a drainage ditch. Our records indicate that this was back-filled with native soils which were bernned along the ditch and also from excavation of on-site roadway. WESTERN COLORADO TESTING, INC., did not observe the complete back-filling, but was routinely involved in the moisture/density testing of the procedure. Blending of moisture was accomplished with an excavator with compacting of 12-inch lifts being accomplished by 950 loader. Our records indicate that project requirements were met with regard to density and compaction requirements.

Our visual observations indicated that no unknown fill or soft soil conditions are present.

If you have any questions or if we may be of further assistance, please do not hesitate to contact us.

Respectfully Submitted: WESTERN COLORADO TESTING,

Michael J. Weigand, PE

1914

2009L0209C