FEE\$	10.00
TCP\$	_
SIF\$	292.00


PLANNING CLEARANCE

Community Development Department

(Single Family Residential and Accessory Structures)

BLDG PERMIT NO.

· · · · · ·	×	Your Bridge to a Better Community
BLDG ADDRESS US Starlight Dr.	SQ. FT. OF PROPOSED BLDG	S/ADDITION
TAX SCHEDULE NO. 2943-042-58-009	SQ. FT. OF EXISTING BLDGS	d
SUBDIVISION Faircloud	TOTAL SQ. FT. OF EXISTING 8	R PROPOSED
FILING <u>8</u> BLK <u>3</u> LOT <u>8</u>	NO. OF DWELLING UNITS:	this Construction
11) OWNER Grand Ridge Properties	Before: After: NO. OF BUILDINGS ON PARC	
(1) ADDRESS 3032 F70 Bus logs	Before: Ø After: USE OF EXISTING BUILDINGS	-
(1) TELEPHONE 434-4616		
(2) APPLICANT <u>Great Services</u>		NDED USE SINGLE FAMILY (CONDENCE
(2) ADDRESS 3032 1-70 Bus loop		nufactured Home (UBC)
(2) TELEPHONE 434- 4616	Manufactured Home (HU Other (please specify)	,
REQUIRED: One plot plan, on 8 ½" x 11" paper, showing a property lines, ingress/egress to the property, driveway lo		
THIS SECTION TO BE COMPLETED BY CO		1149
ZONE 78'	Maximum coverage of	-
SETBACKS: Front from property line (PL) or from center of ROW, whichever is greater		Required: YES X NO
Side 5 from PL, Rear 25 from P	Parking Req'mt L Special Conditions	anuras a Centant Fra
Maximum Height35 '	WOOROVAL	AFFIC 46 ANNX#
	CENSOS TRA	AFFIC 700 ANIVAR
Modifications to this Planning Clearance must be approstructure authorized by this application cannot be occup Occupancy has been issued, if applicable, by the Buildir	ied until a final inspection has be	een completed and a Certificate of
I hereby acknowledge that I have read this application and ordinances, laws, regulations or restrictions which apply t action, which may include but not necessarily be limited	o the project. I understand that fa to non-use of the building(s).	ailure to comply shall result in legal
Applicant Signature Man Co	ngisit Date]	- 22-01 - 6 -01
Department Approval Rome Dev	ails Date 2-	6-01
Additional water and/or sewer tap fee(s) are required:	YES NO	Wasa Cav
Utility Accounting	Date 2	
VALID FOR SIX MONTHS FROM DATE OF ISSUANCE	(Section 9-3-2C Grand Junction	Zoning & Development Code)

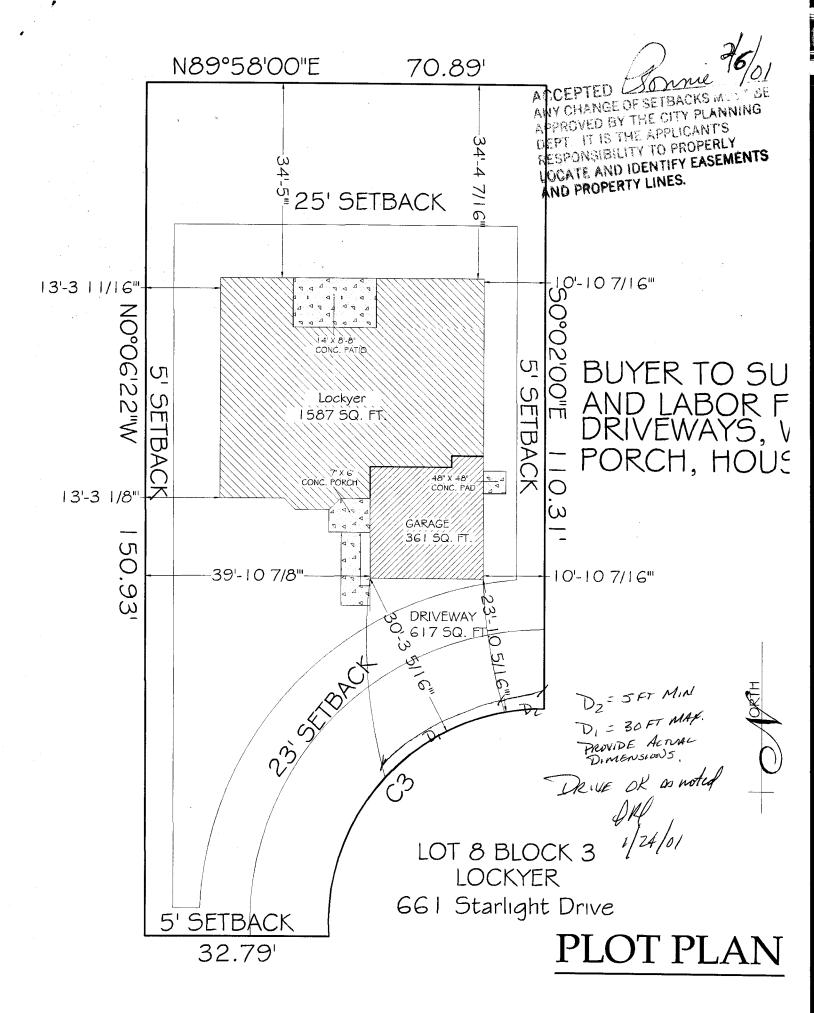



529 25 1/2 Road, Suite B 101 Grand Junction, Colorado 81505 (970) 241-7700 • Fax (970) 241-7783

F-mail: wct@gj.net

Website: www.westerncolorado.com

February 6, 2001 WCT # 200901

Great New Homes, Ltd. 3032 I-70 Business Loop Grand Junction, Colorado 81504

Attn: Pat Mullennix

Development Superintendent

Subject: 661 Starlight Drive

Grand Junction, Colorado

Faircloud Subdivision, Filings II & III

At your request, on February 5, 2001, we observed the soil conditions in the foundation excavation at the above referenced address. The purpose of our work was to determine if fill of an unknown nature, or if soft virgin soils are present below the proposed footings. This is a requirement of City of Grand Junction Planning Commission, Final Decision FPP-1999-280.

At the time of our visit, the foundation area had been excavated in preparation for a monolithic slab. The area was level, and had been wheel-rolled.

Two test holes were hand-augered within the proposed building location. Holes were three to four feet in depth and located on the East and West sides of the excavation.

The soils were non-expansive, slightly moist, and comprised of native light brown silty clay with sand and gypsum. Soil type and gradation was consistent throughout the augered depth.

Our visual observations indicated that no unknown fill or soft soil conditions are present.

If you have any questions or if we may be of further assistance, please do not hesitate to contact us.

Respectfully Submitted:

WESTERN COLORADO TESTING,

Michael J. Weigand, P.E.

40440

Msb:jobs/2009L0206