

Planning \$ <u>10.00</u>	Drainage \$
TCP \$	School Impact \$ <u>292.00</u>

BLDG PERMIT NO. <u>78514</u>
FILE #

PLANNING CLEARANCE

(site plan review, multi-family development, non-residential development)
Grand Junction Community Development Department

Single Family Home

THIS SECTION TO BE COMPLETED BY APPLICANT

BUILDING ADDRESS <u>2074 STABLECOACH COURT</u>	TAX SCHEDULE NO. <u>2947-151-40-010</u>
SUBDIVISION <u>INDEPENDENCE RANCH</u>	SQ. FT. OF PROPOSED BLDG(S)/ADDITION <u>3200 sq'</u>
FILING <u>5</u> BLK <u>2</u> LOT <u>10</u>	SQ. FT. OF EXISTING BLDG(S) <u>N/A</u>
OWNER <u>Distinction Real Estate Builders</u>	NO. OF DWELLING UNITS: BEFORE <u>0</u> AFTER <u>1</u>
ADDRESS <u>1255 21 RD GRAND JCT</u>	CONSTRUCTION
TELEPHONE <u>858-9091</u>	NO. OF BLDGS ON PARCEL: BEFORE <u>0</u> AFTER <u>1</u>
APPLICANT <u>SAME</u>	CONSTRUCTION
ADDRESS _____	USE OF ALL EXISTING BLDGS <u>N/A</u>
TELEPHONE _____	DESCRIPTION OF WORK & INTENDED USE: _____
✓ Submittal requirements are outlined in the SSID (Submittal Standards for Improvements and Development) document.	

THIS SECTION TO BE COMPLETED BY COMMUNITY DEVELOPMENT DEPARTMENT STAFF

ZONE <u>PD</u>	LANDSCAPING/SCREENING REQUIRED: YES _____ NO <u>X</u>
SETBACKS: FRONT: <u>25'</u> from Property Line (PL) or from center of ROW, whichever is greater	PARKING REQUIREMENT: _____
SIDE: <u>10'</u> from PL REAR: <u>20'</u> from PL	SPECIAL CONDITIONS: _____
MAXIMUM HEIGHT <u>32'</u>	_____
MAXIMUM COVERAGE OF LOT BY STRUCTURES <u>35%</u>	CENSUS TRACT <u>1402</u> TRAFFIC ZONE <u>88</u> ANNEX _____

Modifications to this Planning Clearance must be approved, in writing, by the Community Development Department Director. The structure authorized by this application cannot be occupied until a final inspection has been completed and a Certificate of Occupancy has been issued by the Building Department (Section 307, Uniform Building Code). Required improvements in the public right-of-way must be guaranteed prior to issuance of a Planning Clearance. All other required site improvements must be completed or guaranteed prior to issuance of a Certificate of Occupancy. Any landscaping required by this permit shall be maintained in an acceptable and healthy condition. The replacement of any vegetation materials that die or are in an unhealthy condition is required by the Grand Junction Zoning and Development Code.

Four (4) sets of final construction drawings must be submitted and stamped by City Engineering prior to issuing the Planning Clearance. One stamped set must be available on the job site at all times.


I hereby acknowledge that I have read this application and the information is correct; I agree to comply with any and all codes, ordinances, laws, regulations, or restrictions which apply to the project. I understand that failure to comply shall result in legal action, which may include but not necessarily be limited to non-use of the building(s).

Applicant's Signature <u>[Signature]</u>	Date <u>2/9/01</u>
Department Approval <u>[Signature]</u>	Date <u>2/9/01</u>

Additional water and/or sewer tap fee(s) are required:	YES <input checked="" type="checkbox"/>	NO <input type="checkbox"/>	W/O No. <u>1378</u>
Utility Accounting <u>[Signature]</u>	Date <u>2/9/01</u>		

VALID FOR SIX MONTHS FROM DATE OF ISSUANCE (Section 9-3-2C Grand Junction Zoning and Development Code)

(White: Planning) (Yellow: Customer) (Pink: Building Department) (Goldenrod: Utility Accounting)

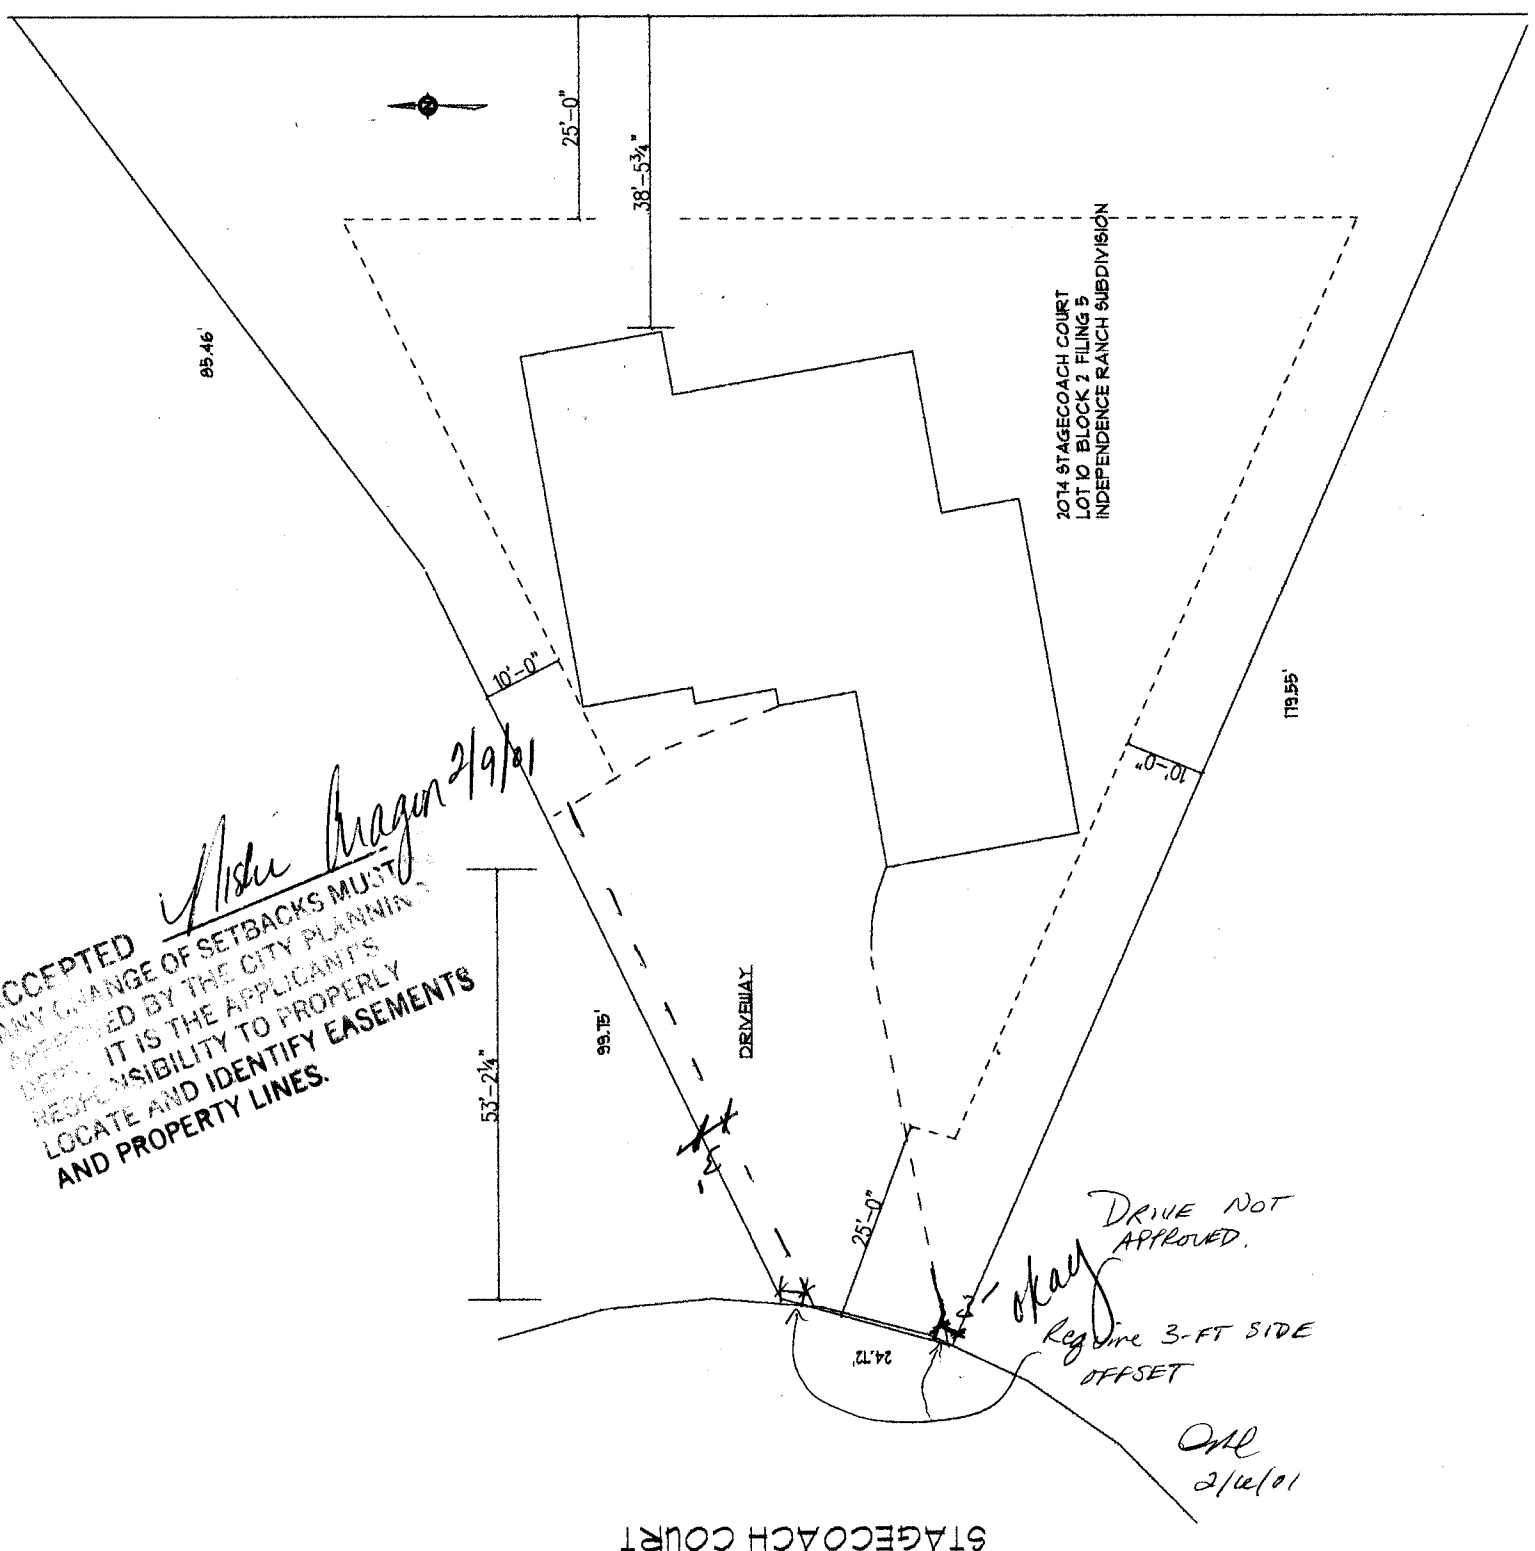

ACCEPTED
 ANY CHANGE OF SETBACKS MUST
 BE APPROVED BY THE CITY PLANNING
 DEPT. IT IS THE APPLICANT'S
 RESPONSIBILITY TO PROPERLY
 LOCATE AND IDENTIFY EASEMENTS
 AND PROPERTY LINES.

Alida Wagner 2/9/01

DRIVE NOT APPROVED.
okay
 Require 3-FT SIDE OFFSET

OML
2/12/01

STAGECOACH COURT