

| | |
|--------|--------|
| FEE \$ | 10.00 |
| TCP \$ | 0 |
| SIF \$ | 292.00 |

PLANNING CLEARANCE
 (Single Family Residential and Accessory Structures)
Community Development Department

BLDG PERMIT NO. 78887



Your Bridge to a Better Community

BLDG ADDRESS 2989 1/2 Summer Brodc SQ. FT. OF PROPOSED BLDGS/ADDITION 1275

TAX SCHEDULE NO. 2943-051-00-069 SQ. FT. OF EXISTING BLDGS —

SUBDIVISION Brook Side TOTAL SQ. FT. OF EXISTING & PROPOSED 1675

FILING 1 BLK 3 LOT 5 NO. OF DWELLING UNITS:
 Before: 0 After: 1 this Construction

(1) OWNER Darter LLC NO. OF BUILDINGS ON PARCEL
 Before: 0 After: 1 this Construction

(1) ADDRESS 786 Valley Ct USE OF EXISTING BUILDINGS NA

(1) TELEPHONE 523-5555 DESCRIPTION OF WORK & INTENDED USE New Residence

(2) APPLICANT Grace Homes Const TYPE OF HOME PROPOSED:
 Site Built Manufactured Home (UBC)
 Manufactured Home (HUD)
 Other (please specify) _____

(2) ADDRESS 786 Valley Ct GJ

(2) TELEPHONE 523-5555

REQUIRED: One plot plan, on 8 1/2" x 11" paper, showing all existing & proposed structure location(s), parking, setbacks to all property lines, ingress/egress to the property, driveway location & width & all easements & rights-of-way which abut the parcel.

THIS SECTION TO BE COMPLETED BY COMMUNITY DEVELOPMENT DEPARTMENT STAFF

ZONE PD Maximum coverage of lot by structures 45%

SETBACKS: Front 20' from property line (PL) Permanent Foundation Required: YES NO
 or _____ from center of ROW, whichever is greater

Side 5' from PL, Rear 20' from PL Parking Req'mt 2

Maximum Height 32' Special Conditions _____

CENSUS 11 TRAFFIC 45 ANN# _____

Modifications to this Planning Clearance must be approved, in writing, by the Community Development Department. The structure authorized by this application cannot be occupied until a final inspection has been completed and a Certificate of Occupancy has been issued, if applicable, by the Building Department (Section 305, Uniform Building Code).

I hereby acknowledge that I have read this application and the information is correct; I agree to comply with any and all codes, ordinances, laws, regulations or restrictions which apply to the project. I understand that failure to comply shall result in legal action, which may include but not necessarily be limited to non-use of the building(s).

Applicant Signature [Signature] Date 3/1/2001


Department Approval [Signature] Date 3-16-01

| | | | |
|--|---|-----------------------------|-----------------------------|
| Additional water and/or sewer tap fee(s) are required: | YES <input checked="" type="checkbox"/> | NO <input type="checkbox"/> | W/O No. <u>see attached</u> |
| Utility Accounting | <u>[Signature]</u> | Date | <u>3/16/01</u> |

VALID FOR SIX MONTHS FROM DATE OF ISSUANCE (Section 9-3-2C Grand Junction Zoning & Development Code)


(White: Planning) (Yellow: Customer) (Pink: Building Department) (Goldenrod: Utility Accounting)

S 76°54'44" E
2989 1/2 SUMMERBROOK DRIVE
N 76°54'44" W

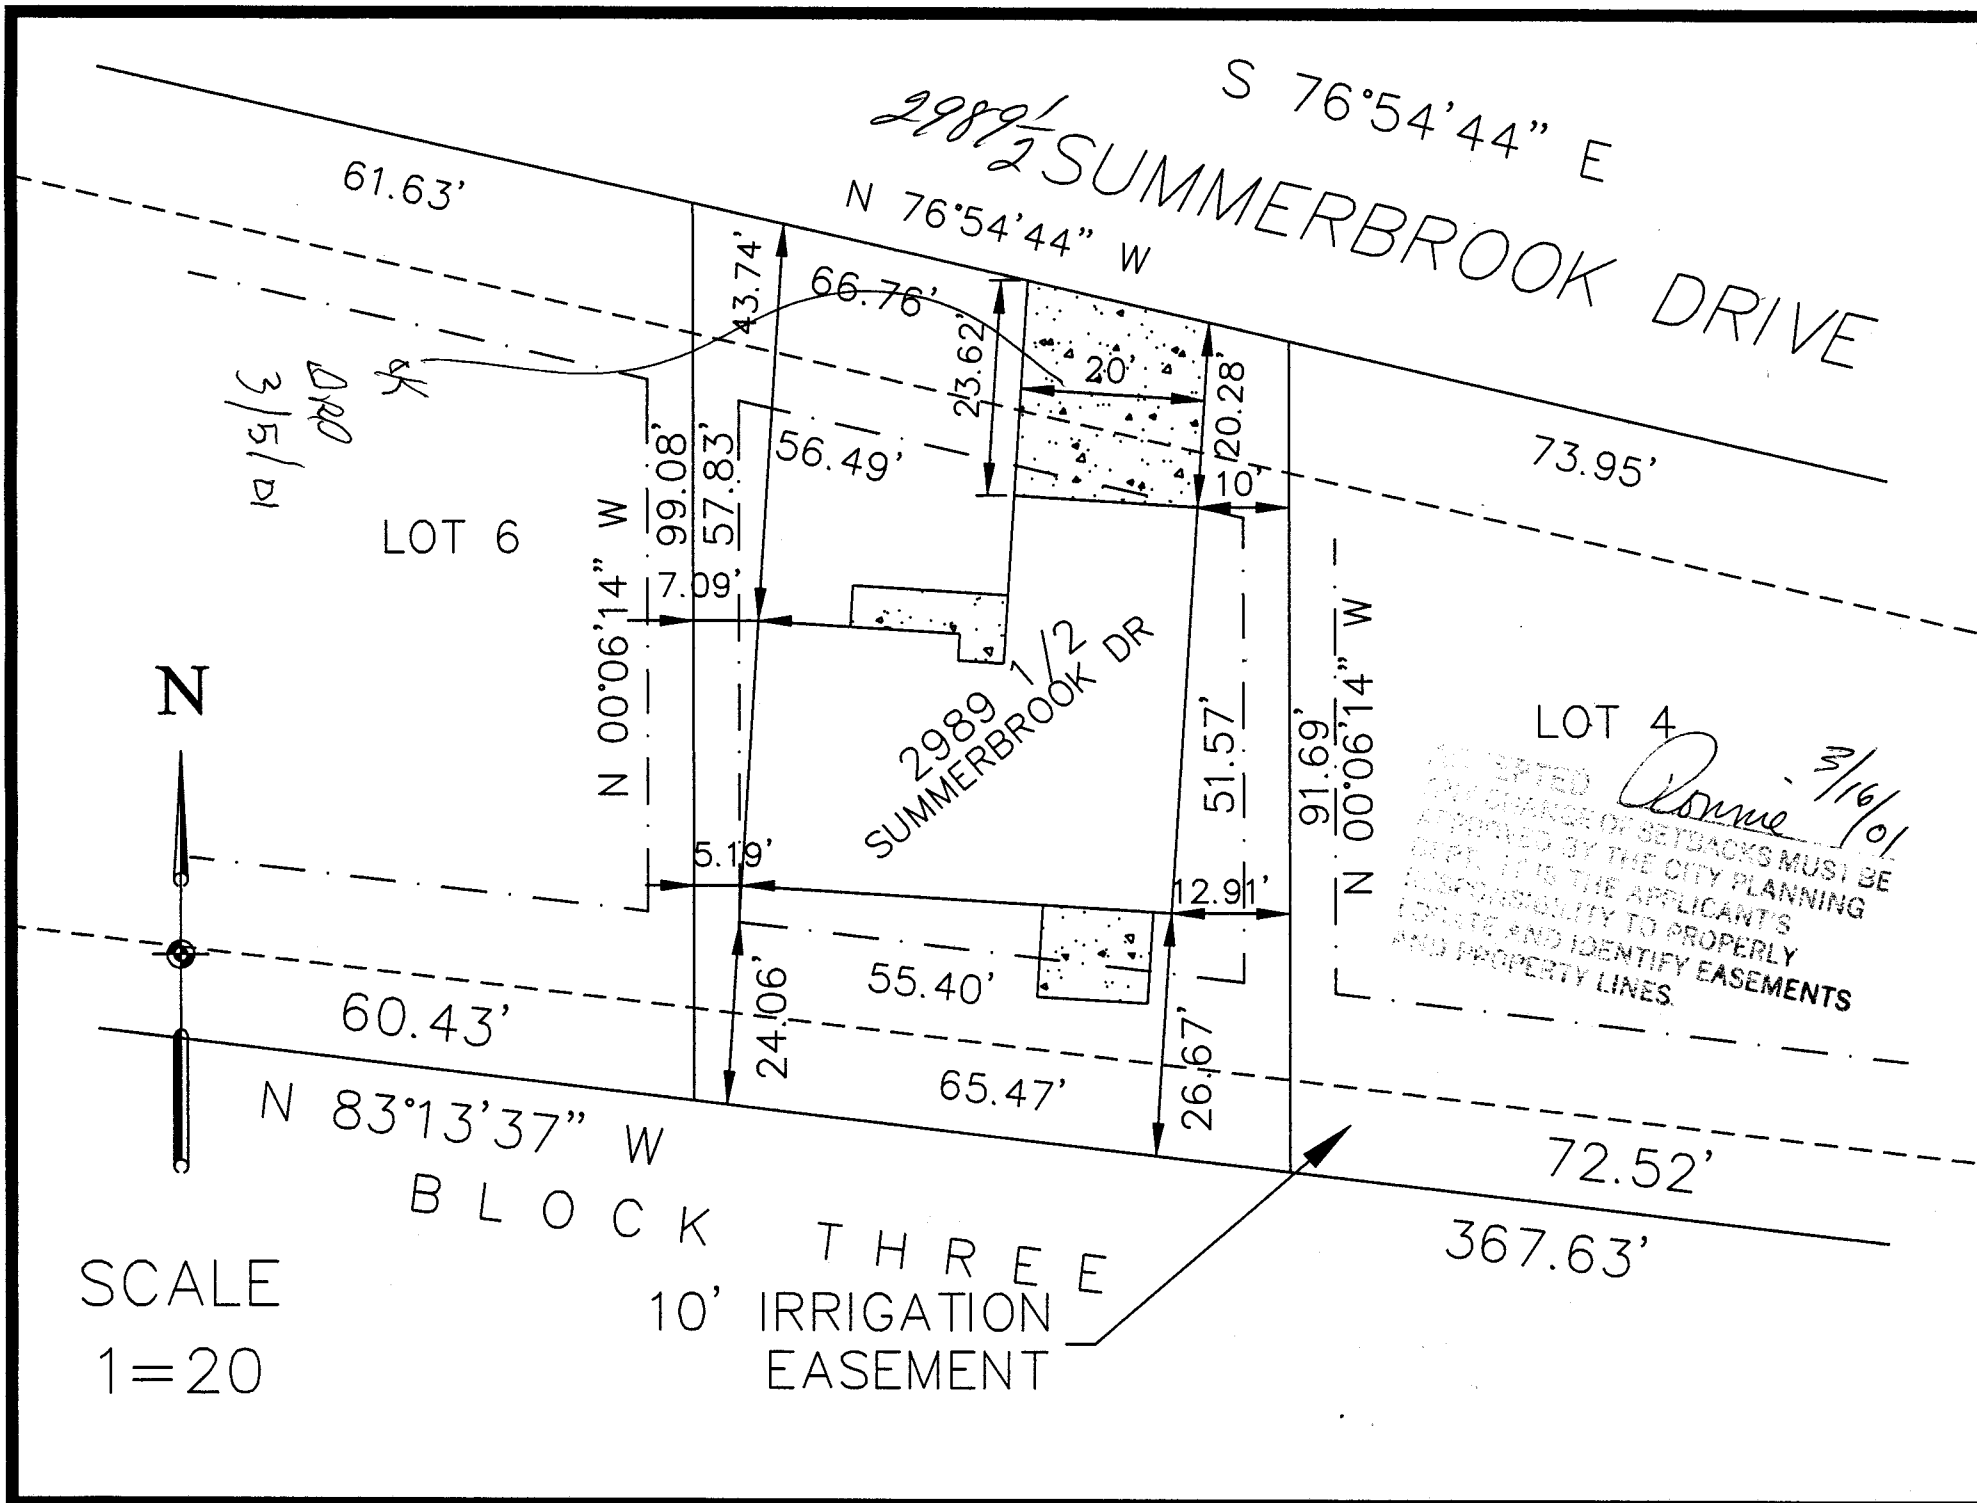

DRD
3/5/01

LOT 6

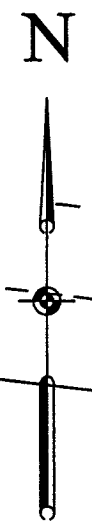

SCALE
1=20

N 83°13'37" W
BLOCK THREE
10' IRRIGATION
EASEMENT

LOT 4
ACCEPTED
3/16/01
ALL CHANGES OF SETBACKS MUST BE
APPROVED BY THE CITY PLANNING
DEPT. IT IS THE APPLICANT'S
RESPONSIBILITY TO PROPERLY
LOCATE AND IDENTIFY EASEMENTS
AND PROPERTY LINES.