

FEE \$	10.00
TCP \$	-
SIF \$	292.00

PLANNING CLEARANCE

(Single Family Residential and Accessory Structures)

Community Development Department

BLDG PERMIT NO. 78787



Your Bridge to a Better Community

BLDG ADDRESS 2991 Summer Brook Dr SQ. FT. OF PROPOSED BLDGS/ADDITION 1116

TAX SCHEDULE NO 2943-051-00-069 SQ. FT. OF EXISTING BLDGS 0

SUBDIVISION BrookSide TOTAL SQ. FT. OF EXISTING & PROPOSED 1516 w/garage

FILING 1 BLK 3 LOT 4 NO. OF DWELLING UNITS:
 Before: 0 After: 1 this Construction

(1) OWNER Darter LLC NO. OF BUILDINGS ON PARCEL
 Before: 0 After: 1 this Construction

(1) ADDRESS 524 #4 30rd GJ CO 81504 USE OF EXISTING BUILDINGS NA

(1) TELEPHONE 523-5555 DESCRIPTION OF WORK & INTENDED USE New Residence

(2) APPLICANT Grace Homes Const. TYPE OF HOME PROPOSED:
 (2) ADDRESS 524 #4 30rd GJ CO 81504 Site Built Manufactured Home (UBC)
 Manufactured Home (HUD)
 Other (please specify) _____

(2) TELEPHONE 523-5555

REQUIRED: One plot plan, on 8 1/2" x 11" paper, showing all existing & proposed structure location(s), parking, setbacks to all property lines, ingress/egress to the property, driveway location & width & all easements & rights-of-way which abut the parcel.

THIS SECTION TO BE COMPLETED BY COMMUNITY DEVELOPMENT DEPARTMENT STAFF

ZONE PD Maximum coverage of lot by structures _____

SETBACKS: Front 20' from property line (PL) Permanent Foundation Required: YES NO _____
 or _____ from center of ROW, whichever is greater

Side 5' from PL, Rear 20' from PL Parking Req'mt 2

Maximum Height 32 Special Conditions _____

CENSUS 11 TRAFFIC 45 ANN# _____

Modifications to this Planning Clearance must be approved, in writing, by the Community Development Department. The structure authorized by this application cannot be occupied until a final inspection has been completed and a Certificate of Occupancy has been issued, if applicable, by the Building Department (Section 305, Uniform Building Code).

I hereby acknowledge that I have read this application and the information is correct; I agree to comply with any and all codes, ordinances, laws, regulations or restrictions which apply to the project. I understand that failure to comply shall result in legal action, which may include but not necessarily be limited to non-use of the building(s).

Applicant Signature Jeann Capant Date 2/21/2001

Department Approval Misha Wagon Date 3/7/01


Additional water and/or sewer tap fee(s) are required:	YES	NO	W/O No.
Utility Accounting	<u>CM Order</u>		Date <u>3/7/01</u>

VALID FOR SIX MONTHS FROM DATE OF ISSUANCE (Section 9-3-2C Grand Junction Zoning & Development Code)

(White: Planning) (Yellow: Customer) (Pink: Building Department) (Goldenrod: Utility Accounting)


011

ACCEPTED *Wishu Oregon 3/7/01*
ANY CHANGE OF SETBACKS MUST BE APPROVED BY THE CITY PLANNING DEPT. IT IS THE APPLICANT'S RESPONSIBILITY TO PROPERLY LOCATE AND IDENTIFY EASEMENTS AND PROPERTY LINES.

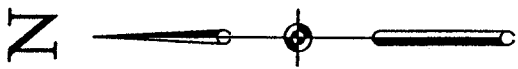

SCALE
1=20

SUMMERBROOK DRIVE
(RIGHT-OF-WAY)

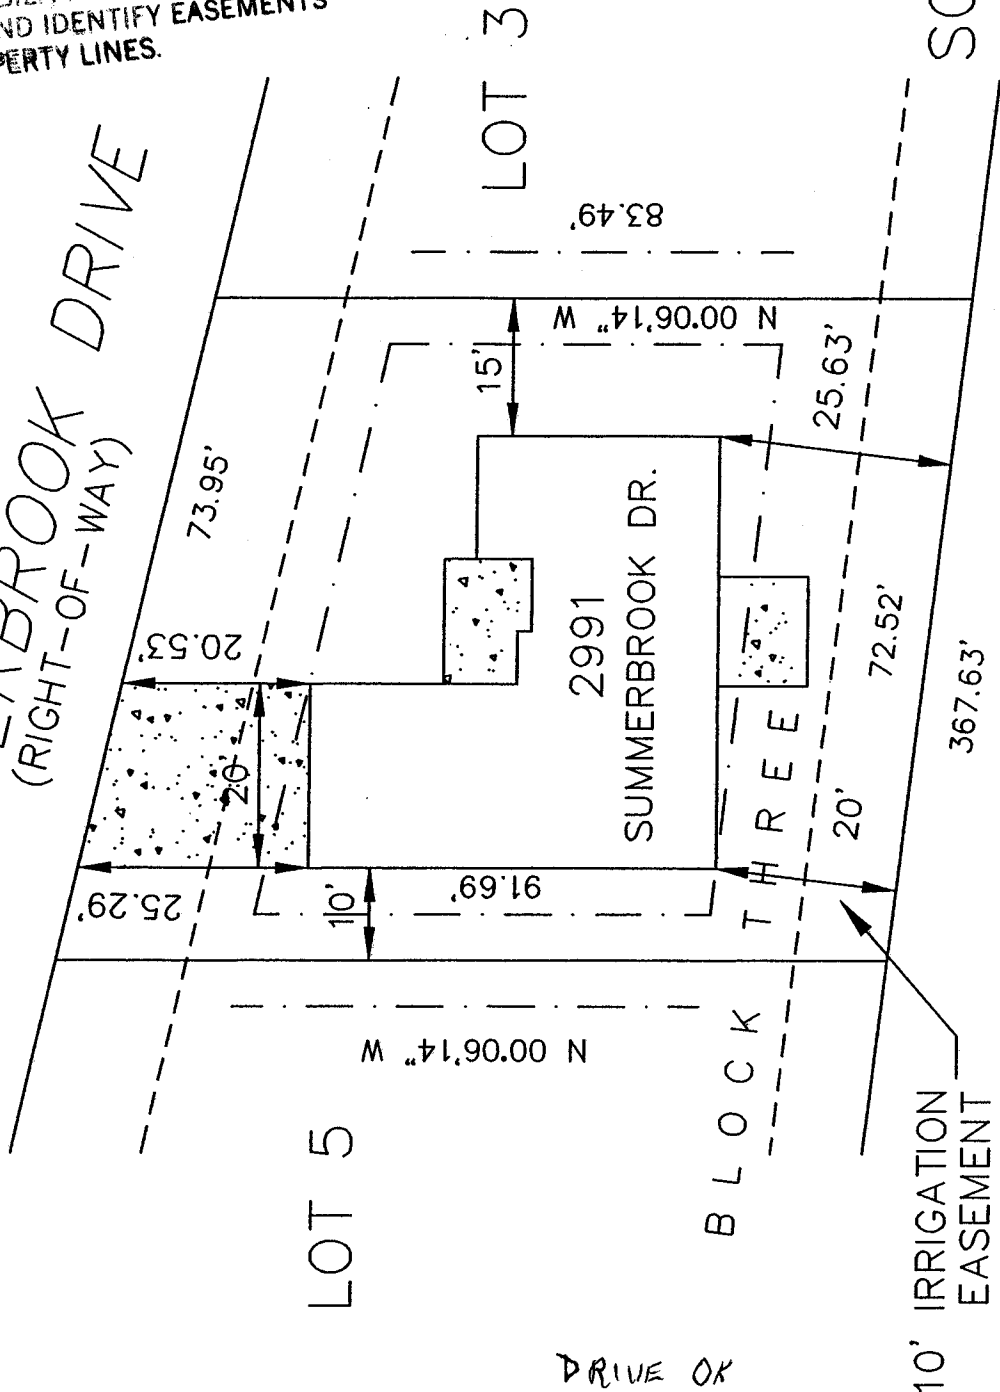

DRIVE OK
DRD
2/22/01