

FEE \$	10.00
TCP \$	0
SIF \$	292.00

PLANNING CLEARANCE
 (Single Family Residential and Accessory Structures)
Community Development Department

BLDG PERMIT NO. 82609



Your Bridge to a Better Community

BLDG ADDRESS 456 S. Sun Court SQ. FT. OF PROPOSED BLDGS/ADDITION 1571

TAX SCHEDULE NO. 2943-161-95-009 SQ. FT. OF EXISTING BLDGS 0

SUBDIVISION Fruitvale Meadows TOTAL SQ. FT. OF EXISTING & PROPOSED 1571

FILING 1 BLK 1 LOT 9 NO. OF DWELLING UNITS:
 Before: 0 After: 1 this Construction

(1) OWNER Leslie T. Pack NO. OF BUILDINGS ON PARCEL
 Before: 0 After: 1 this Construction

(1) ADDRESS P.O. Box 4051 G5 #1532 USE OF EXISTING BUILDINGS N/A

(1) TELEPHONE 241-2871 ext 26 message DESCRIPTION OF WORK & INTENDED USE New Single Family Residence

(2) APPLICANT SAME AS TYPE OF HOME PROPOSED:
 Site Built Manufactured Home (UBC)
 Manufactured Home (HUD) Other (please specify) _____

(2) ADDRESS ABOVE

(2) TELEPHONE _____

REQUIRED: One plot plan, on 8 1/2" x 11" paper, showing all existing & proposed structure location(s), parking, setbacks to all property lines, ingress/egress to the property, driveway location & width & all easements & rights-of-way which abut the parcel.

THIS SECTION TO BE COMPLETED BY COMMUNITY DEVELOPMENT DEPARTMENT STAFF

ZONE RMF-5 Maximum coverage of lot by structures 60%

SETBACKS: Front 20' from property line (PL) Permanent Foundation Required: YES NO
 or _____ from center of ROW, whichever is greater

Side 5' from PL, Rear 25' from PL Parking Req'mt 2

Maximum Height 35' Special Conditions _____

CENSUS 8 TRAFFIC 57 ANN# _____

Modifications to this Planning Clearance must be approved, in writing, by the Community Development Department. The structure authorized by this application cannot be occupied until a final inspection has been completed and a Certificate of Occupancy has been issued, if applicable, by the Building Department (Section 305, Uniform Building Code).

I hereby acknowledge that I have read this application and the information is correct; I agree to comply with any and all codes, ordinances, laws, regulations or restrictions which apply to the project. I understand that failure to comply shall result in legal action, which may include but not necessarily be limited to non-use of the building(s).

Applicant Signature Leslie T. Pack Date 12-7-01

Department Approval C. J. Jaye Date 12/13/01


Additional water and/or sewer tap fee(s) are required:	YES <input checked="" type="checkbox"/>	NO <input type="checkbox"/>	W/O No. <u>14432</u>
Utility Accounting	<u>J. Bensley</u>	Date	<u>12/13/01</u>

VALID FOR SIX MONTHS FROM DATE OF ISSUANCE (Section 9-3-2C Grand Junction Zoning & Development Code)

(White: Planning) (Yellow: Customer) (Pink: Building Department) (Goldenrod: Utility Accounting)

S. SUN CT.

DRIVE OK
AND
12/10/01

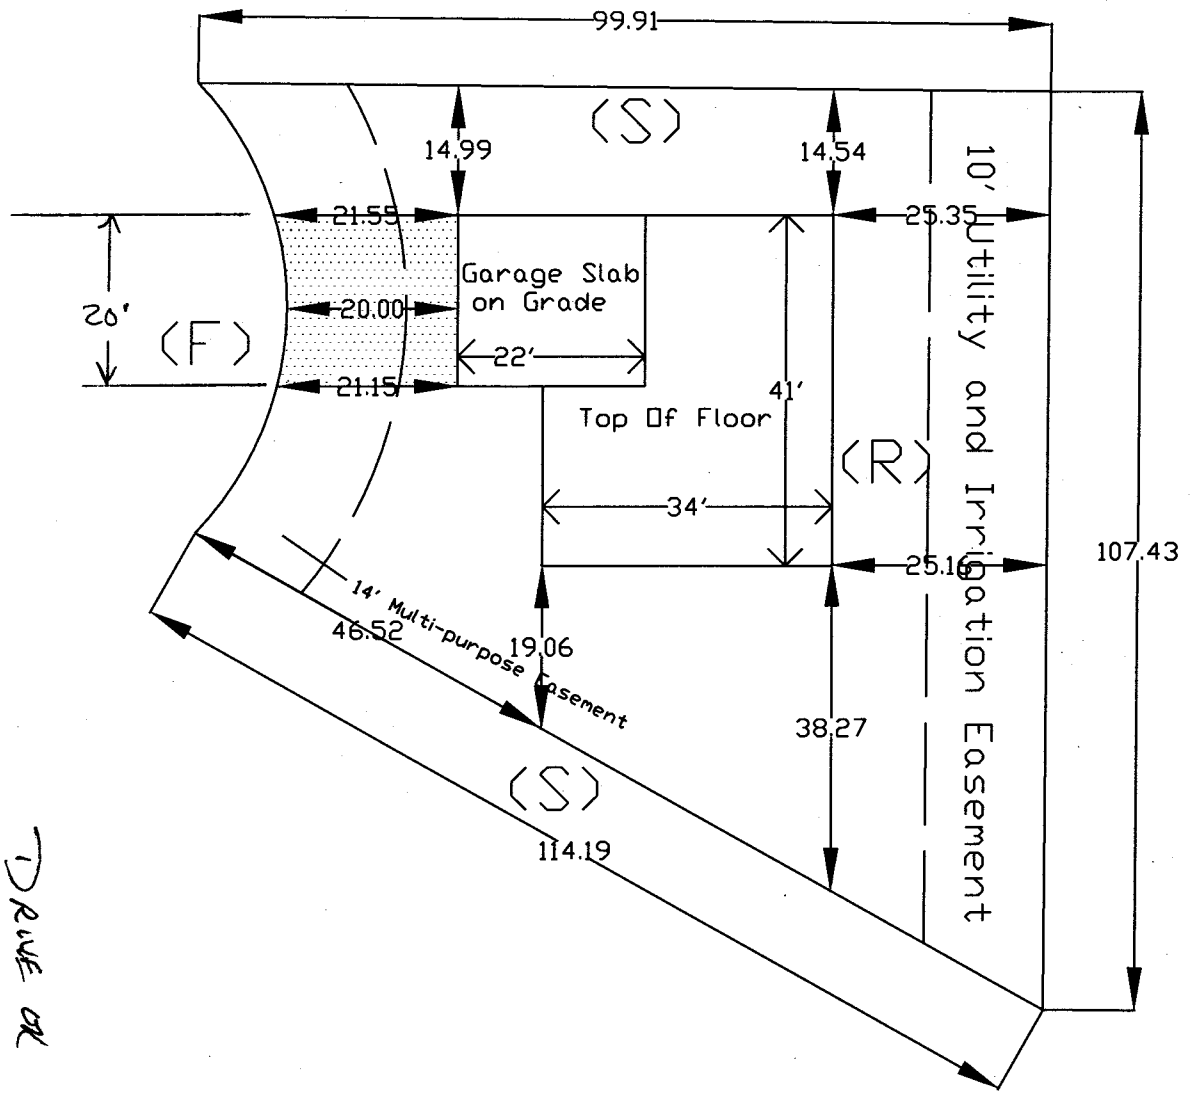

ACCEPTED
ANY CHANGE OF SETBACKS MUST BE APPROVED BY THE CITY PLANNING DEPT. IT IS THE APPLICANT'S RESPONSIBILITY TO PROPERLY LOCATE AND IDENTIFY EASEMENTS AND SETBACKS.

12/13/01
J. J. Johnson

	Pack Residence	
	456 S. Sun Ct.	
Lot 9	Fruitvale Meadows	SQ.FT. 7506
Block 1	SCALE	The Energy Office