

FEE \$	10.00
TCP \$	500.00
SIF \$	292.00

PLANNING CLEARANCE

(Single Family Residential and Accessory Structures)
Community Development Department

BLDG PERMIT NO. 78228



Your Bridge to a Better Community

BLDG ADDRESS 486 Tanner ST SQ. FT. OF PROPOSED BLDGS/ADDITION 1210
 TAX SCHEDULE NO. 2943-152-730090 FT. OF EXISTING BLDGS d
 SUBDIVISION Summit View Ranch II TOTAL SQ. FT. OF EXISTING & PROPOSED 1210
 FILING ~~BLK~~ 4 LOT 8 NO. OF DWELLING UNITS:
 Before: 0 After: 1 this Construction
 (1) OWNER Zeck & Associates, LLC NO. OF BUILDINGS ON PARCEL
 Before: 0 After: 1 this Construction
 (1) ADDRESS PO Box 1083, 6500 8502 USE OF EXISTING BUILDINGS N/A
 (1) TELEPHONE 970-523-4428 DESCRIPTION OF WORK & INTENDED USE Single Family Residence
 (2) APPLICANT Zeck & Associates, LLC TYPE OF HOME PROPOSED:
 (2) ADDRESS PO Box 1083 Site Built Manufactured Home (UBC)
 Manufactured Home (HUD)
 Other (please specify) _____
 (2) TELEPHONE 970-257-9483

REQUIRED: One plot plan, on 8 1/2" x 11" paper, showing all existing & proposed structure location(s), parking, setbacks to all property lines, ingress/egress to the property, driveway location & width & all easements & rights-of-way which abut the parcel.

THIS SECTION TO BE COMPLETED BY COMMUNITY DEVELOPMENT DEPARTMENT STAFF

ZONE BMF-5 Maximum coverage of lot by structures 100%
 SETBACKS: Front 20' from property line (PL) Permanent Foundation Required: YES NO
 or _____ from center of ROW, whichever is greater
 Side 5' from PL, Rear 25' from PL Parking Req'mt 2
 Maximum Height 35' Special Conditions _____
 CENSUS 8 TRAFFIC 58 ANNX# _____

Modifications to this Planning Clearance must be approved, in writing, by the Community Development Department. The structure authorized by this application cannot be occupied until a final inspection has been completed and a Certificate of Occupancy has been issued, if applicable, by the Building Department (Section 305, Uniform Building Code).


I hereby acknowledge that I have read this application and the information is correct; I agree to comply with any and all codes, ordinances, laws, regulations or restrictions which apply to the project. I understand that failure to comply shall result in legal action, which may include but not necessarily be limited to non-use of the building(s).

Applicant Signature Maureen Zeck Date 1-04-01
 Department Approval Alisa Major Date _____

Additional water and/or sewer tap fee(s) are required:	YES <input checked="" type="checkbox"/>	NO <input type="checkbox"/>	W/O No. <u>See attached</u>
Utility Accounting	<u>AM Cole</u>	Date	<u>1-12-01</u>

VALID FOR SIX MONTHS FROM DATE OF ISSUANCE (Section 9-3-2C Grand Junction Zoning & Development Code)

(White: Planning) (Yellow: Customer) (Pink: Building Department) (Goldenrod: Utility Accounting)

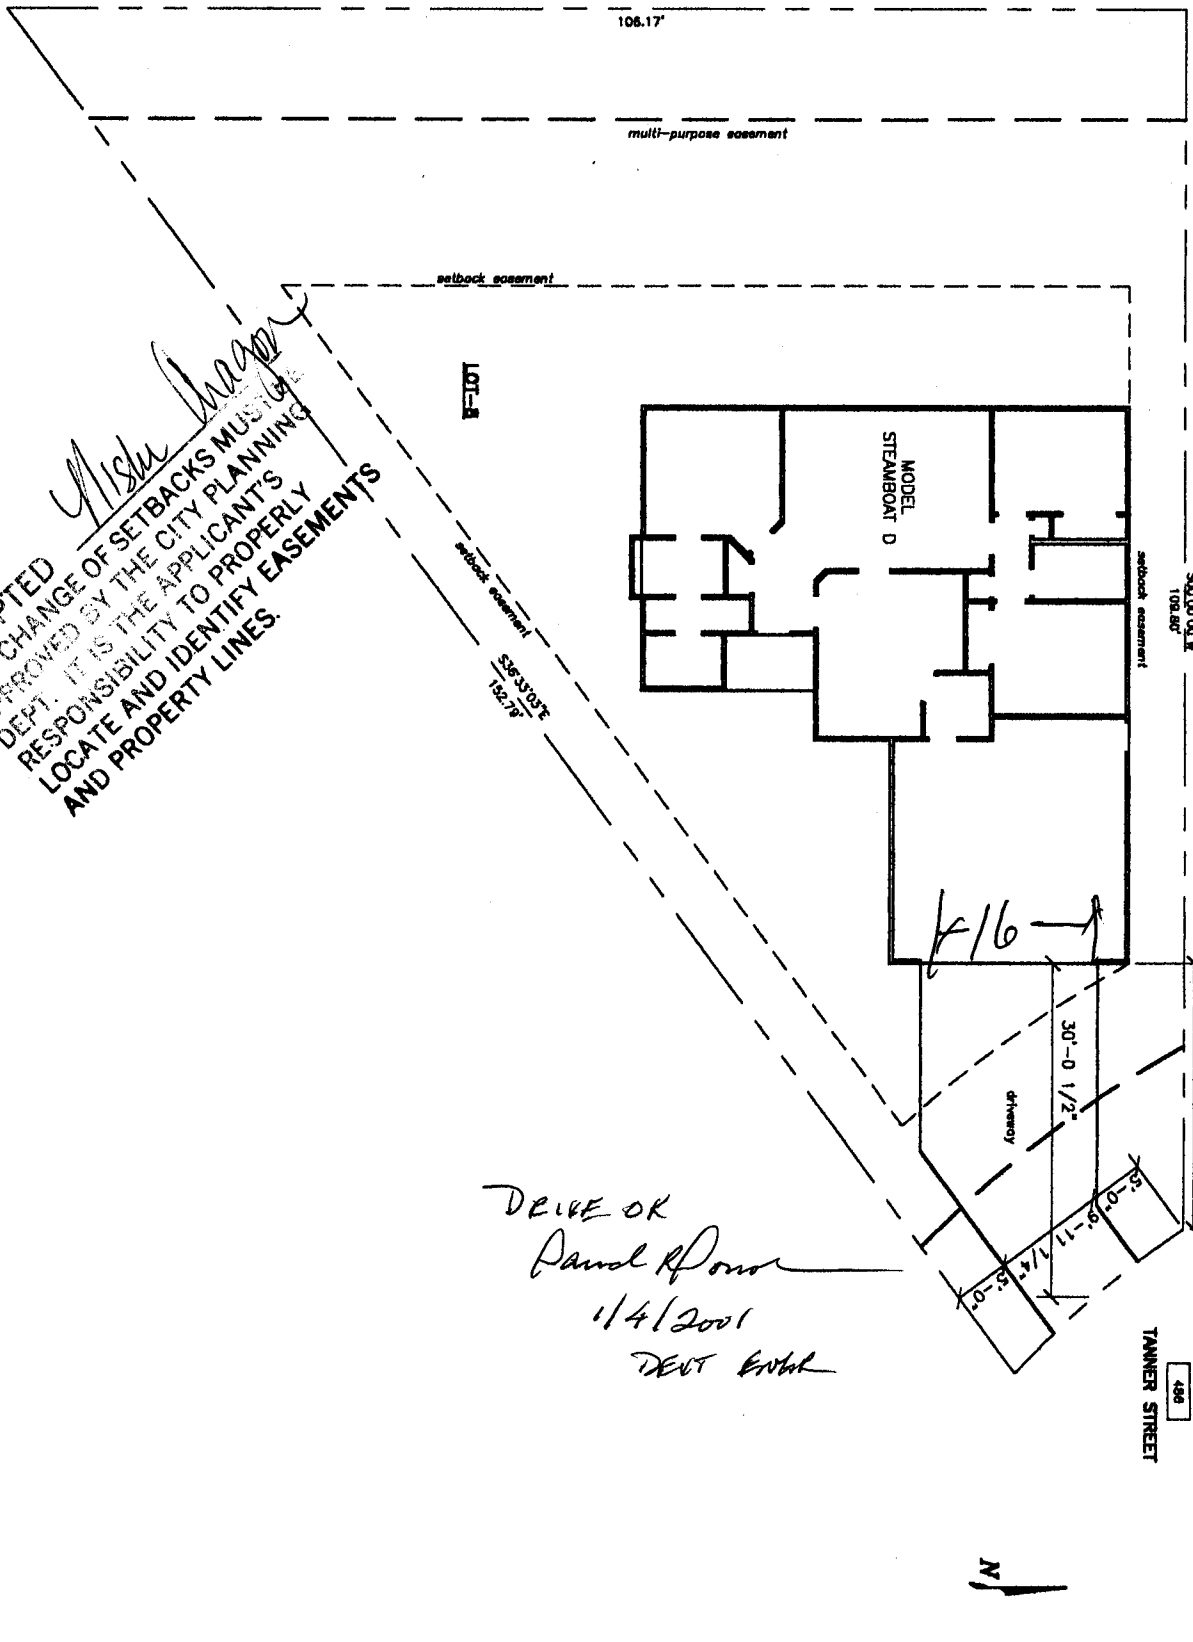

Alisa Wagner

ACCEPTED
 ANY CHANGE OF SETBACKS MUST BE
 APPROVED BY THE CITY PLANNING
 DEPT. IT IS THE APPLICANT'S
 RESPONSIBILITY TO PROPERLY
 LOCATE AND IDENTIFY EASEMENTS
 AND PROPERTY LINES.

PLOT PLAN
 SCALE: N.T.S.

DRIVE OR
Parcel R/P owned
 1/4/2001
 DEPT ENTER

PL-1 <small>1</small> <small>JMK</small>	JMK <small>a Associates, Inc.</small> <small>1000 1/2 St. N.</small> <small>Grand Junction, CO 81502</small> <small>(970) 257-8483</small>	Zeck & Associates LLC P.O. Box 1083 Grand Junction, CO 81502 (970) 257-8483	PLOT PLAN for Lot 8, Block 1 Summit View Ranch	<small>DATE</small> <small>BY</small> <small>REVISION</small>
	<small>DATE</small> <small>BY</small> <small>REVISION</small>	<small>DATE</small> <small>BY</small> <small>REVISION</small>	<small>DATE</small> <small>BY</small> <small>REVISION</small>	<small>DATE</small> <small>BY</small> <small>REVISION</small>