

FEE \$	10.00
TCP \$	500.00
SIF \$	292.00

PLANNING CLEARANCE
 (Single Family Residential and Accessory Structures)
Community Development Department

BLDG PERMIT NO. 79561



Your Bridge to a Better Community

BLDG ADDRESS 467 Tanner ST. SQ. FT. OF PROPOSED BLDGS/ADDITION 1113
 TAX SCHEDULE NO. 2943-152-78-008 SQ. FT. OF EXISTING BLDGS 0
 SUBDIVISION Summit View Ranch TOTAL SQ. FT. OF EXISTING & PROPOSED 1113
 FILING 2 BLK 2 LOT 8 NO. OF DWELLING UNITS:
 Before: 0 After: 1 this Construction
 (1) OWNER Zeck & Associates, LLC NO. OF BUILDINGS ON PARCEL
 Before: 0 After: 1 this Construction
 (1) ADDRESS PO Box 1083 6 JCO81502 USE OF EXISTING BUILDINGS N/A
 (1) TELEPHONE 970-257-9483 DESCRIPTION OF WORK & INTENDED USE Single Family Residence
 (2) APPLICANT Zeck & Associates, LLC TYPE OF HOME PROPOSED:
 (2) ADDRESS PO Box 1083 Site Built Manufactured Home (UBC)
 (2) TELEPHONE 970-257-9483 Manufactured Home (HUD)
 Other (please specify) _____

REQUIRED: One plot plan, on 8 1/2" x 11" paper, showing all existing & proposed structure location(s), parking, setbacks to all property lines, ingress/egress to the property, driveway location & width & all easements & rights-of-way which abut the parcel.

THIS SECTION TO BE COMPLETED BY COMMUNITY DEVELOPMENT DEPARTMENT STAFF

ZONE RMF-5 Maximum coverage of lot by structures 60%
 SETBACKS: Front 20' from property line (PL) Permanent Foundation Required: YES NO
 or _____ from center of ROW, whichever is greater
 Side 5' from PL, Rear 25' from PL Parking Req'mt 2
 Maximum Height 35' Special Conditions _____
 CENSUS 8 TRAFFIC 58 ANN# _____

Modifications to this Planning Clearance must be approved, in writing, by the Community Development Department. The structure authorized by this application cannot be occupied until a final inspection has been completed and a Certificate of Occupancy has been issued, if applicable, by the Building Department (Section 305, Uniform Building Code).

I hereby acknowledge that I have read this application and the information is correct; I agree to comply with any and all codes, ordinances, laws, regulations or restrictions which apply to the project. I understand that failure to comply shall result in legal action, which may include but not necessarily be limited to non-use of the building(s).

Applicant Signature Maureen R Zeck Date 4-23-01
 Department Approval Ronnie Edwards Date 4-30-01


Additional water and/or sewer tap fee(s) are required:	YES <input checked="" type="checkbox"/>	NO <input type="checkbox"/>	W/O No. <u>Paid @ City</u>
Utility Accounting	<u>Chart</u>	Date	<u>4/30/01</u>

VALID FOR SIX MONTHS FROM DATE OF ISSUANCE (Section 9-3-2C Grand Junction Zoning & Development Code)

(White: Planning) (Yellow: Customer) (Pink: Building Department) (Goldenrod: Utility Accounting)

ACCEPTED
 APPROVED BY THE CITY PLANNING
 DEPT. IT IS THE APPLICANT'S
 RESPONSIBILITY TO PROPERLY
 LOCATE AND IDENTIFY PROPERTY
 AND PROPERTY LINES
 EASEMENTS

4/30/01

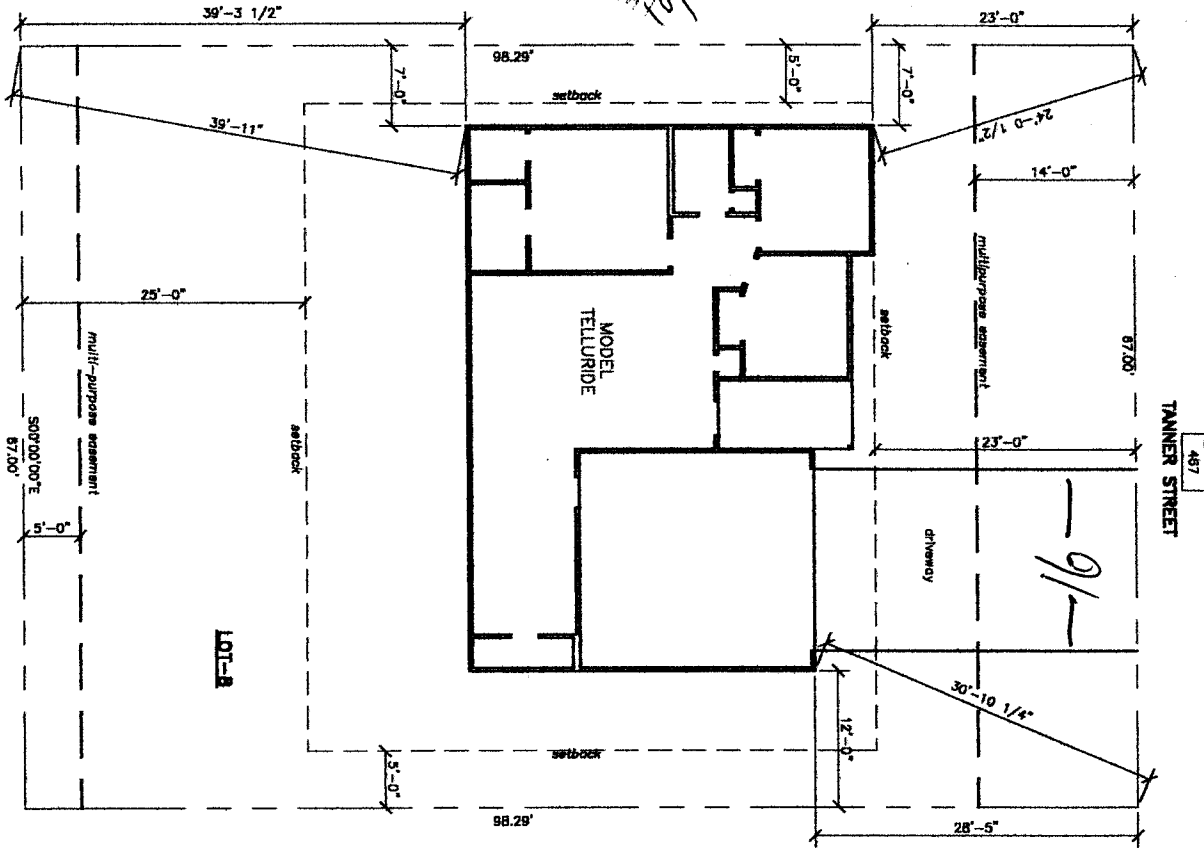

PLOT PLAN
 SCALE: N.T.S.

*467
 Tanner St*

*DRIVE OK
 DMP
 4/23/01*



PL-1 JMK	DATE 4/19/01	JMK & Associates, Inc. 2500 Canyon Blvd., Suite 200 Grand Junction, CO 81502 (970) 257-9483	PLOT PLAN for Lot 8, Block 2 Summit View Ranch	SHEET NO. 1
	DRAWN BY JMK			TOTAL SHEETS 1