

FEE \$	10.00
TCP \$	0
SIF \$	292.00

**PLANNING CLEARANCE**  
 (Single Family Residential and Accessory Structures)  
Community Development Department

BLDG PERMIT NO. 80620



BLDG ADDRESS 2027 Wrangler Way SQ. FT. OF PROPOSED BLDGS/ADDITION 4680  
 TAX SCHEDULE NO. 2947-152-29-006 SQ. FT. OF EXISTING BLDGS 0  
 SUBDIVISION Independence Ranch TOTAL SQ. FT. OF EXISTING & PROPOSED 4680  
 FILING 1 BLK 1 LOT 6 NO. OF DWELLING UNITS:  
 Before: 0 After: 1 this Construction  
 (1) OWNER ORRIN THOMPSON NO. OF BUILDINGS ON PARCEL  
 Before: 0 After: 1 this Construction  
 (1) ADDRESS 401 Colorado Ave USE OF EXISTING BUILDINGS N/A  
 (1) TELEPHONE 242-6016 DESCRIPTION OF WORK & INTENDED USE Home  
 (2) APPLICANT ORRIN THOMPSON TYPE OF HOME PROPOSED:  
 (2) ADDRESS 401 Colorado Ave  Site Built  Manufactured Home (UBC)  
 (2) TELEPHONE 242-6016  Manufactured Home (HUD)  
 Other (please specify) \_\_\_\_\_

**REQUIRED: One plot plan, on 8 1/2" x 11" paper showing all existing & proposed structure location(s), parking, setbacks to all property lines, ingress/egress to the property, driveway location & width & all easements & rights-of-way which abut the parcel.**

**THIS SECTION TO BE COMPLETED BY COMMUNITY DEVELOPMENT DEPARTMENT STAFF**

ZONE PD Maximum coverage of lot by structures 10000 sq ft  
 SETBACKS: Front 25' from property line (PL) Permanent Foundation Required: YES  NO   
 or \_\_\_\_\_ from center of ROW, whichever is greater  
 Side 10' from PL, Rear 25' from PL Parking Req'mt 2  
 Maximum Height 32' Special Conditions \_\_\_\_\_  
 CENSUS 1402 TRAFFIC 89 ANNX# \_\_\_\_\_

Modifications to this Planning Clearance must be approved, in writing, by the Community Development Department. The structure authorized by this application cannot be occupied until a final inspection has been completed and a Certificate of Occupancy has been issued, if applicable, by the Building Department (Section 305, Uniform Building Code).

I hereby acknowledge that I have read this application and the information is correct; I agree to comply with any and all codes, ordinances, laws, regulations or restrictions which apply to the project. I understand that failure to comply shall result in legal action, which may include but not necessarily be limited to non-use of the building(s).

Applicant Signature [Signature] Date 7-9-2001  
 Department Approval [Signature] Date 7-13-01


Additional water and/or sewer tap fee(s) are required:	YES	<input checked="" type="checkbox"/> NO	W/O No. <u>14119</u>
Utility Accounting	<u>Kate Heet</u>	Date	<u>7/13/01</u>

VALID FOR SIX MONTHS FROM DATE OF ISSUANCE (Section 9-3-2C Grand Junction Zoning & Development Code)

(White: Planning) (Yellow: Customer) (Pink: Building Department) (Goldenrod: Utility Accounting)

NOTICE:  
 1. IT IS THE RESPONSIBILITY OF THE BUILDER OR OWNER TO VERIFY DETAILS  
 AND DIMENSIONS PRIOR TO CONSTRUCTION.

$14 \leq \text{width} \leq 30$   
 offsets relative to lot line  $\geq 5\text{ FT}$

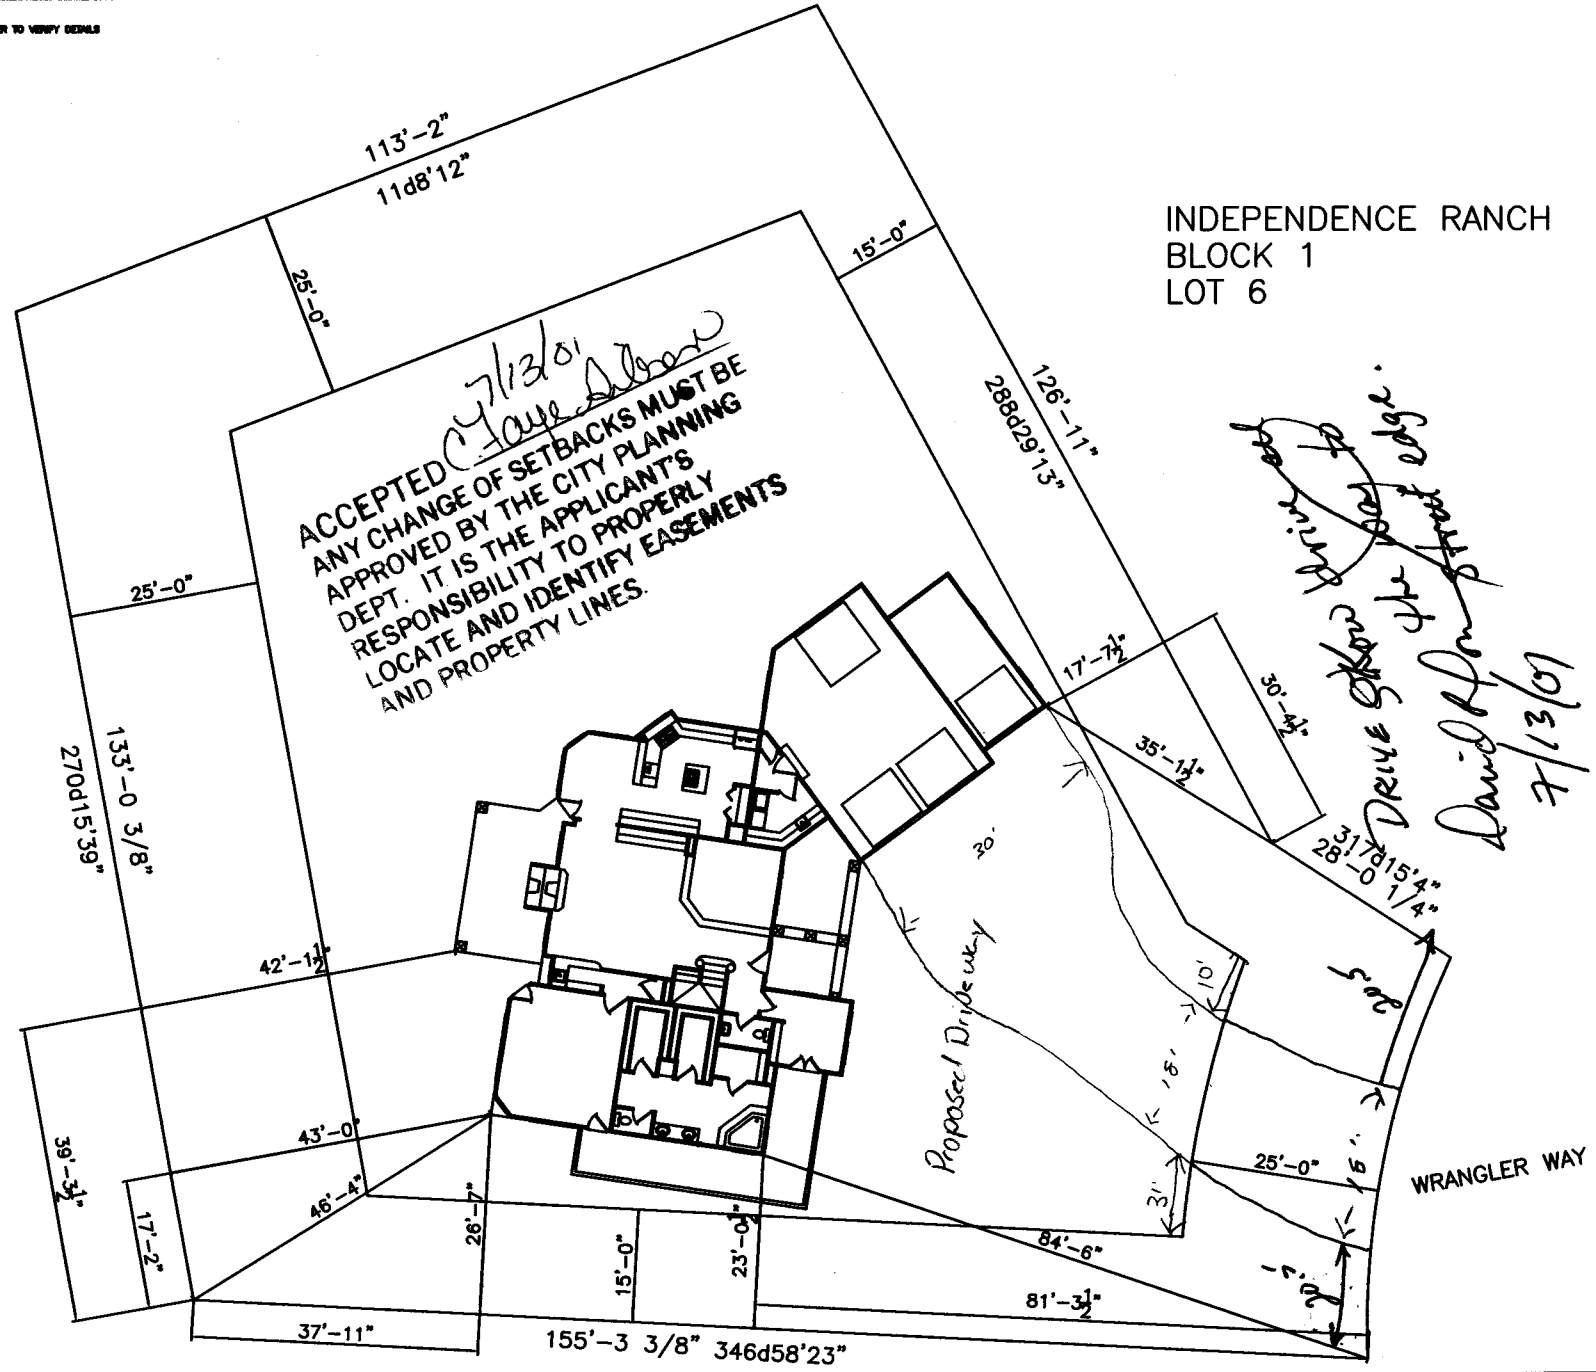

INDEPENDENCE RANCH  
 BLOCK 1  
 LOT 6

Scale bar: 0, 10, 20, 30, 40, 50, 60, 70, 80, 90, 100 feet.

North arrow pointing up.

SH