

FEE \$	10.00
TCP \$	0
SIF \$	0

PLANNING CLEARANCE
 (Single Family Residential and Accessory Structures)
Community Development Department

BLDG PERMIT NO. 87108



Existing acct # 13317-8348

BLDG ADDRESS 568 25th Rd SQ. FT. OF PROPOSED BLDGS/ADDITION _____

TAX SCHEDULE NO. 2945-101-00-9789 SQ. FT. OF EXISTING BLDGS _____

SUBDIVISION _____ TOTAL SQ. FT. OF EXISTING & PROPOSED _____

FILING _____ BLK _____ LOT _____ NO. OF DWELLING UNITS:

(1) OWNER Monument Little League Before: _____ After: _____ this Construction

(1) ADDRESS 568 25th Rd NO. OF BUILDINGS ON PARCEL

(1) TELEPHONE _____ Before: _____ After: _____ this Construction

(2) APPLICANT Jason Neece USE OF EXISTING BUILDINGS _____

(2) ADDRESS 568 25th Rd DESCRIPTION OF WORK & INTENDED USE Set up mobile home

(2) TELEPHONE 201-6014 TYPE OF HOME PROPOSED:
 Site Built Manufactured Home (UBC)
 Manufactured Home (HUD)
 Other (please specify) _____

REQUIRED: One plot plan, on 8 1/2" x 11" paper, showing all existing & proposed structure location(s), parking, setbacks to all property lines, ingress/egress to the property, driveway location & width & all easements & rights-of-way which abut the parcel.

THIS SECTION TO BE COMPLETED BY COMMUNITY DEVELOPMENT DEPARTMENT STAFF

ZONE CSR

Maximum coverage of lot by structures N/A

SETBACKS: Front 15' from property line (PL)
 or _____ from center of ROW, whichever is greater

Permanent Foundation Required: YES _____ NO _____

Side 5' from PL, Rear 10' from PL

Parking Req'mt _____

Maximum Height 65'

Special Conditions Mobile home must be HUD approved on permanent foundation

CENSUS _____ TRAFFIC _____ ANNEX# _____

Modifications to this Planning Clearance must be approved, in writing, by the Community Development Department. The structure authorized by this application cannot be occupied until a final inspection has been completed and a Certificate of Occupancy has been issued, if applicable, by the Building Department (Section 305, Uniform Building Code).

I hereby acknowledge that I have read this application and the information is correct; I agree to comply with any and all codes, ordinances, laws, regulations or restrictions which apply to the project. I understand that failure to comply shall result in legal action, which may include but not necessarily be limited to non-use of the building(s).

Applicant Signature Jason Neece Date Nov 12, 2002



Department Approval Gayleen Henderson Date 11-13-02

Additional water and/or sewer tap fee(s) are required:	YES	NO <input checked="" type="checkbox"/>	W/O No.
Utility Accounting <u>C. Bensley</u>	Date <u>11/13/02</u>		

VALID FOR SIX MONTHS FROM DATE OF ISSUANCE (Section 9-3-2C Grand Junction Zoning & Development Code)

(White: Planning) (Yellow: Customer) (Pink: Building Department) (Goldenrod: Utility Accounting)

11-13-02
ACCEPTED *Gayles Henderson*
ANY CHANGE OF SETBACKS MUST BE
APPROVED BY THE CITY PLANNING
DEPT. IT IS THE APPLICANT'S
RESPONSIBILITY TO PROPERLY
LOCATE AND IDENTIFY EASEMENT
AND PROPERTY LINES.

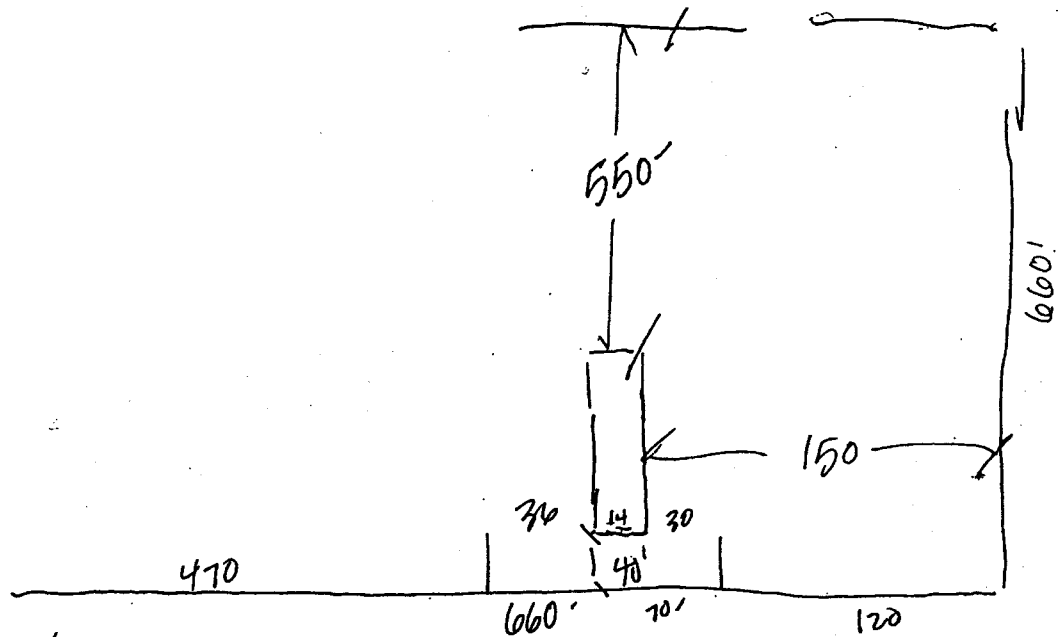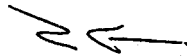

568 25 1/2 RA

25 1/2 RA