

FEE \$	10.00
TCP \$	0
SIF \$	292.00

PLANNING CLEARANCE
 (Single Family Residential and Accessory Structures)
Community Development Department

BLDG PERMIT NO. 85102



Your Bridge to a Better Community

BLDG ADDRESS 702 Tranquil Trail
 (not a no. at this time)

SQ. FT. OF PROPOSED BLDGS/ADDITION 2995

TAX SCHEDULE NO. _____

SQ. FT. OF EXISTING BLDGS NA

SUBDIVISION Independence Ranch

TOTAL SQ. FT. OF EXISTING & PROPOSED 2995

FILING Repeat BLK 1 LOT 4

NO. OF DWELLING UNITS:
 Before: 0 After: 1 this Construction

(1) OWNER Jaci r Scott Doughty

NO. OF BUILDINGS ON PARCEL
 Before: 0 After: 1 this Construction

(1) ADDRESS 677 Roundup NJ 81503

USE OF EXISTING BUILDINGS Single Family Residential

(1) TELEPHONE 241-9219

DESCRIPTION OF WORK & INTENDED USE _____

(2) APPLICANT Owner

TYPE OF HOME PROPOSED:
 Site Built MAN Manufactured Home (UBC)
 Manufactured Home (HUD)
 Other (please specify) _____

(2) ADDRESS _____

(2) TELEPHONE _____

REQUIRED: One plot plan, on 8 1/2" x 11" paper, showing all existing & proposed structure location(s), parking, setbacks to all property lines, ingress/egress to the property, driveway location & width & all easements & rights-of-way which abut the parcel.

THIS SECTION TO BE COMPLETED BY COMMUNITY DEVELOPMENT DEPARTMENT STAFF

ZONE PD

Maximum coverage of lot by structures 3590

SETBACKS: Front 25' from property line (PL)
 or _____ from center of ROW, whichever is greater

Permanent Foundation Required: YES X NO _____

Side 10' from PL, Rear 20' from PL

Parking Req'mt 2

Maximum Height 32'

Special Conditions _____

CENSUS 1402 TRAFFIC 88 ANNX# _____

Modifications to this Planning Clearance must be approved, in writing, by the Community Development Department. The structure authorized by this application cannot be occupied until a final inspection has been completed and a Certificate of Occupancy has been issued, if applicable, by the Building Department (Section 305, Uniform Building Code).

I hereby acknowledge that I have read this application and the information is correct; I agree to comply with any and all codes, ordinances, laws, regulations or restrictions which apply to the project. I understand that failure to comply shall result in legal action, which may include but not necessarily be limited to non-use of the building(s).

Applicant Signature Jaci Doughty
 Department Approval J. Bayless Henderson


Date 6/17/02
 Date 6-19-02

Additional water and/or sewer tap fee(s) are required:	YES <input checked="" type="checkbox"/>	NO	W/O No. <u>15039</u>
Utility Accounting	<u>(Bensley)</u>	Date	<u>6/19/02</u>

VALID FOR SIX MONTHS FROM DATE OF ISSUANCE (Section 9-3-2C Grand Junction Zoning & Development Code)

(White: Planning) (Yellow: Customer) (Pink: Building Department) (Goldenrod: Utility Accounting)

6-19-02
 ACCEPTED *Jeffrey Anderson*
 ANY CHANGE OF SETBACKS MUST BE
 APPROVED BY THE CITY PLANNING
 DEPARTMENT

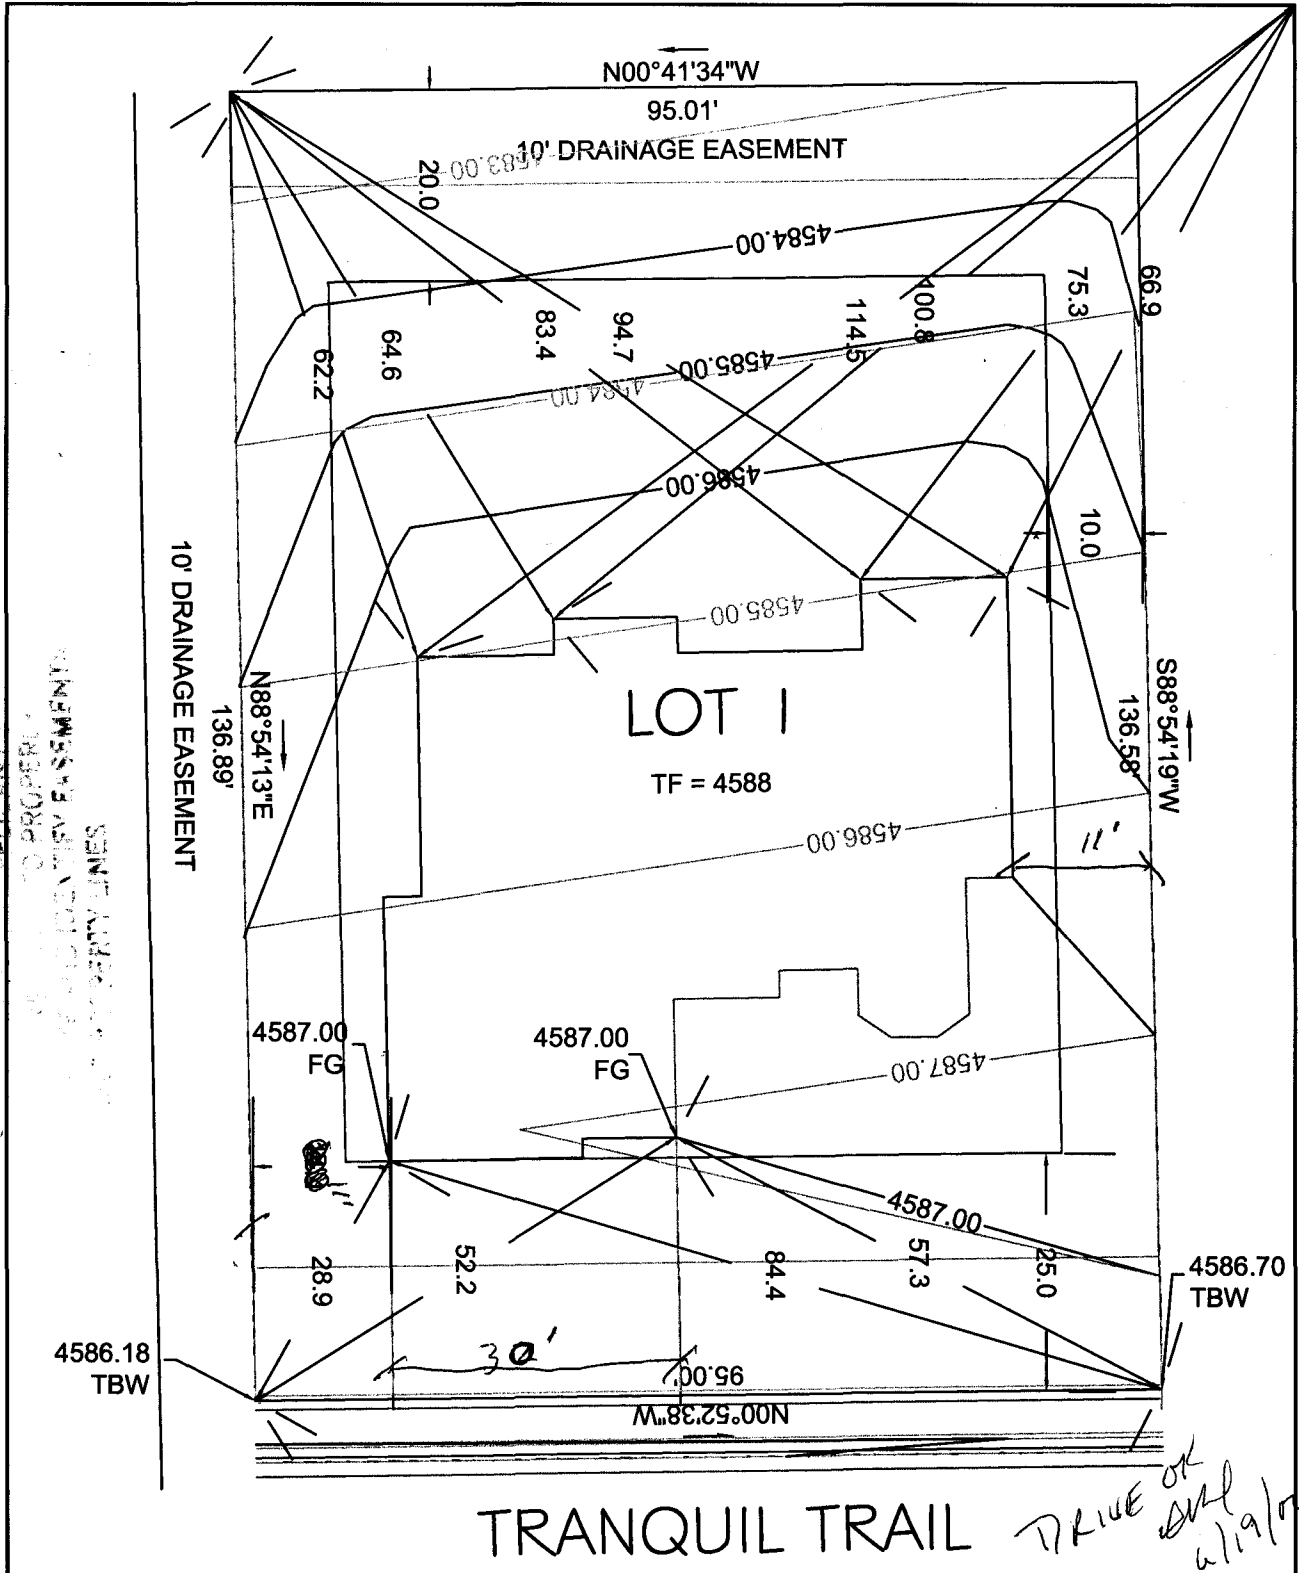

TRANQUIL TRAIL

*DRIVE OK
 6/19/02*

JOB NAME: TRANQUIL TRAIL	DRAWN BY:	CHECKED BY:
	SCALE: 1" = 20'	
LOCATION: LOT 1 INDEPENDENCE RANCH FILING 8 REPLAT	DATE: 6/9/02	
	JOB NUMBER	SHEET
DESCRIPTION:		△