

FEE \$ 10.00
TCP \$ 500.00
SIF \$ 292.00

PLANNING CLEARANCE
 (Single Family Residential and Accessory Structures)
Community Development Department

BLDG PERMIT NO. 83249



Your Bridge to a Better Community

BLDG ADDRESS 596 20 1/2 Road SQ. FT. OF PROPOSED BLDGS/ADDITION 1404

TAX SCHEDULE NO. 2943-071-19-001 SQ. FT. OF EXISTING BLDGS N/A

SUBDIVISION The Legenos TOTAL SQ. FT. OF EXISTING & PROPOSED 1404

FILING 1 BLK 1 LOT 1 NO. OF DWELLING UNITS:
 Before: 0 After: 1 this Construction

(1) OWNER ABELL Partners NO. OF BUILDINGS ON PARCEL
 Before: 0 After: 1 this Construction

(1) ADDRESS P.O. Box 1765, G.J., COLO USE OF EXISTING BUILDINGS N/A

(1) TELEPHONE 970-244-9986 #17 DESCRIPTION OF WORK & INTENDED USE New Single Family

(2) APPLICANT ABELL Partners TYPE OF HOME PROPOSED:
 Site Built Manufactured Home (UBC)
 Manufactured Home (HUD)
 Other (please specify) _____

(2) ADDRESS Some

(2) TELEPHONE Some

REQUIRED: One plot plan, on 8 1/2" x 11" paper, showing all existing & proposed structure location(s), parking, setbacks to all property lines, ingress/egress to the property, driveway location & width & all easements & rights-of-way which abut the parcel.

THIS SECTION TO BE COMPLETED BY COMMUNITY DEVELOPMENT DEPARTMENT STAFF

ZONE PD Maximum coverage of lot by structures _____

SETBACKS: Front 15' from property line (PL) Permanent Foundation Required: YES NO
 or _____ from center of ROW, whichever is greater

Side 5' from PL, Rear 10' from PL Parking Req'mt 2

Maximum Height 32' Special Conditions _____

CENSUS 6 TRAFFIC 29 ANN# _____

Modifications to this Planning Clearance must be approved, in writing, by the Community Development Department. The structure authorized by this application cannot be occupied until a final inspection has been completed and a Certificate of Occupancy has been issued, if applicable, by the Building Department (Section 305, Uniform Building Code).

I hereby acknowledge that I have read this application and the information is correct; I agree to comply with any and all codes, ordinances, laws, regulations or restrictions which apply to the project. I understand that failure to comply shall result in legal action, which may include but not necessarily be limited to non-use of the building(s).

Applicant Signature [Signature] Date 1-31-02

Department Approval [Signature] Date 2/11/02

Additional water and/or sewer tap fee(s) are required:	YES <input checked="" type="checkbox"/>	NO <input type="checkbox"/>	W/O No. <input type="checkbox"/>
Utility Accounting <u>[Signature]</u>	Date <u>2-11-02</u>		


VALID FOR SIX MONTHS FROM DATE OF ISSUANCE (Section 9-3-2C Grand Junction Zoning & Development Code)

(White: Planning) (Yellow: Customer) (Pink: Building Department) (Goldenrod: Utility Accounting)

598 20 1/2 KOTH

63.17' ← North

ACCEPTED *2/11/02*
Clay Gibson
ANY CHANGE OF SETBACKS MUST BE APPROVED BY THE CITY PLANNING DEPT. IT IS THE APPLICANT'S RESPONSIBILITY TO PROPERLY LOCATE AND IDENTIFY EASEMENTS AND PROPERTY LINES

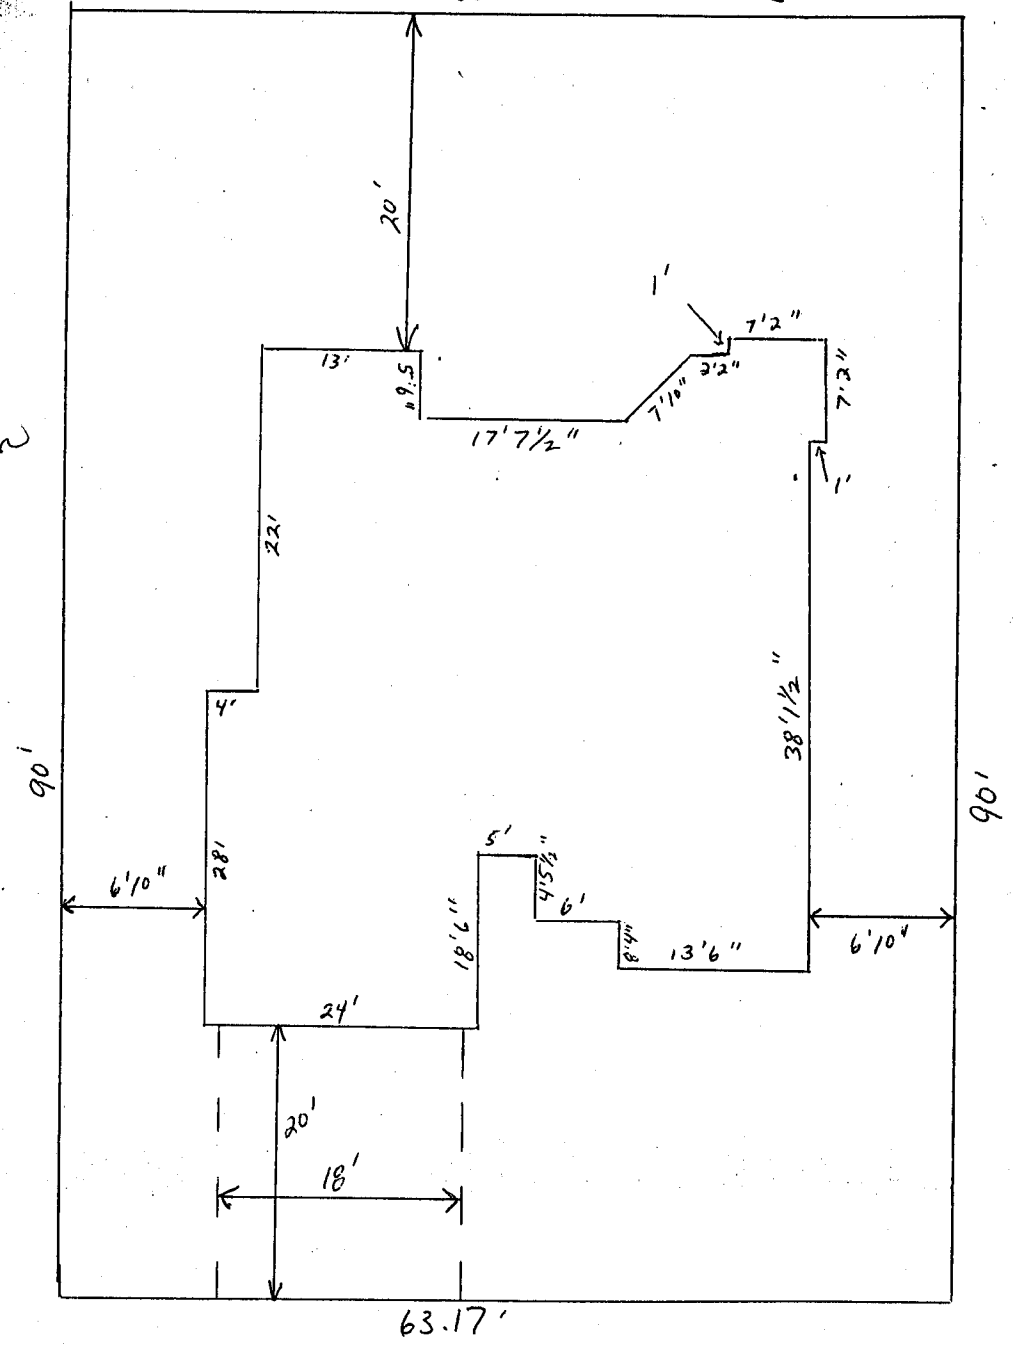

Roy A. Peterson
1-15-02

Exhibit H.

Roy A. Peterson
1-15-02

DRIVE OK
DML
2/5/02