FEE \$ 10.00 PLANNING C	LEARANCE BLDG PERMIT NO. 85887
TCP \$243.26(Single Family Residential aSIF \$292.00Community Develop	
	Your Bridge to a Better Community
BLDG ADDRESS 2832 ACRIN CC.	SQ. FT. OF PROPOSED BLDGS/ADDITION 1415 Sq house
TAX SCHEDULE NO. 2943-303-62-005	SQ. FT. OF EXISTING BLDGS
SUBDIVISION Arrowhead Acres I	TOTAL SQ. FT. OF EXISTING & PROPOSED 1415 Sq house
FILING <u>3</u> BLK <u>I</u> LOT <u>4</u>	NO. OF DWELLING UNITS:
"OWNER PINNACLE HOMES FUC	Before: After: this Construction NO. OF BUILDINGS ON PARCEL
(1) ADDRESS 518 28 Rd Suite A107 81001	Before: D After: this Construction
(1) TELEPHONE <u>241-6646</u>	
(2) APPLICANT SAME	DESCRIPTION OF WORK & INTENDED USE NEW HOME CONST
⁽²⁾ ADDRESS	TYPE OF HOME PROPOSED: Site BuiltManufactured Home (UBC)
	Manufactured Home (HUD) Other (please specify)
· · · · · · · · · · · · · · · · · · ·	Parking Reg'mt 2 TB
structure authorized by this application cannot be occup Occupancy has been issued, if applicable, by the Buildir I hereby acknowledge that I have read this application and	d the information is correct; I agree to comply with any and all codes, to the project. I understand that failure to comply shall result in legal to non-use of the building(s). Date $\underbrace{S-2I-02}$
Additional water and/or sewer tap fee(s) are required: Utility Accounting	YES NO WONO.POLOUX OMSK 1 Date 8/21/02

VALID FOR SIX MONTHS FROM DATE OF ISSUANCE (Section 9-3-2C Grand Junction Zoning & Development Code)


(White: Plann	ning) (
---------------	---------

(Yellow: Customer)

(Pink: Building Department)

(Goldenrod: Utility Accounting)

8-21-02 ACCEPTED Dayles Harderon ANY CHANGE OF SETBACKS MUGT BE APPROVED BY THE CITY PLANNING DEPT. IT IS THE APPLICANT'S RESPONSIBILITY TO PROPERLY DOCATE AND IDENTIFY EASEMENTS AND PROPERTY LINES.

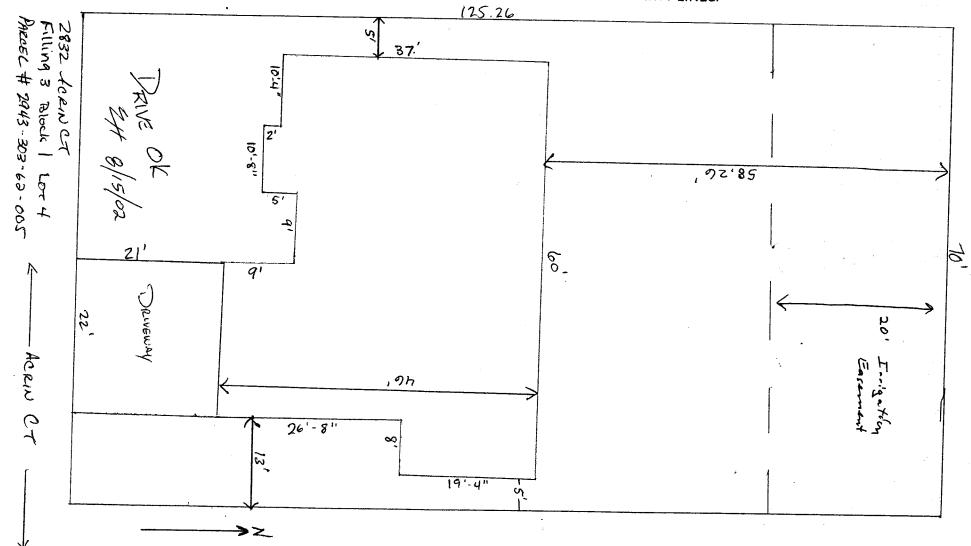

4