

FEE \$	10.00
TCP \$	0
SIF \$	0

PLANNING CLEARANCE
 (Single Family Residential and Accessory Structures)
Community Development Department

BLDG PERMIT NO. 80592



Your Bridge to a Better Community

BLDG ADDRESS 607 arapahoe^{way} SQ. FT. OF PROPOSED BLDGS/ADDITION 272
 TAX SCHEDULE NO. 2943-064-10-019 SQ. FT. OF EXISTING BLDGS 1230
 SUBDIVISION _____ TOTAL SQ. FT. OF EXISTING & PROPOSED 1402
 FILING _____ BLK _____ LOT _____ NO. OF DWELLING UNITS:
 Before: 1 After: 1 this Construction
 (1) OWNER Kirk Vaness, Patricia NO. OF BUILDINGS ON PARCEL
 Before: 1 After: 1 this Construction
 (1) ADDRESS 607 arapahoe way USE OF EXISTING BUILDINGS home
 (1) TELEPHONE 970-243-1255 DESCRIPTION OF WORK & INTENDED USE offic addition
 (2) APPLICANT _____ TYPE OF HOME PROPOSED:
 (2) ADDRESS Same _____ Site Built _____ Manufactured Home (UBC)
 _____ Manufactured Home (HUD)
 (2) TELEPHONE _____ Other (please specify) _____

REQUIRED: One plot plan, on 8 1/2" x 11" paper, showing all existing & proposed structure location(s), parking, setbacks to all property lines, ingress/egress to the property, driveway location & width & all easements & rights-of-way which abut the parcel.

THIS SECTION TO BE COMPLETED BY COMMUNITY DEVELOPMENT DEPARTMENT STAFF

ZONE RMF-5 Maximum coverage of lot by structures _____
 SETBACKS: Front 20' from property line (PL) Permanent Foundation Required: YES _____ NO _____
 or _____ from center of ROW, whichever is greater
 Side 5' from PL, Rear 25' from PL Parking Req'mt _____
 Maximum Height 35' Special Conditions _____
 CENSUS _____ TRAFFIC _____ ANNEX# _____

Modifications to this Planning Clearance must be approved, in writing, by the Community Development Department. The structure authorized by this application cannot be occupied until a final inspection has been completed and a Certificate of Occupancy has been issued, if applicable, by the Building Department (Section 305, Uniform Building Code).

I hereby acknowledge that I have read this application and the information is correct; I agree to comply with any and all codes, ordinances, laws, regulations or restrictions which apply to the project. I understand that failure to comply shall result in legal action, which may include but not necessarily be limited to non-use of the building(s).

Applicant Signature [Signature] Date 10-4-02
 Department Approval [Signature] Date 10-4-02

Additional water and/or sewer tap fee(s) are required:	YES	NO <input checked="" type="checkbox"/>	W/O No. _____
Utility Accounting	<u>[Signature]</u>	Date	<u>10/4/02</u>

VALID FOR SIX MONTHS FROM DATE OF ISSUANCE (Section 9-3-2C Grand Junction Zoning & Development Code)

(White: Planning) (Yellow: Customer) (Pink: Building Department) (Goldenrod: Utility Accounting)

IMPROVEMENT LOCATION CERTIFICATE


607 ARAPAHOE WAY

WESTERN COLORADO TITLE #98-03-100C
PRITCHARD ACCT.

LOT 41 OF INDIAN VILLAGE SUBDIVISION FILING NO. TWO,
MESA COUNTY, COLORADO.

ARAPAHOE WAY

10-4-02 Gaylean Henderson
ACCEPTED
ANY CHANGE OF SETBACKS MUST BE
APPROVED BY THE CITY PLANNING
DEPT. IT IS THE APPLICANT'S
RESPONSIBILITY TO PROPERLY
LOCATE AND IDENTIFY EASEMENT
AND PROPERTY LINES

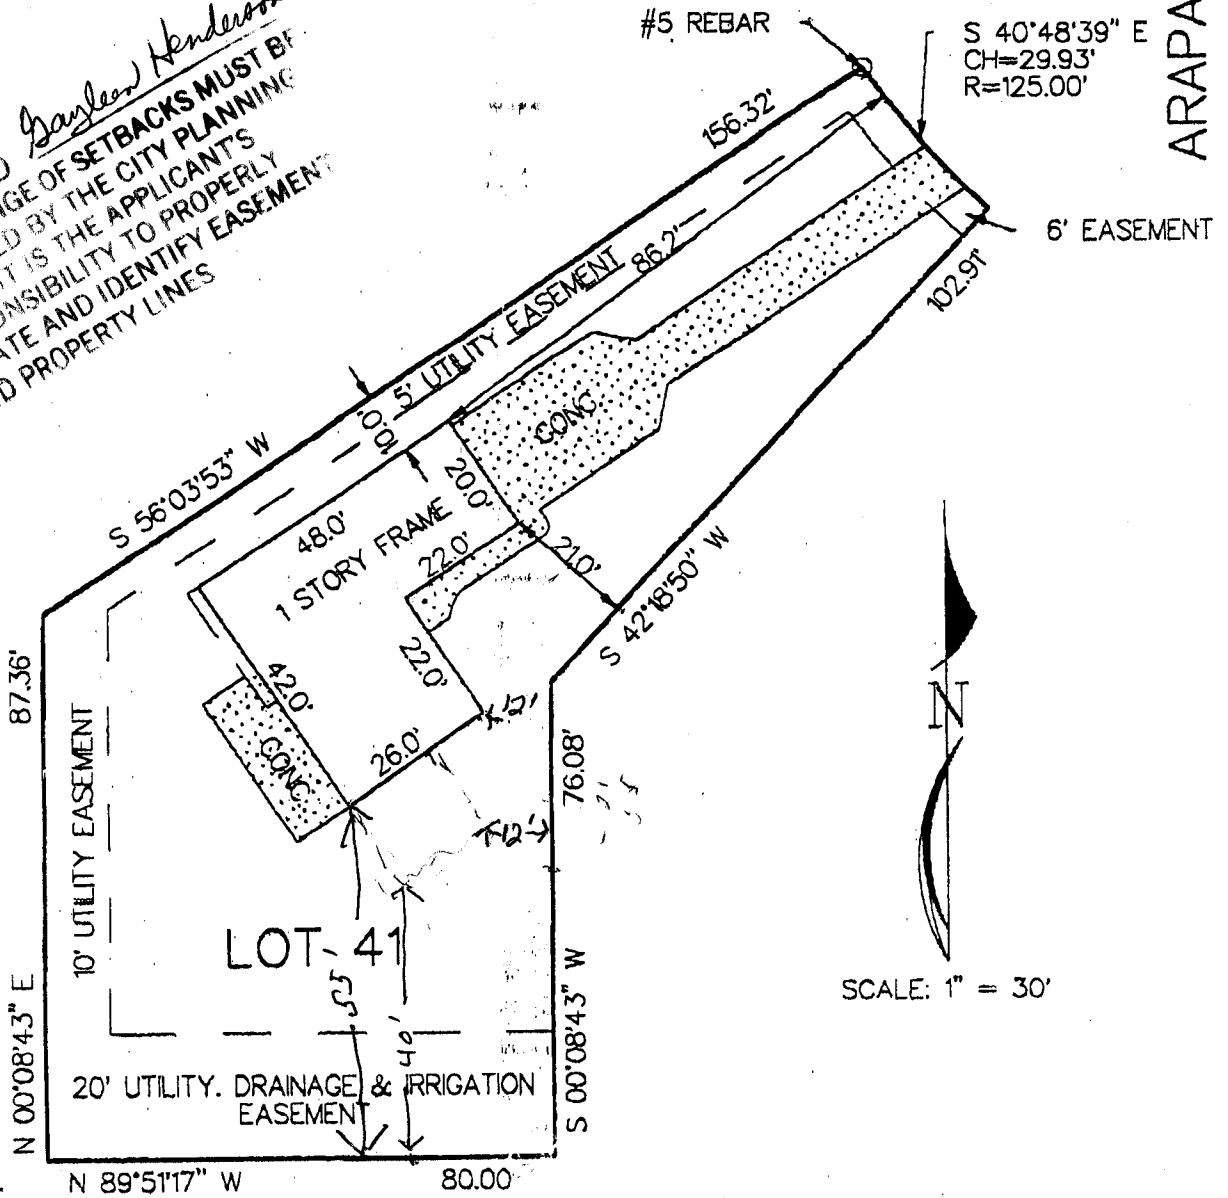

NOTE: THIS PROPERTY DOES NOT FALL WITHIN ANY 100 YEAR FLOODPLAIN.

I HEREBY CERTIFY THAT THIS IMPROVEMENT LOCATION CERTIFICATE WAS PREPARED FOR BANK OF COLORADO, THAT IT IS NOT A LAND SURVEY PLAT OR IMPROVEMENT SURVEY PLAT, AND THAT IT IS NOT TO BE RELIED UPON FOR THE ESTABLISHMENT OF FENCE, BUILDING OR OTHER FUTURE IMPROVEMENT LINES. I FURTHER CERTIFY THE IMPROVEMENTS ON THE ABOVE DESCRIBED PARCEL ON THIS DATE, 3/25/98 EXCEPT UTILITY CONNECTIONS, ARE ENTIRELY WITHIN THE BOUNDARIES OF THE PARCEL, EXCEPT AS SHOWN, THAT THERE ARE NO ENCROACHMENTS UPON THE DESCRIBED PREMISES BY IMPROVEMENTS ON ANY ADJOINING PREMISES, EXCEPT AS INDICATED, AND THAT THERE IS NO EVIDENCE OR SIGN OF ANY EASEMENT CROSSING OR BURDENING ANY PART OF SAID PARCEL, EXCEPT AS NOTED.

Kenneth L. Dellen