

FEE \$	10.00
TCP \$	500.00
SIF \$	292.00

PLANNING CLEARANCE

(Single Family Residential and Accessory Structures)
Community Development Department

BLDG PERMIT NO. 85278



Your Bridge to a Better Community

BLDG ADDRESS 403 A Broken Arrow SQ. FT. OF PROPOSED BLDGS/ADDITION 1295 #

TAX SCHEDULE NO. 2743-174-19-002 SQ. FT. OF EXISTING BLDGS - 0 -

SUBDIVISION Flint Ridge TOTAL SQ. FT. OF EXISTING & PROPOSED 1295 #

FILING 1 BLK 1 LOT 2

(1) OWNER TML Enterprises Inc

(1) ADDRESS Box 2509, Gr Jet, CO

(1) TELEPHONE 201-8022

(2) APPLICANT TML Enterprises Inc

(2) ADDRESS Box 2509, Gr Jet CO

(2) TELEPHONE 201-8022

NO. OF DWELLING UNITS:
 Before: 0 After: 1 this Construction

NO. OF BUILDINGS ON PARCEL
 Before: 0 After: 1 this Construction

USE OF EXISTING BUILDINGS Single Family

DESCRIPTION OF WORK & INTENDED USE New Single Family

TYPE OF HOME PROPOSED:
 Site Built Manufactured Home (UBC)
 Manufactured Home (HUD)
 Other (please specify) _____

REQUIRED: One plot plan, on 8 1/2" x 11" paper, showing all existing & proposed structure location(s), parking, setbacks to all property lines, ingress/egress to the property, driveway location & width & all easements & rights-of-way which abut the parcel.

THIS SECTION TO BE COMPLETED BY COMMUNITY DEVELOPMENT DEPARTMENT STAFF

ZONE RMF-8

Maximum coverage of lot by structures 70%

SETBACKS: Front 20' from property line (PL)
 or _____ from center of ROW, whichever is greater

Permanent Foundation Required: YES NO

Side 5' from PL, Rear 10' from PL

Parking Req'mt 2

Maximum Height 35'

Special Conditions _____

CENSUS 8 TRAFFIC 56 ANNEX# _____

Modifications to this Planning Clearance must be approved, in writing, by the Community Development Department. The structure authorized by this application cannot be occupied until a final inspection has been completed and a Certificate of Occupancy has been issued, if applicable, by the Building Department (Section 305, Uniform Building Code).

I hereby acknowledge that I have read this application and the information is correct; I agree to comply with any and all codes, ordinances, laws, regulations or restrictions which apply to the project. I understand that failure to comply shall result in legal action, which may include but not necessarily be limited to non-use of the building(s).

Applicant Signature [Signature]

Date 6/24/02


Department Approval [Signature]

Date 7/1/02

Additional water and/or sewer tap fee(s) are required:	YES <input checked="" type="checkbox"/>	NO <input type="checkbox"/>	W/O No. <u>15059</u>
Utility Accounting <u>CMC</u>	Date <u>7/2/02</u>		


VALID FOR SIX MONTHS FROM DATE OF ISSUANCE (Section 9-3-2C Grand Junction Zoning & Development Code)

(White: Planning) (Yellow: Customer) (Pink: Building Department) (Goldenrod: Utility Accounting)

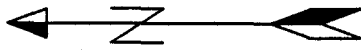

BROKEN ARROW

(A)

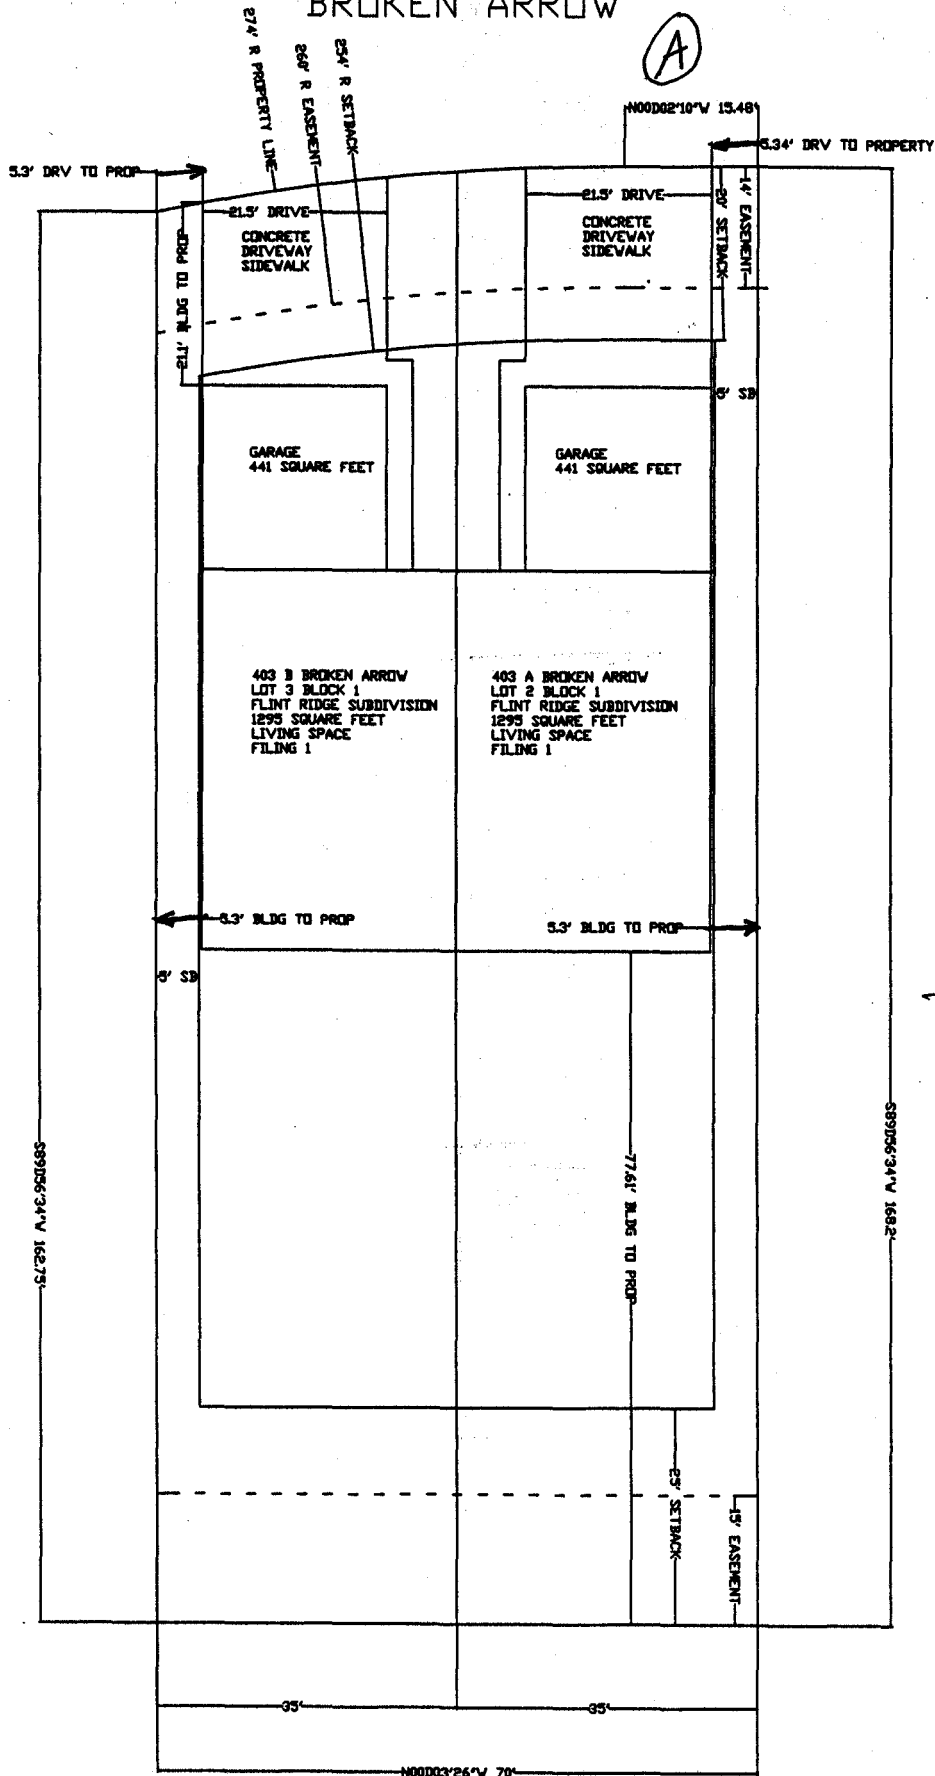

7-2-02
 ACCEPTED *Daylan Anderson*
 ANY CHANGE OF SETBACKS MUST BE
 APPROVED BY THE CITY PLANNING
 DEPARTMENT. IT IS THE APPLICANT'S
 RESPONSIBILITY TO PROPERLY
 LOCATE AND IDENTIFY EASEMENTS
 AND PROPERTY LINES.

DRIVE OK
 DRP
 7/1/02