

FEE \$	10.00
TCP \$	500.00
SIF \$	292.00

**PLANNING CLEARANCE**  
 (Single Family Residential and Accessory Structures)  
**Community Development Department**

BLDG PERMIT NO. 85757



Your Bridge to a Better Community

BLDG ADDRESS 407 A Broken Arrow SQ. FT. OF PROPOSED BLDGS/ADDITION 1294  
 TAX SCHEDULE NO. 2943-174<sup>19</sup>-006 SQ. FT. OF EXISTING BLDGS 0  
 SUBDIVISION Flint Ridge TOTAL SQ. FT. OF EXISTING & PROPOSED 1294  
 FILING 1 BLK 1 LOT 6 NO. OF DWELLING UNITS:  
 Before: 0 After: 1 this Construction  
 (1) OWNER TML Enterprises Inc NO. OF BUILDINGS ON PARCEL  
 Before: 0 After: 1 this Construction  
 (1) ADDRESS Box 2569, GA Jet CO USE OF EXISTING BUILDINGS Single Family Res.  
 (1) TELEPHONE 201-8022 DESCRIPTION OF WORK & INTENDED USE Single Family  
 (2) APPLICANT Samersabore TYPE OF HOME PROPOSED:  
 (2) ADDRESS \_\_\_\_\_  Site Built \_\_\_\_\_ Manufactured Home (UBC)  
 (2) TELEPHONE \_\_\_\_\_ \_\_\_\_\_ Manufactured Home (HUD)  
 \_\_\_\_\_ Other (please specify) \_\_\_\_\_

**REQUIRED: One plot plan, on 8 1/2" x 11" paper, showing all existing & proposed structure location(s), parking, setbacks to all property lines, ingress/egress to the property, driveway location & width & all easements & rights-of-way which abut the parcel.**

**THIS SECTION TO BE COMPLETED BY COMMUNITY DEVELOPMENT DEPARTMENT STAFF**

ZONE RMF-8 Maximum coverage of lot by structures 70%  
 SETBACKS: Front 20' from property line (PL) Permanent Foundation Required: YES  NO \_\_\_\_\_  
 or \_\_\_\_\_ from center of ROW, whichever is greater  
 Side 5' from PL, Rear 10' from PL Parking Req'mt 2  
 Maximum Height 35' Special Conditions \_\_\_\_\_  
 CENSUS 8 TRAFFIC 56 ANN# \_\_\_\_\_

Modifications to this Planning Clearance must be approved, in writing, by the Community Development Department. The structure authorized by this application cannot be occupied until a final inspection has been completed and a Certificate of Occupancy has been issued, if applicable, by the Building Department (Section 305, Uniform Building Code).

I hereby acknowledge that I have read this application and the information is correct; I agree to comply with any and all codes, ordinances, laws, regulations or restrictions which apply to the project. I understand that failure to comply shall result in legal action, which may include but not necessarily be limited to non-use of the building(s).

Applicant Signature [Signature] Date 8/7/02  
 Department Approval [Signature] Date 8/7/02

Additional water and/or sewer tap fee(s) are required:	YES <input checked="" type="checkbox"/>	NO	W/O No. <u>15788</u>
Utility Accounting	<u>[Signature]</u>	Date	<u>8/7/02</u>

VALID FOR SIX MONTHS FROM DATE OF ISSUANCE (Section 9-3-2C Grand Junction Zoning & Development Code)

(White: Planning) (Yellow: Customer) (Pink: Building Department) (Goldenrod: Utility Accounting)



407 A



BROKEN ARROW

ACCEPTED  
BY CHANGE OF SETBACKS MUST BE  
APPROVED BY THE CITY PLANNING  
DEPT. IT IS THE APPLICANT'S  
RESPONSIBILITY TO PROPERLY  
LOCATE AND IDENTIFY EASEMENTS  
AND PROPERTY LINES

*Artistic Dragon*

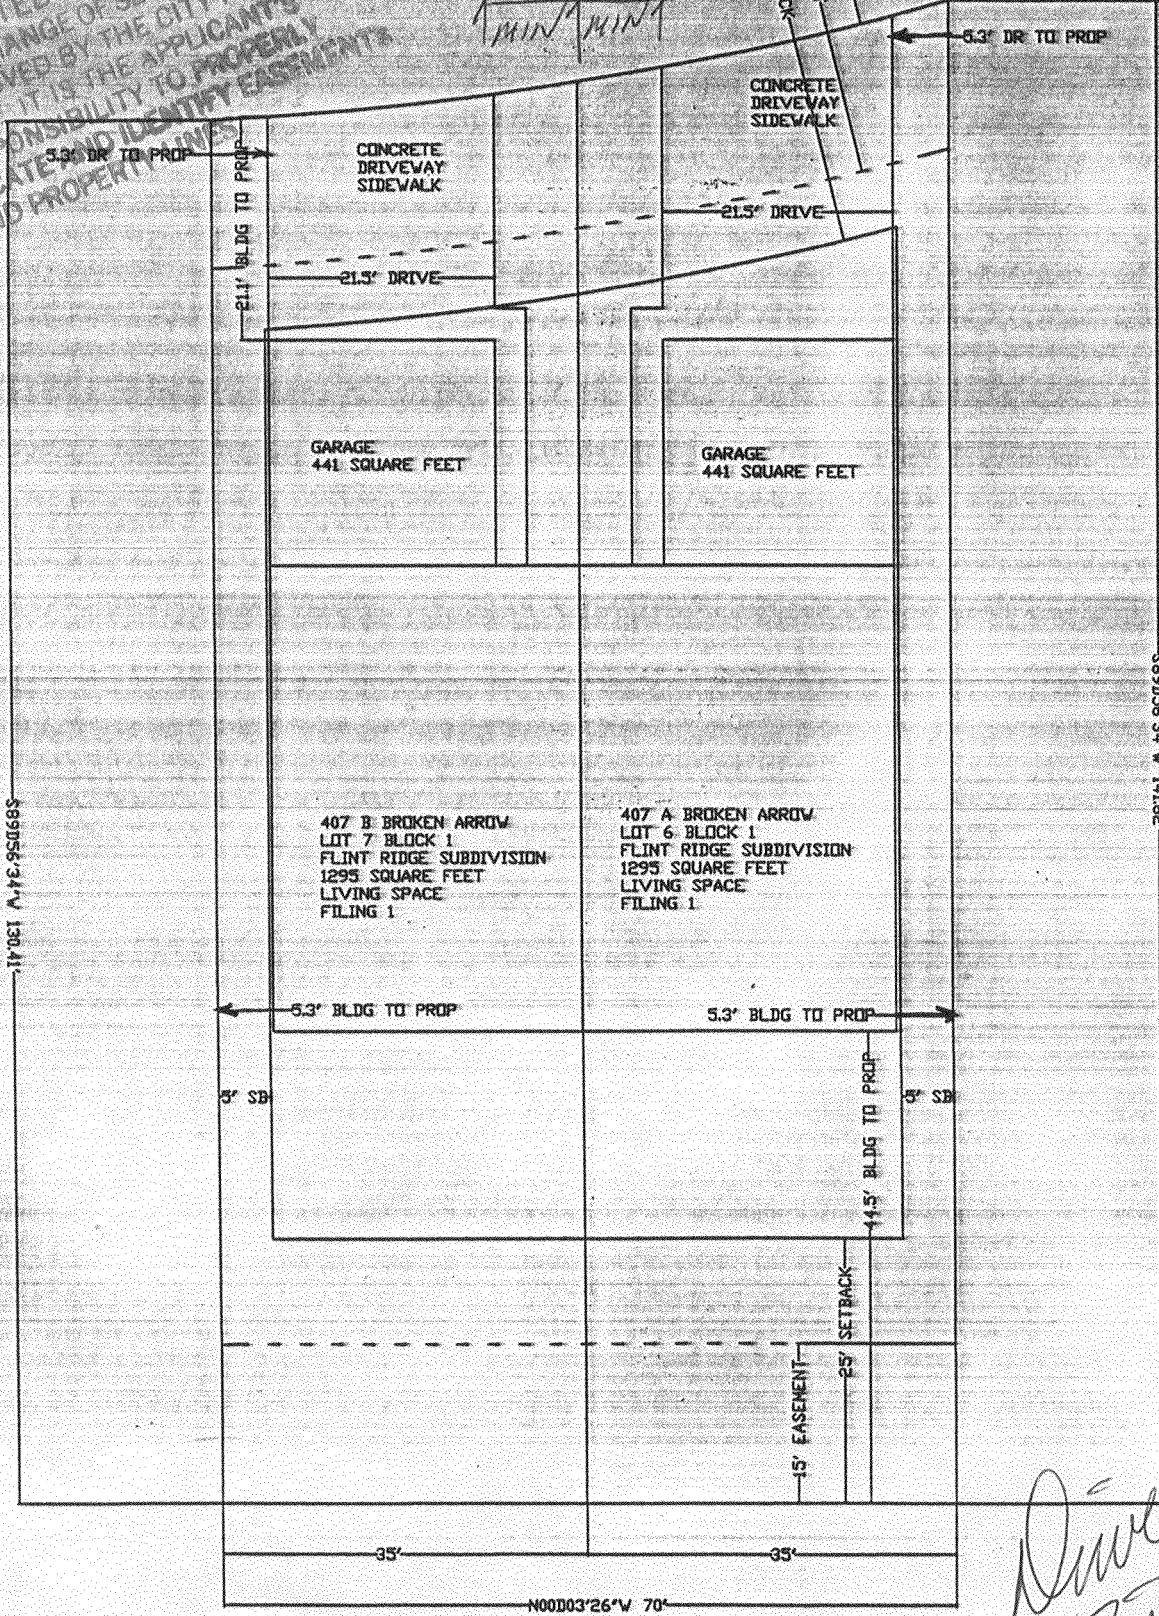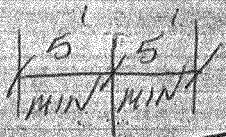

*Done OK  
Tuck Down  
8-6-02*

407 A




BROKEN ARROW

*Mike Dragon*

5' MIN 5' MIN

ACCEPTED  
ANY CHANGE OF SETBACKS MUST BE  
APPROVED BY THE CITY PLANNING  
DEPT. IT IS THE APPLICANTS  
RESPONSIBILITY TO PROPERLY  
LOCATE AND IDENTIFY EASEMENTS  
AND PROPERTY LINES

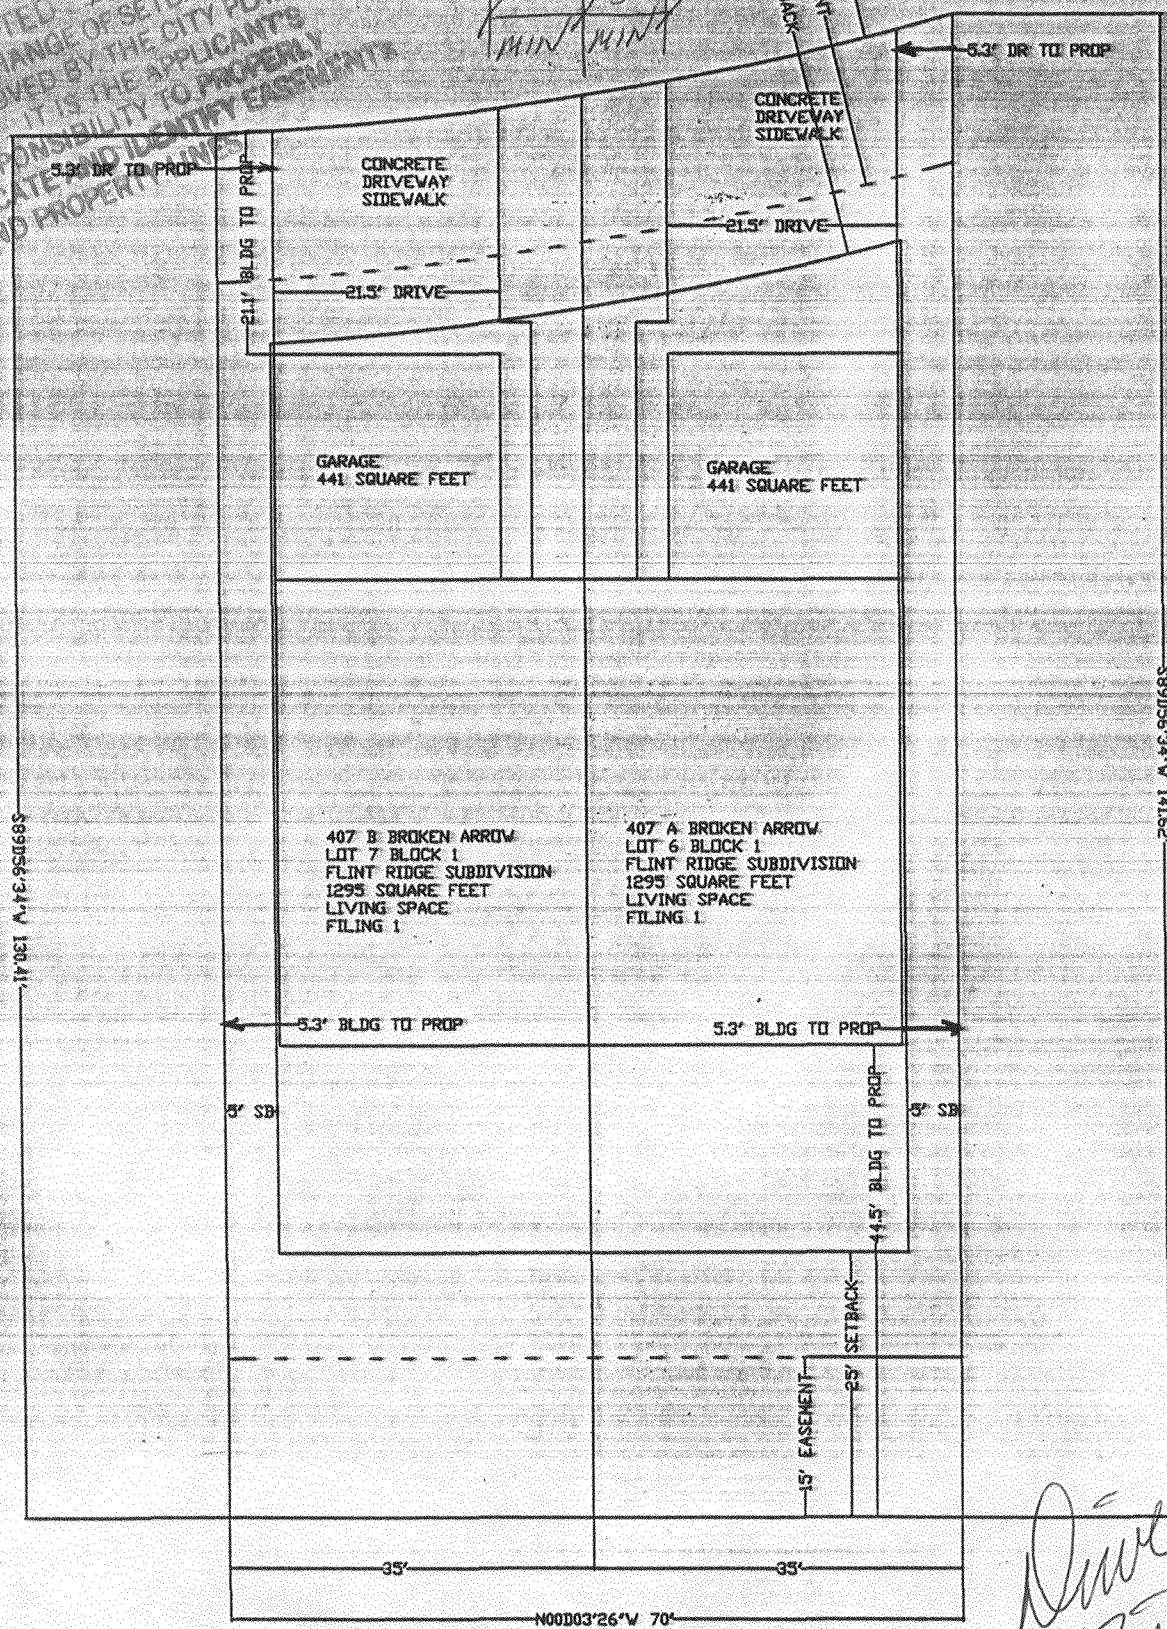

*Drive OK  
Tuck Dorris  
8-6-02*